

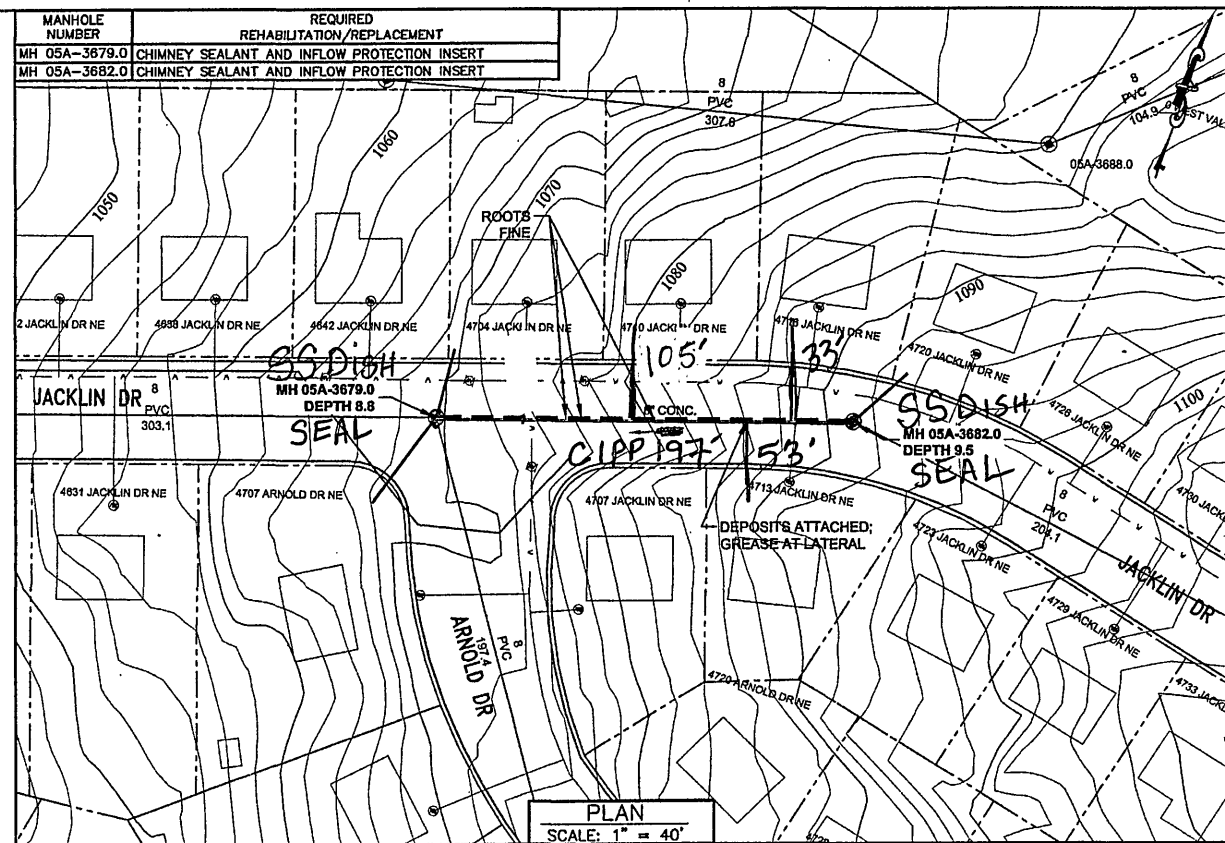


FILE NAME: S:\projects\2011\Tinker Creek Sewer Rehabilitation\Tinker Creek Sewer Rehabilitation.dwg PLOTTED DATE: 12/12/11 PLOTTED BY: JMM/asm/asm

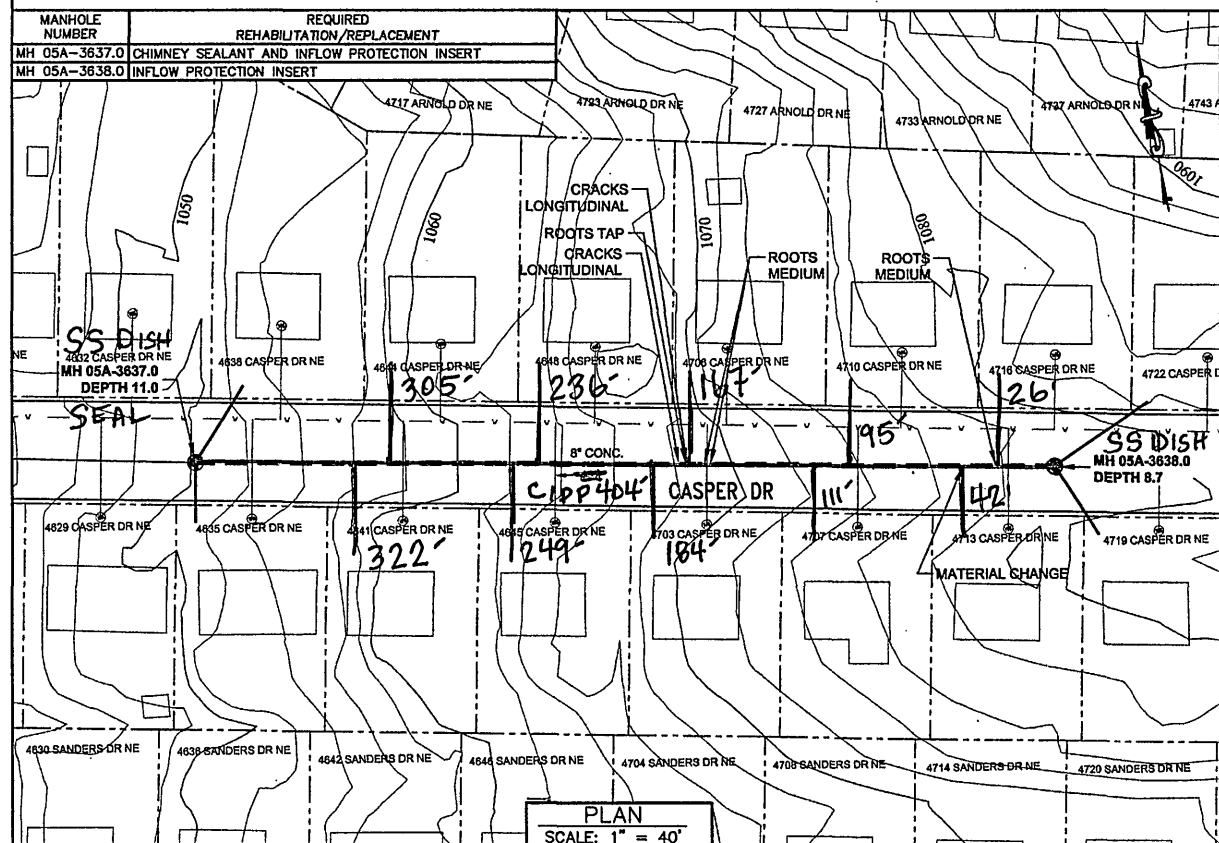

URS
5540 FALMOUTH STREET, SUITE 201
RICHMOND, VIRGINIA 23230
(804)965-9000 www.urscorp.com

WESTERN VIRGINIA
WATER AUTHORITY
As-Built
TINKER CREEK SEWER REHABILITATION
TREVINO DRIVE, JACKLIN DRIVE, AND CASPER DRIVE

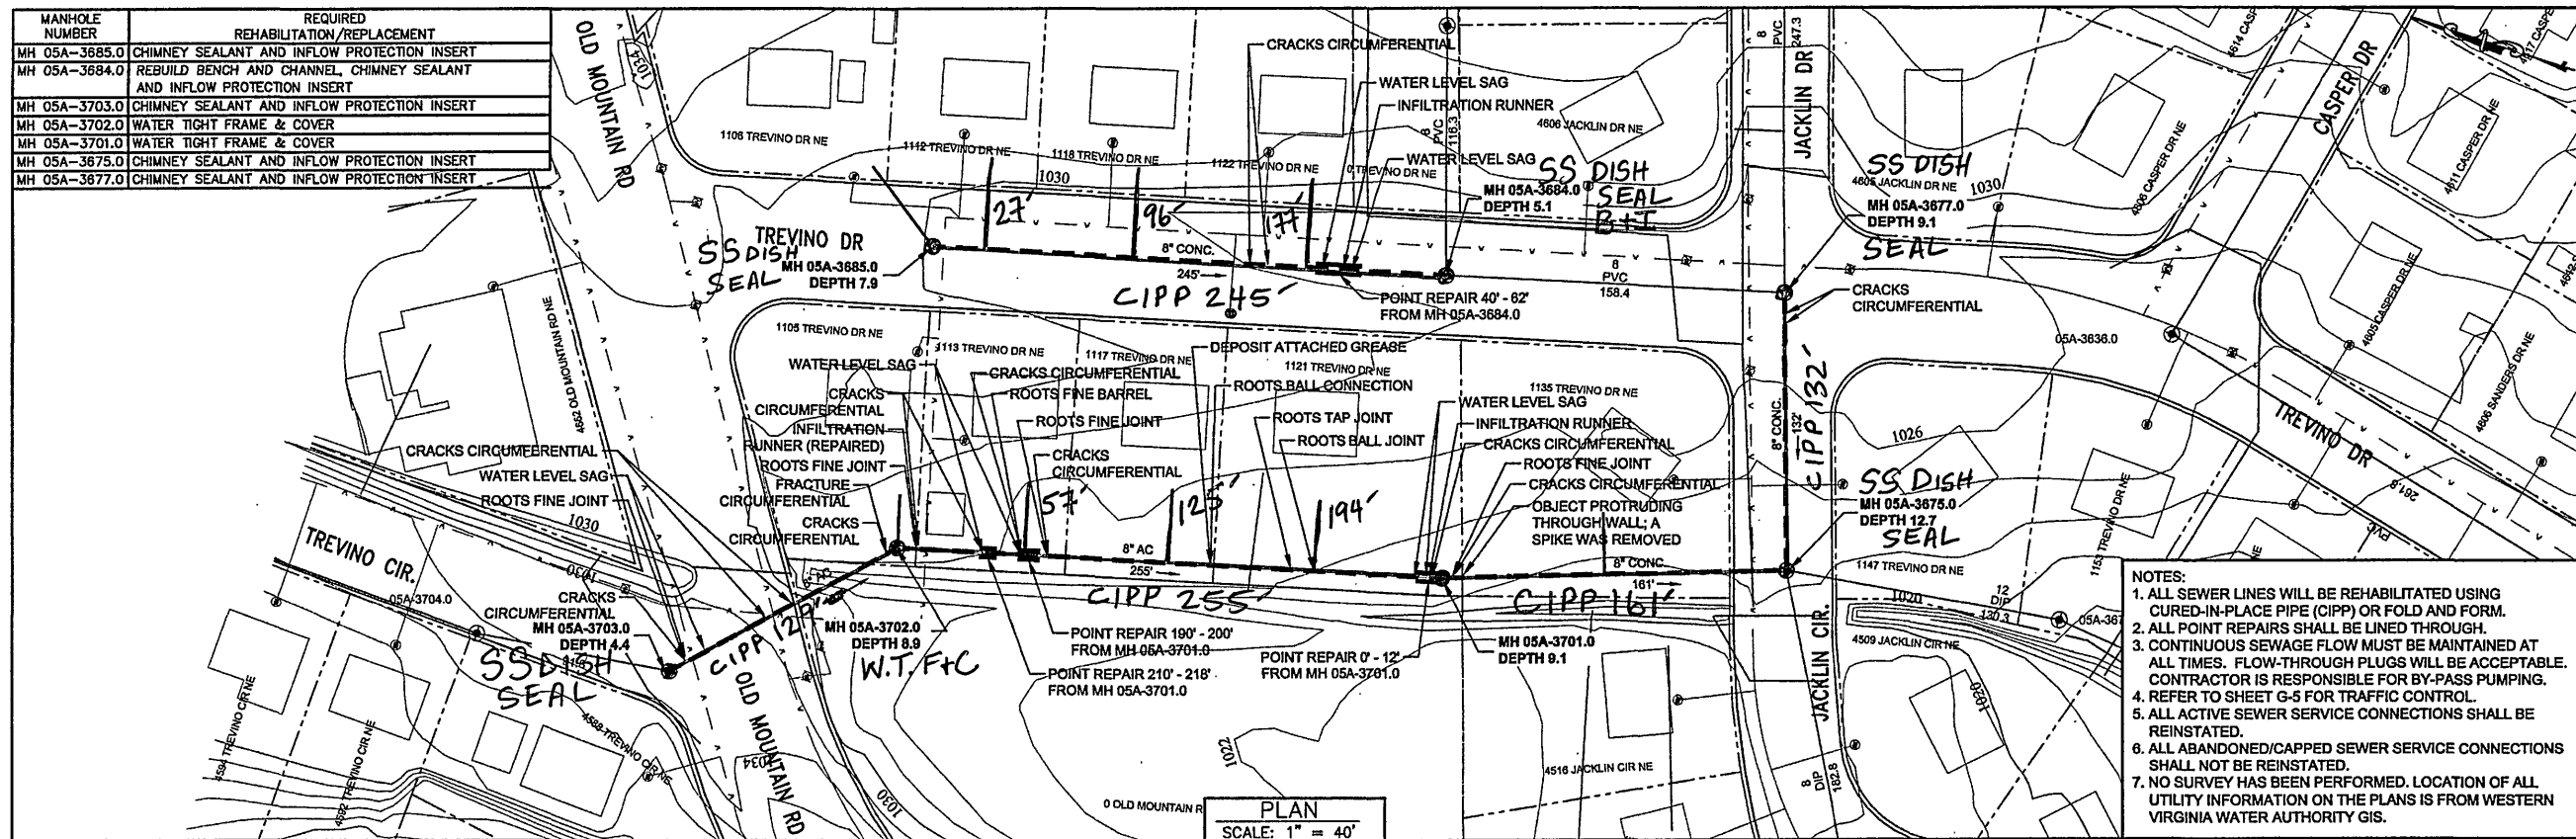

DATE: DECEMBER 2011
JOB NO.: 11658086
LEAD ENGINEER: tjd
DRAWN BY: wjl
CHECKED: tkf
REVISION: