

Great Coastal Express
3705 Tom Andrews Rd NW
Site # C96-015

Airborne Express
Tom Andrews Rd
Site # C96-039 Bond #97,000

Sewer
760'-8" PVC
2-6" laterals
3 new manholes

Contractor: Reed's Excavating Contractors
Steve Snow


Existing SSMH 101	D=4.1
SSMH 102	D=4.8
SSMH 103	D=5.4
SSMH 104	D=4.3
Air Tested main	12-2-96 & 12-3-96

Date started: 9-9-96

Date Completed: 12-2-96

City Work Order # 108572 to televis. Line
12-9-96 Televised Line

Thirlane Road

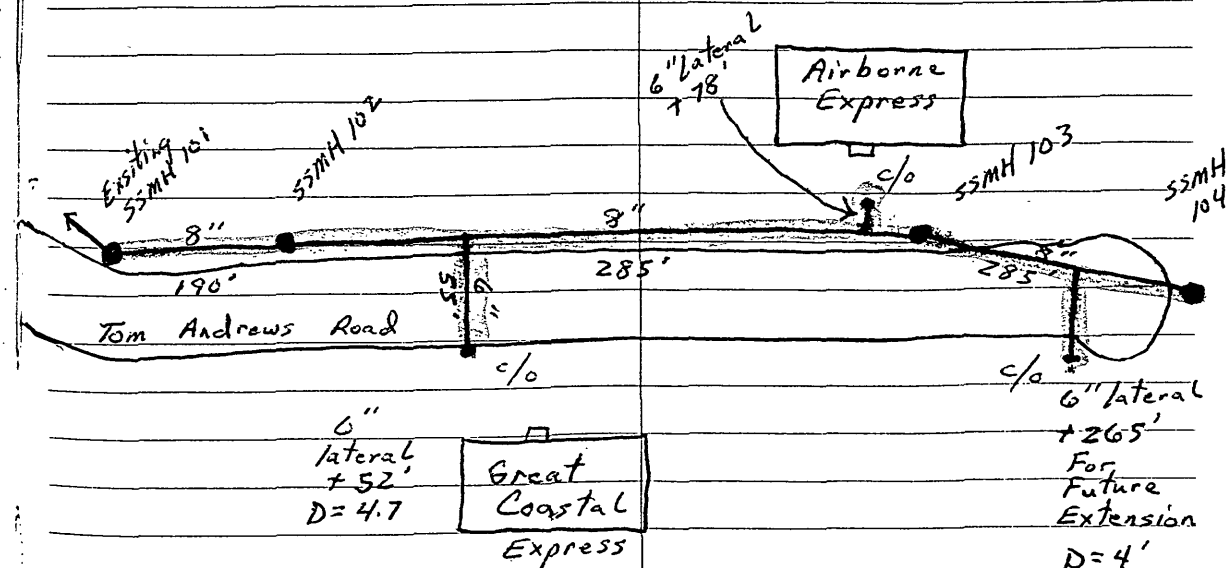

34' Between curbs
13' To R on each side
Sewer line 6' behind curb