


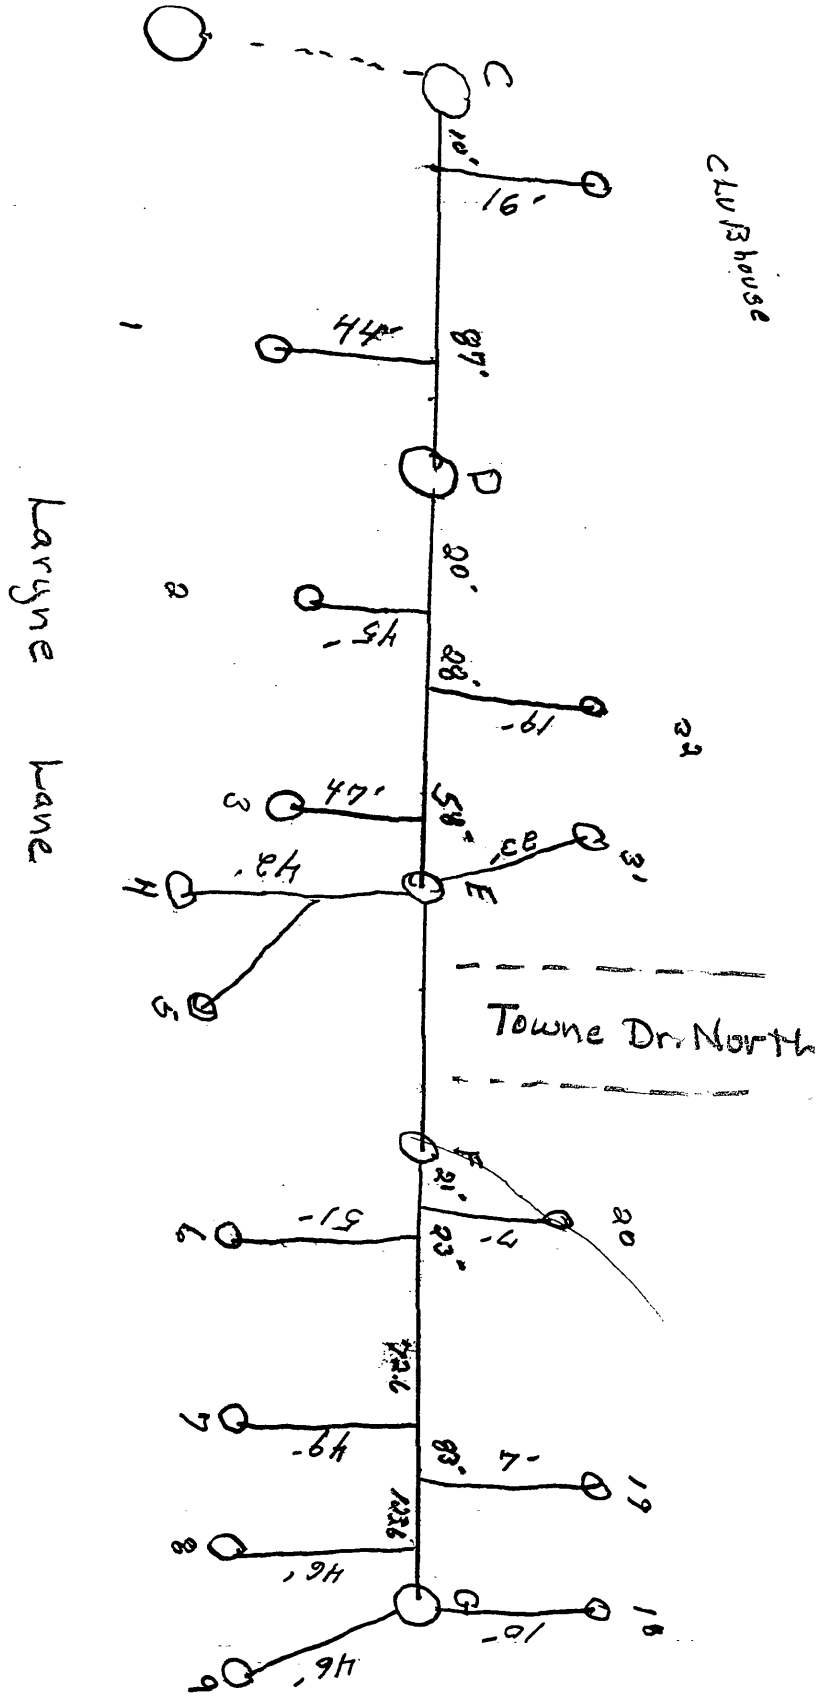

Sanitary Sewer Laterals