


Sanitary Sewer Laterals

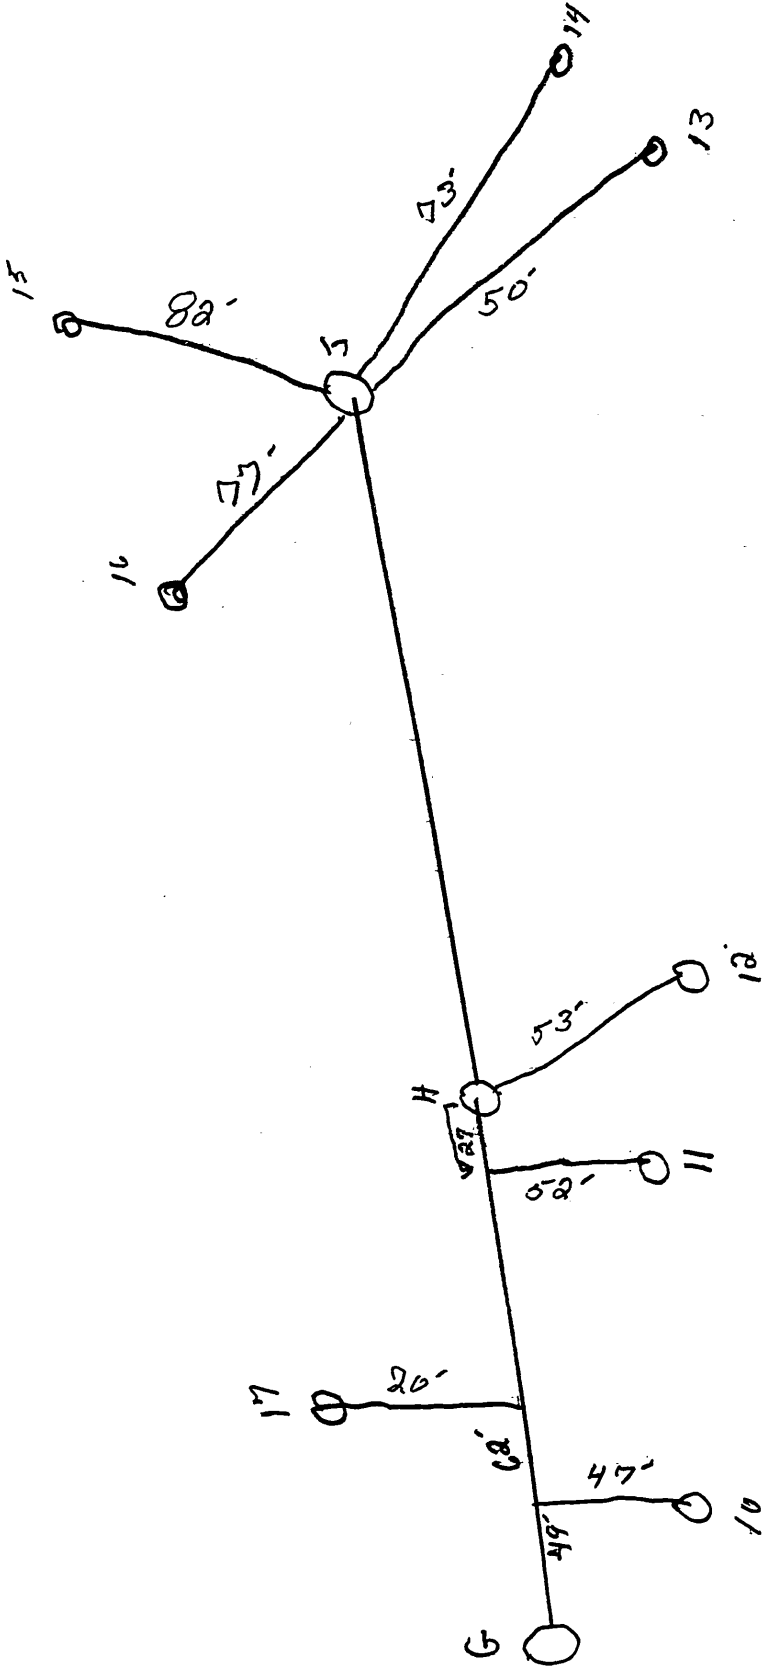

4900 Blk Laryne Lane to Cul-de-sac