


# Site Map

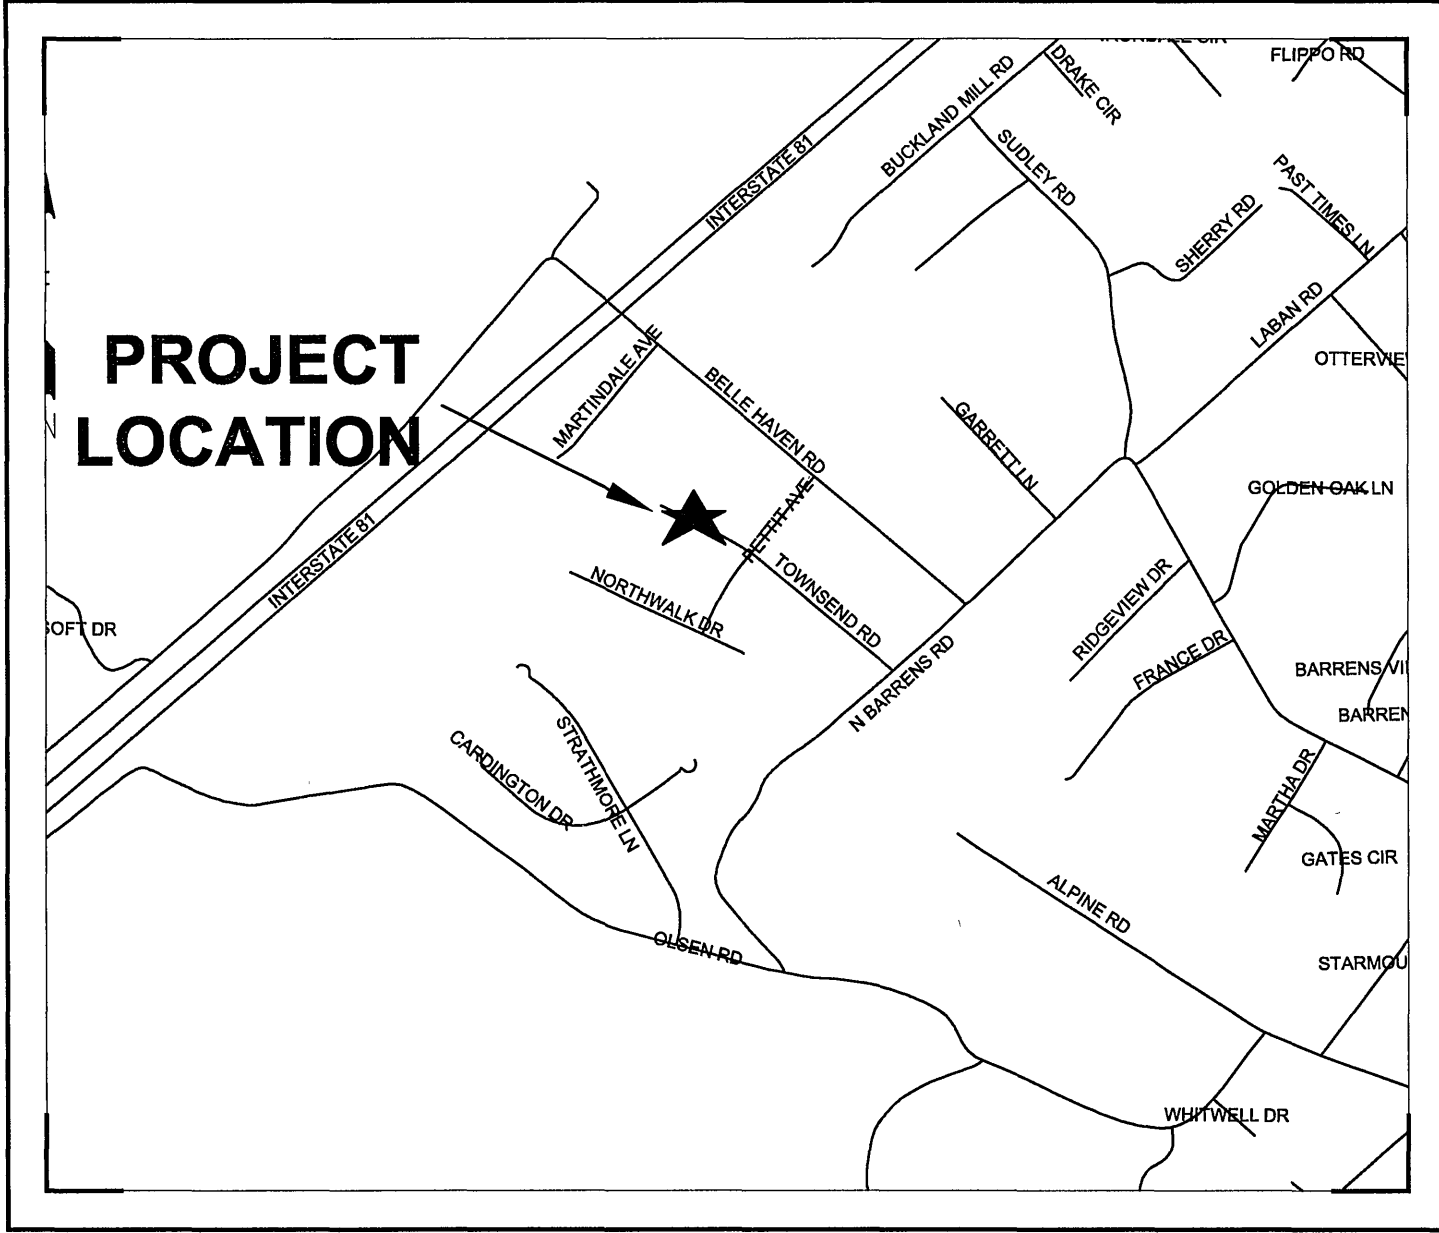


# TOWNSEND ROAD WATER LINE EXTENSION PROJECT AS-BUILT

# SHEET INDEX

SHEET 1	ROANOKE COUNTY COVER
SHEET 2	WVWA COVER
SHEET 3	PLAN AND PROFILE

## Design Engineer:

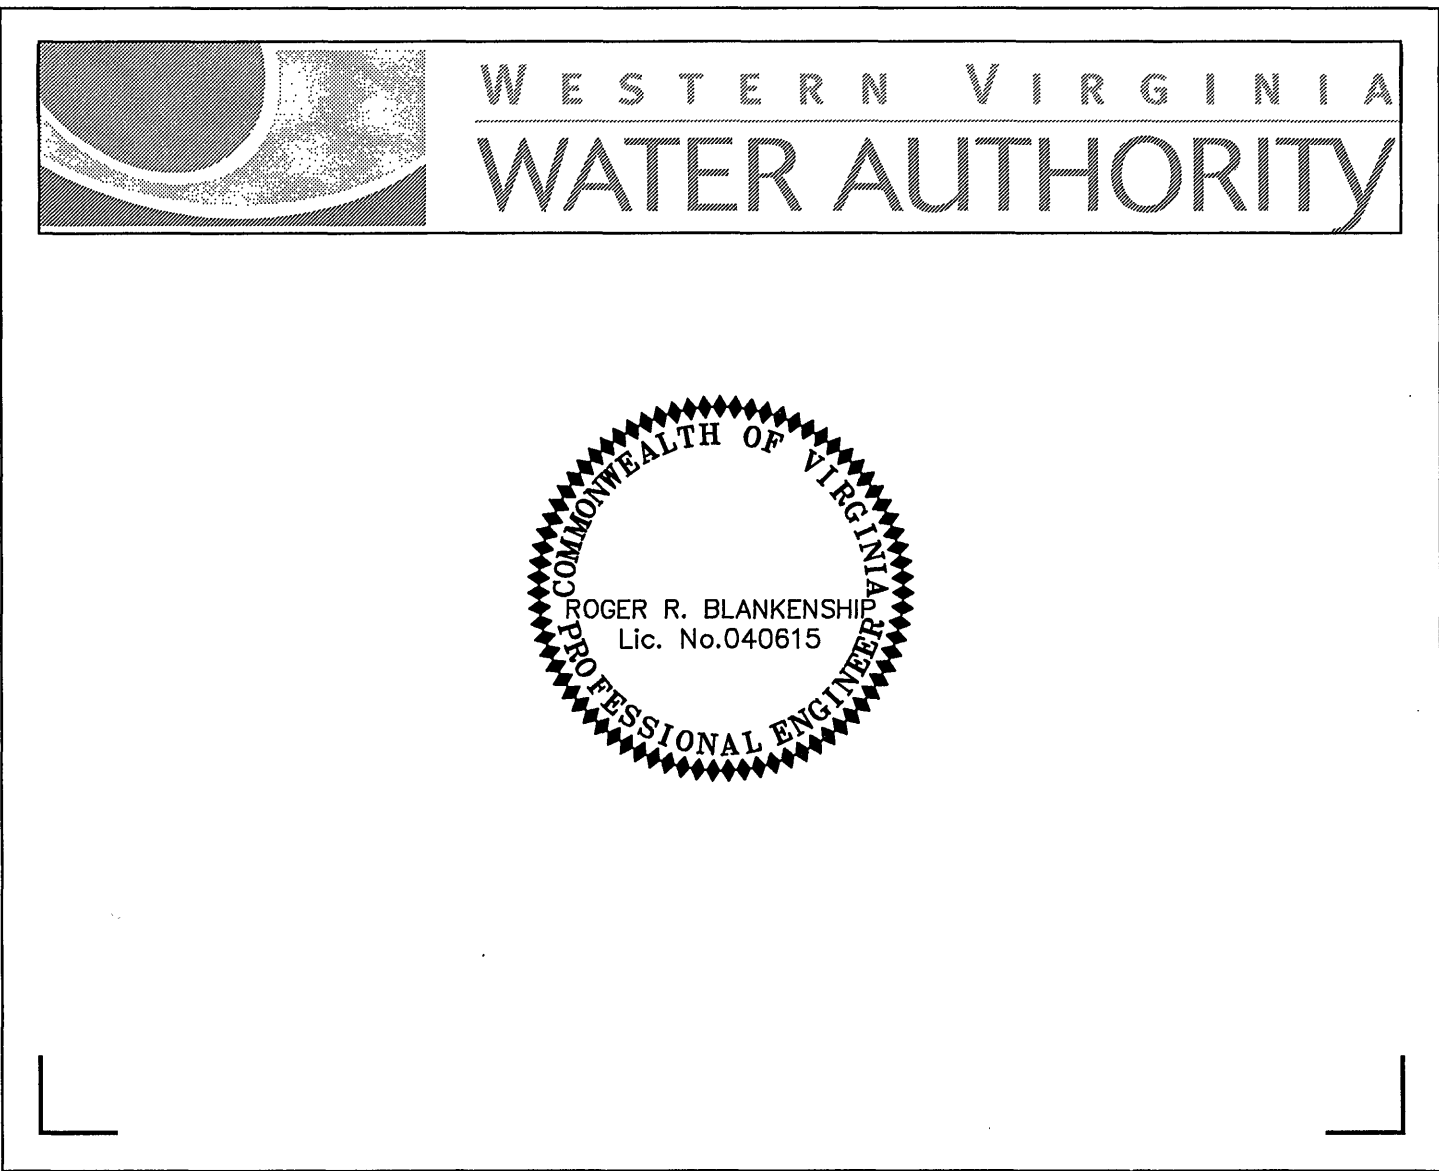


GENERAL NOTES:

1. All construction methods and materials shall conform to the latest edition of the Design and Construction Standards and Specifications of the Western Virginia Water Authority (Authority). Project shall also comply with the controlling jurisdiction's and other agency's standards (VDOT, DEQ, DCR, VDH, etc.)
2. Traffic control shall be provided in accordance with the most recent MUTCD Manual and the VDOT Work Area Protection Manual.
3. The Contractor shall notify Project Manager, Roger Blankenship (540-853-5659) at least (3) days prior to construction.
4. A pre-construction conference shall be scheduled at least one (1) week prior to construction.
5. The Contractor shall have a valid Miss Utility ticket prior to excavation. Contact Miss Utility at 1-800-552-7001.
6. All existing utilities may not be shown or may not be shown in their exact location. Contractor shall locate all utilities and determine all inverts in advance of the construction to allow for adjustments due to conflicts with other utilities. The Contractor shall comply with State Water Works Regulations, Section 12.05.03, and Sewage Collection and Treatment Regulations where lines cross.
7. An approved set of plans and permits must be available at the construction site at all times.
8. The Contractor shall provide adequate means of cleaning mud from all vehicles and equipment prior to entering public streets. It is the Contractor's responsibility to ensure that the streets are kept in a clean, mud and dust free condition at all times.
9. Field changes shall be approved by the Authority Engineering Division prior to such construction.
10. Contractor shall make provisions to provide access to all properties during construction and shall maintain safe accessibility to fire hydrants at all times.
11. The Contractor shall supply the Authority with correct as-built plans before substantial completion will be granted.

Approved for Construction:

Director of Water Operations      Date

Director of Engineering Services      Date \_\_\_\_\_

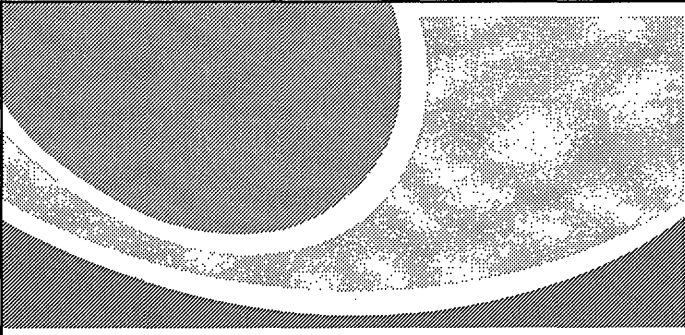

WESTERN VIRGINIA  
WATER AUTHORITY

601 S. Jefferson Street  
Suite 300  
Roanoke, VA 24011

[illegible]

Townsend Rd WL - (As-Built)