
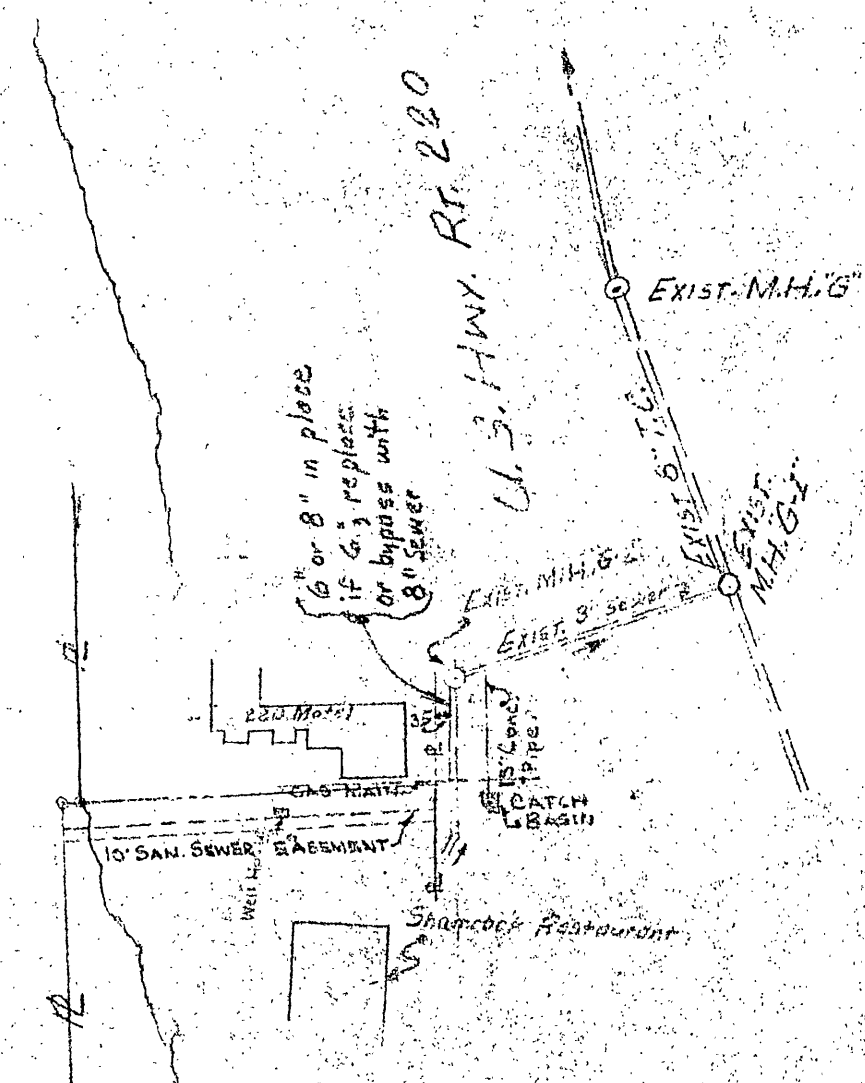


Comm. 8912
Filed 8/12


PLAN	DATE
SURVEYED	7-8-63
PLOTTED	7-10-63
NOTES CHECKED	
NO. 1000	
NO. 1000	

PROFILE	DATE
SURVEYED	7-8-63
PLOTTED	7-10-63
NOTES CHECKED	
NO. 1000	
NO. 1000	

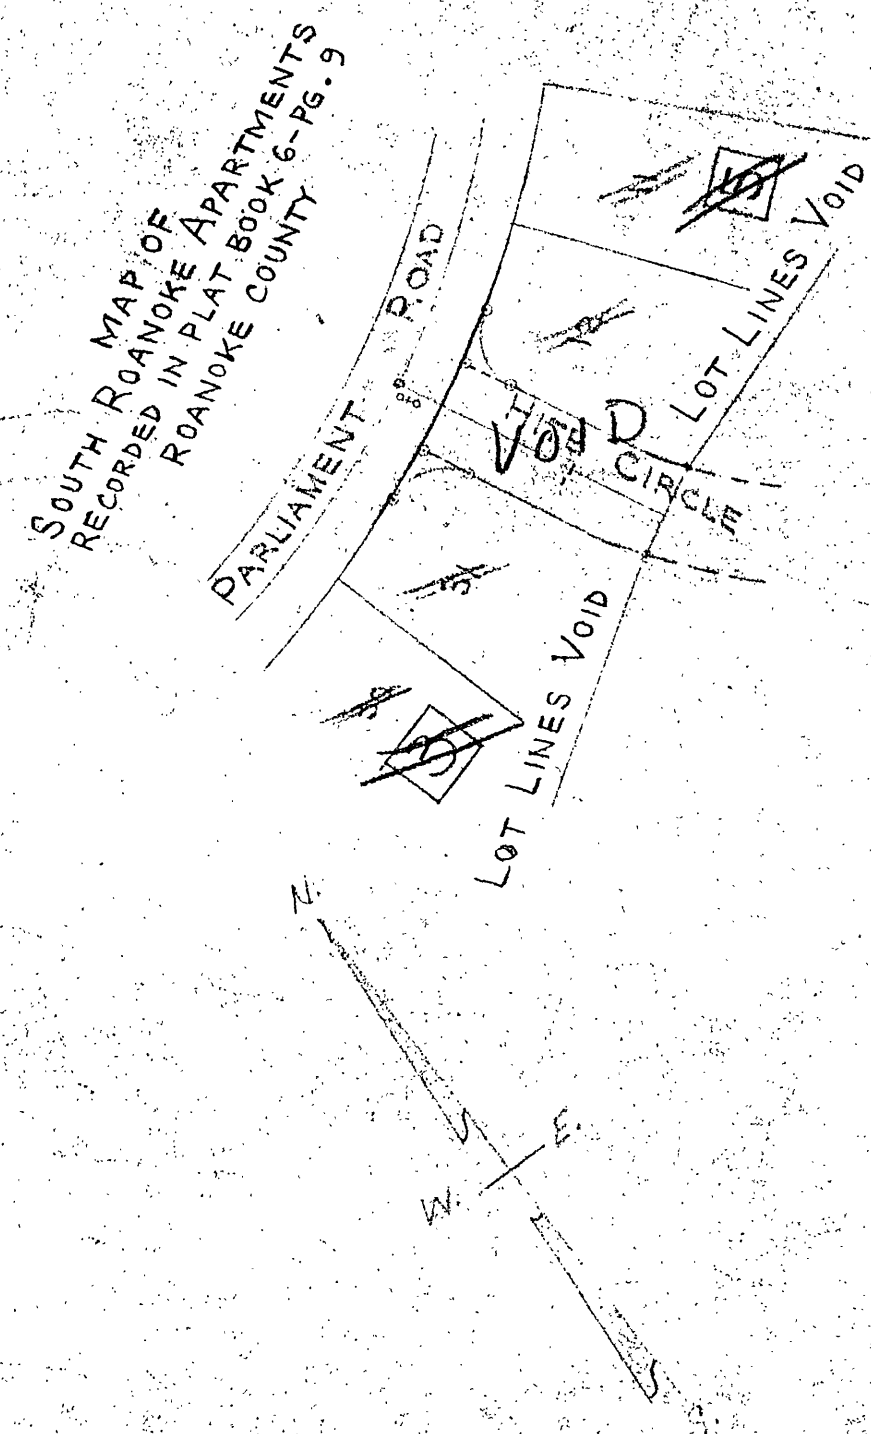


NOTE: 1-10-63
JACK ST. CLAIR, CONTR.
INFORMED R.C.W. OVER PHONE
THAT M.H. #12 WAS BUILT 25 OR
50 FT. N.E. OF LOCATION SHOWN
WITH LONGER LATERALS TO SERVE
LOTS SHOWN.

PLAN SCALE: 1"=100'

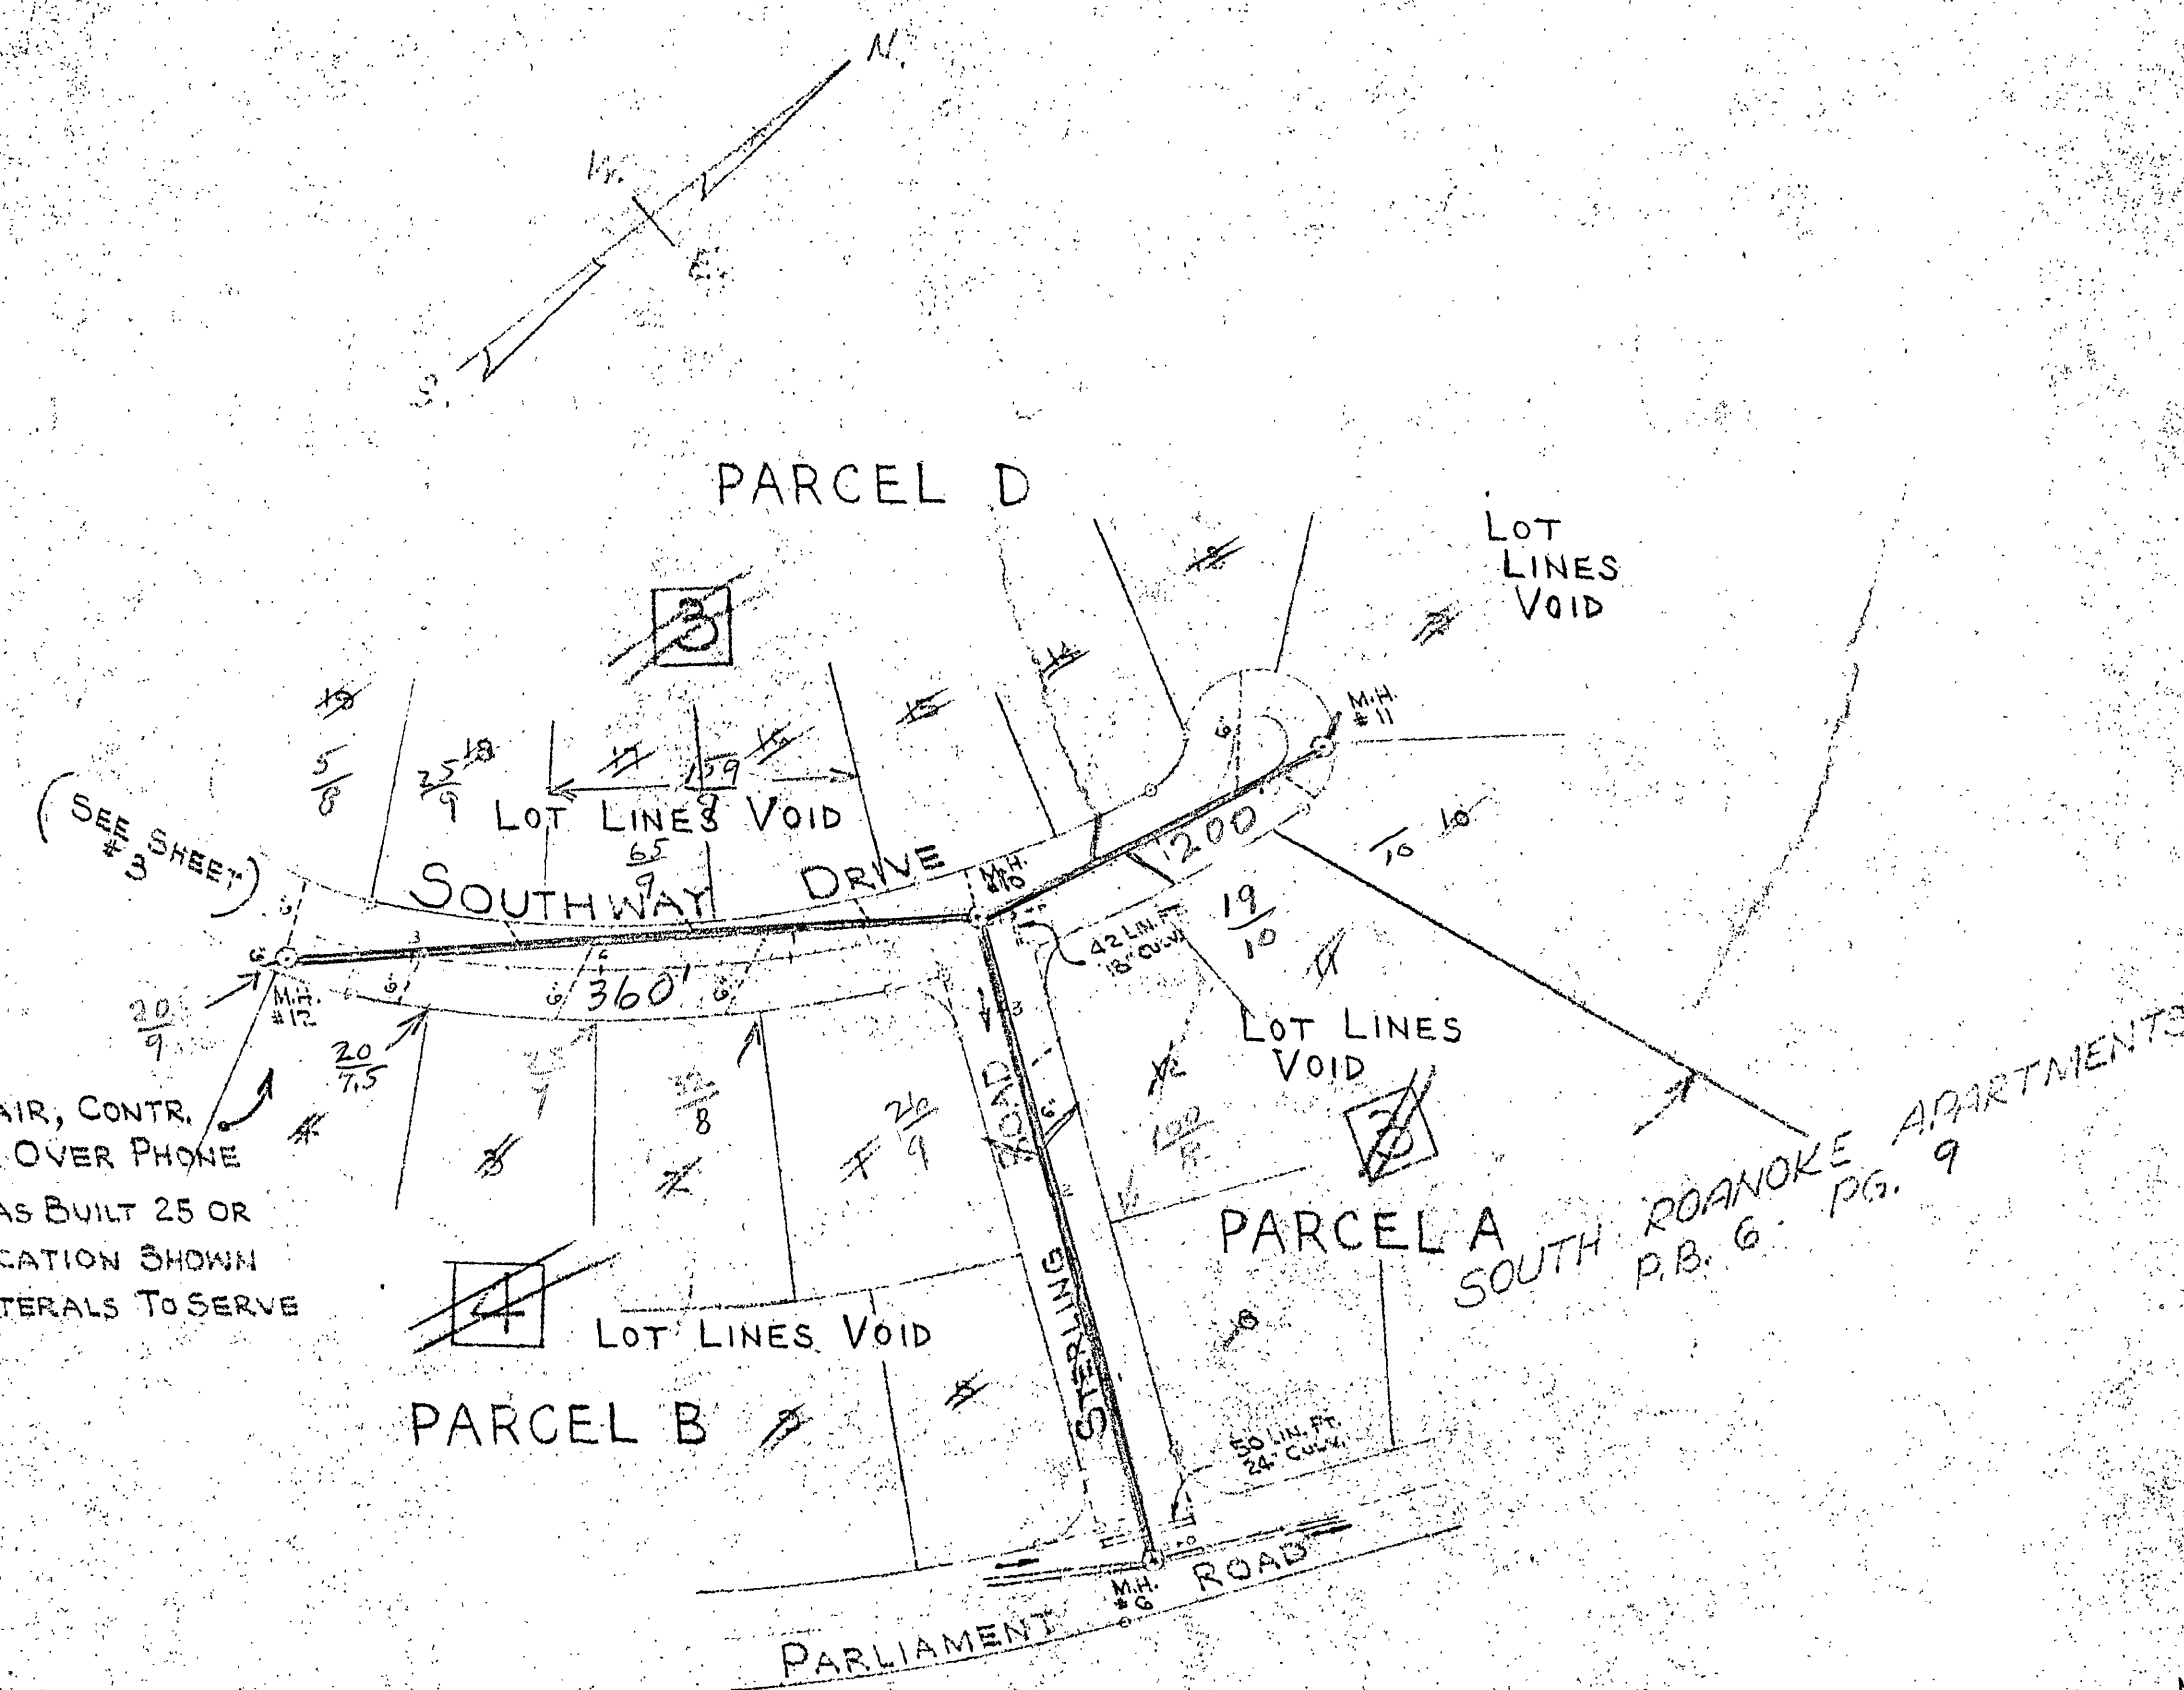

NOTE: REVISED DECEMBER 29, 1966 - LOT LINES VACATED
- MARKED VOID. PARCEL LINES IN AGREEMENT WITH
PLAT BOOK 6 - PG. 9.

L L 8

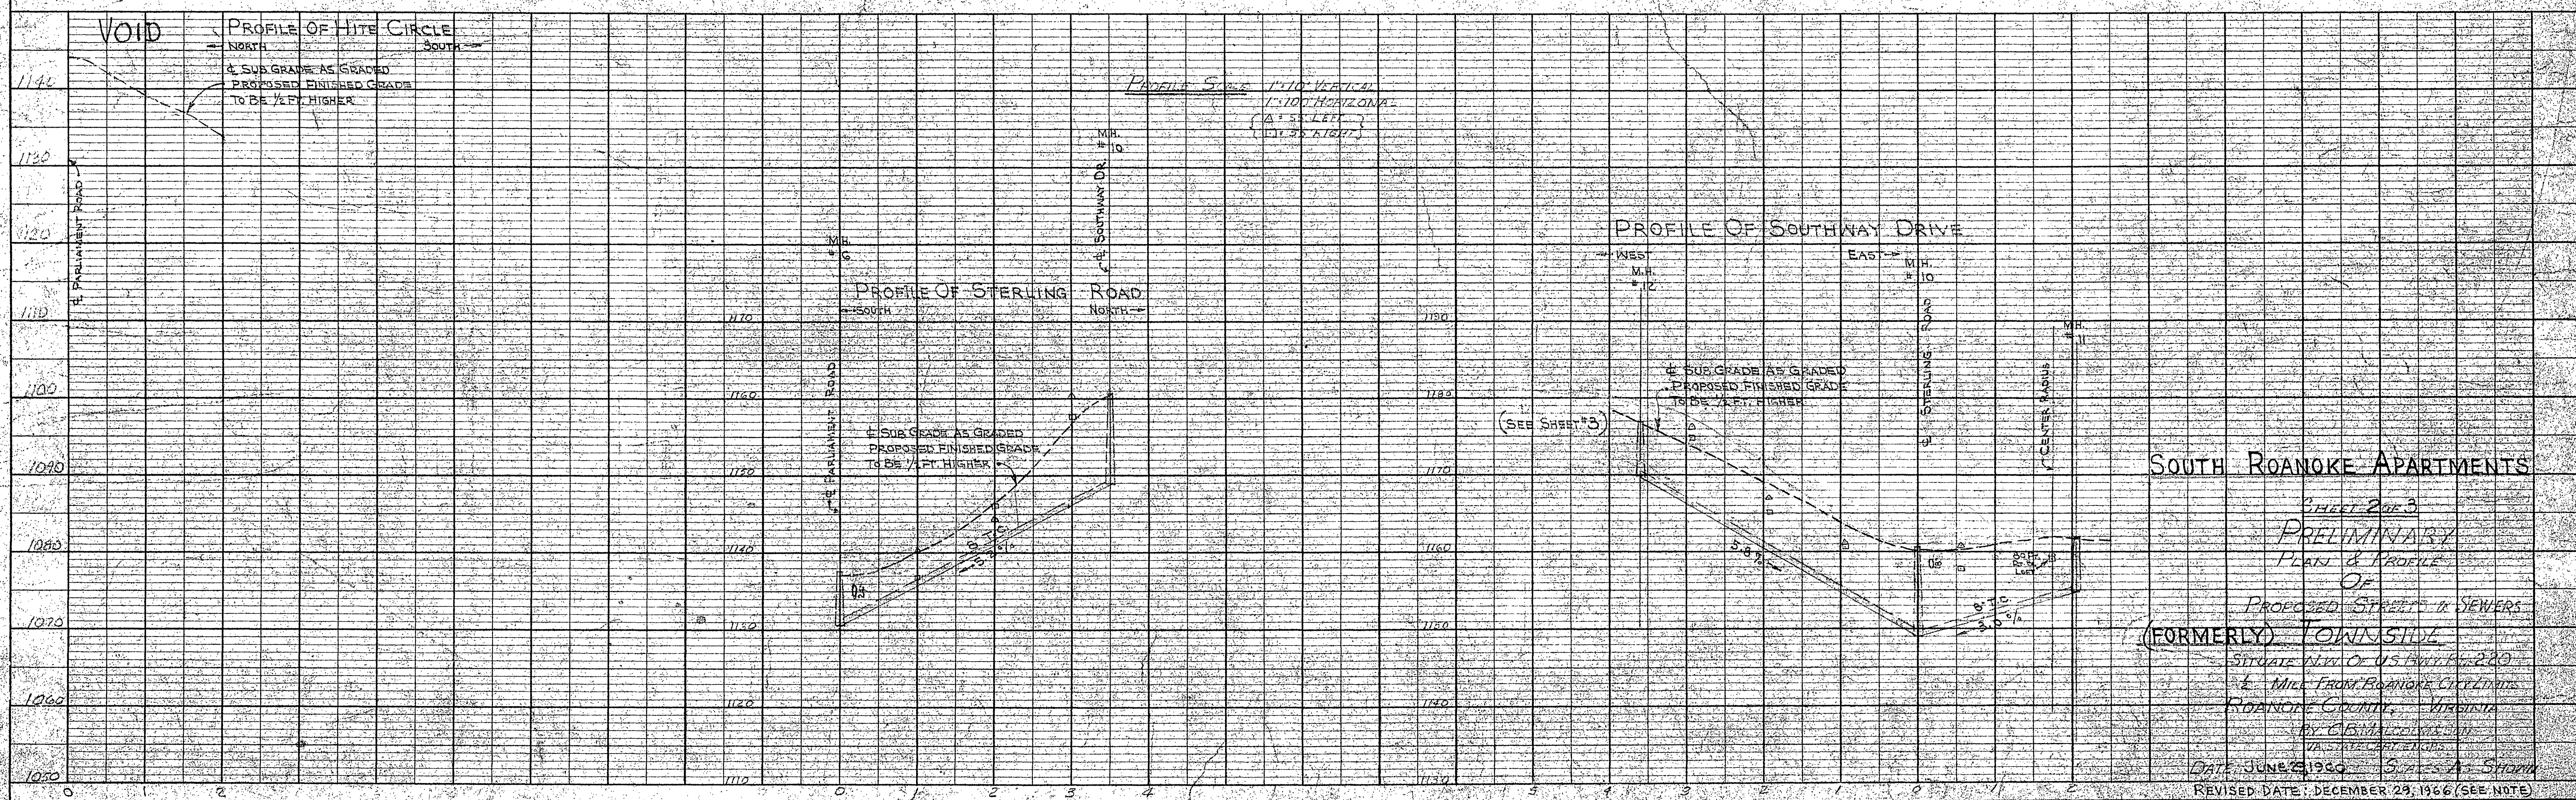

SOUTH ROANOKE APARTMENTS
SHEET 2 OF 3
PRELIMINARY
PLAN & PROFILE
OF
PROPOSED STREETS & SEWERS
(FORMERLY) TOWNSTIDE
SITUATE NW 1/4 OF US HWY. RT. 220
1 MILE FROM ROANOKE CIRCULAR
ROANOKE COUNTY, VIRGINIA
BY C.B.M. COLWELL & SONS
PLANNING ENGINEERS
DATE: JUNE 23, 1960
REVISED DATE: DECEMBER 29, 1966 (SEE NOTE)