


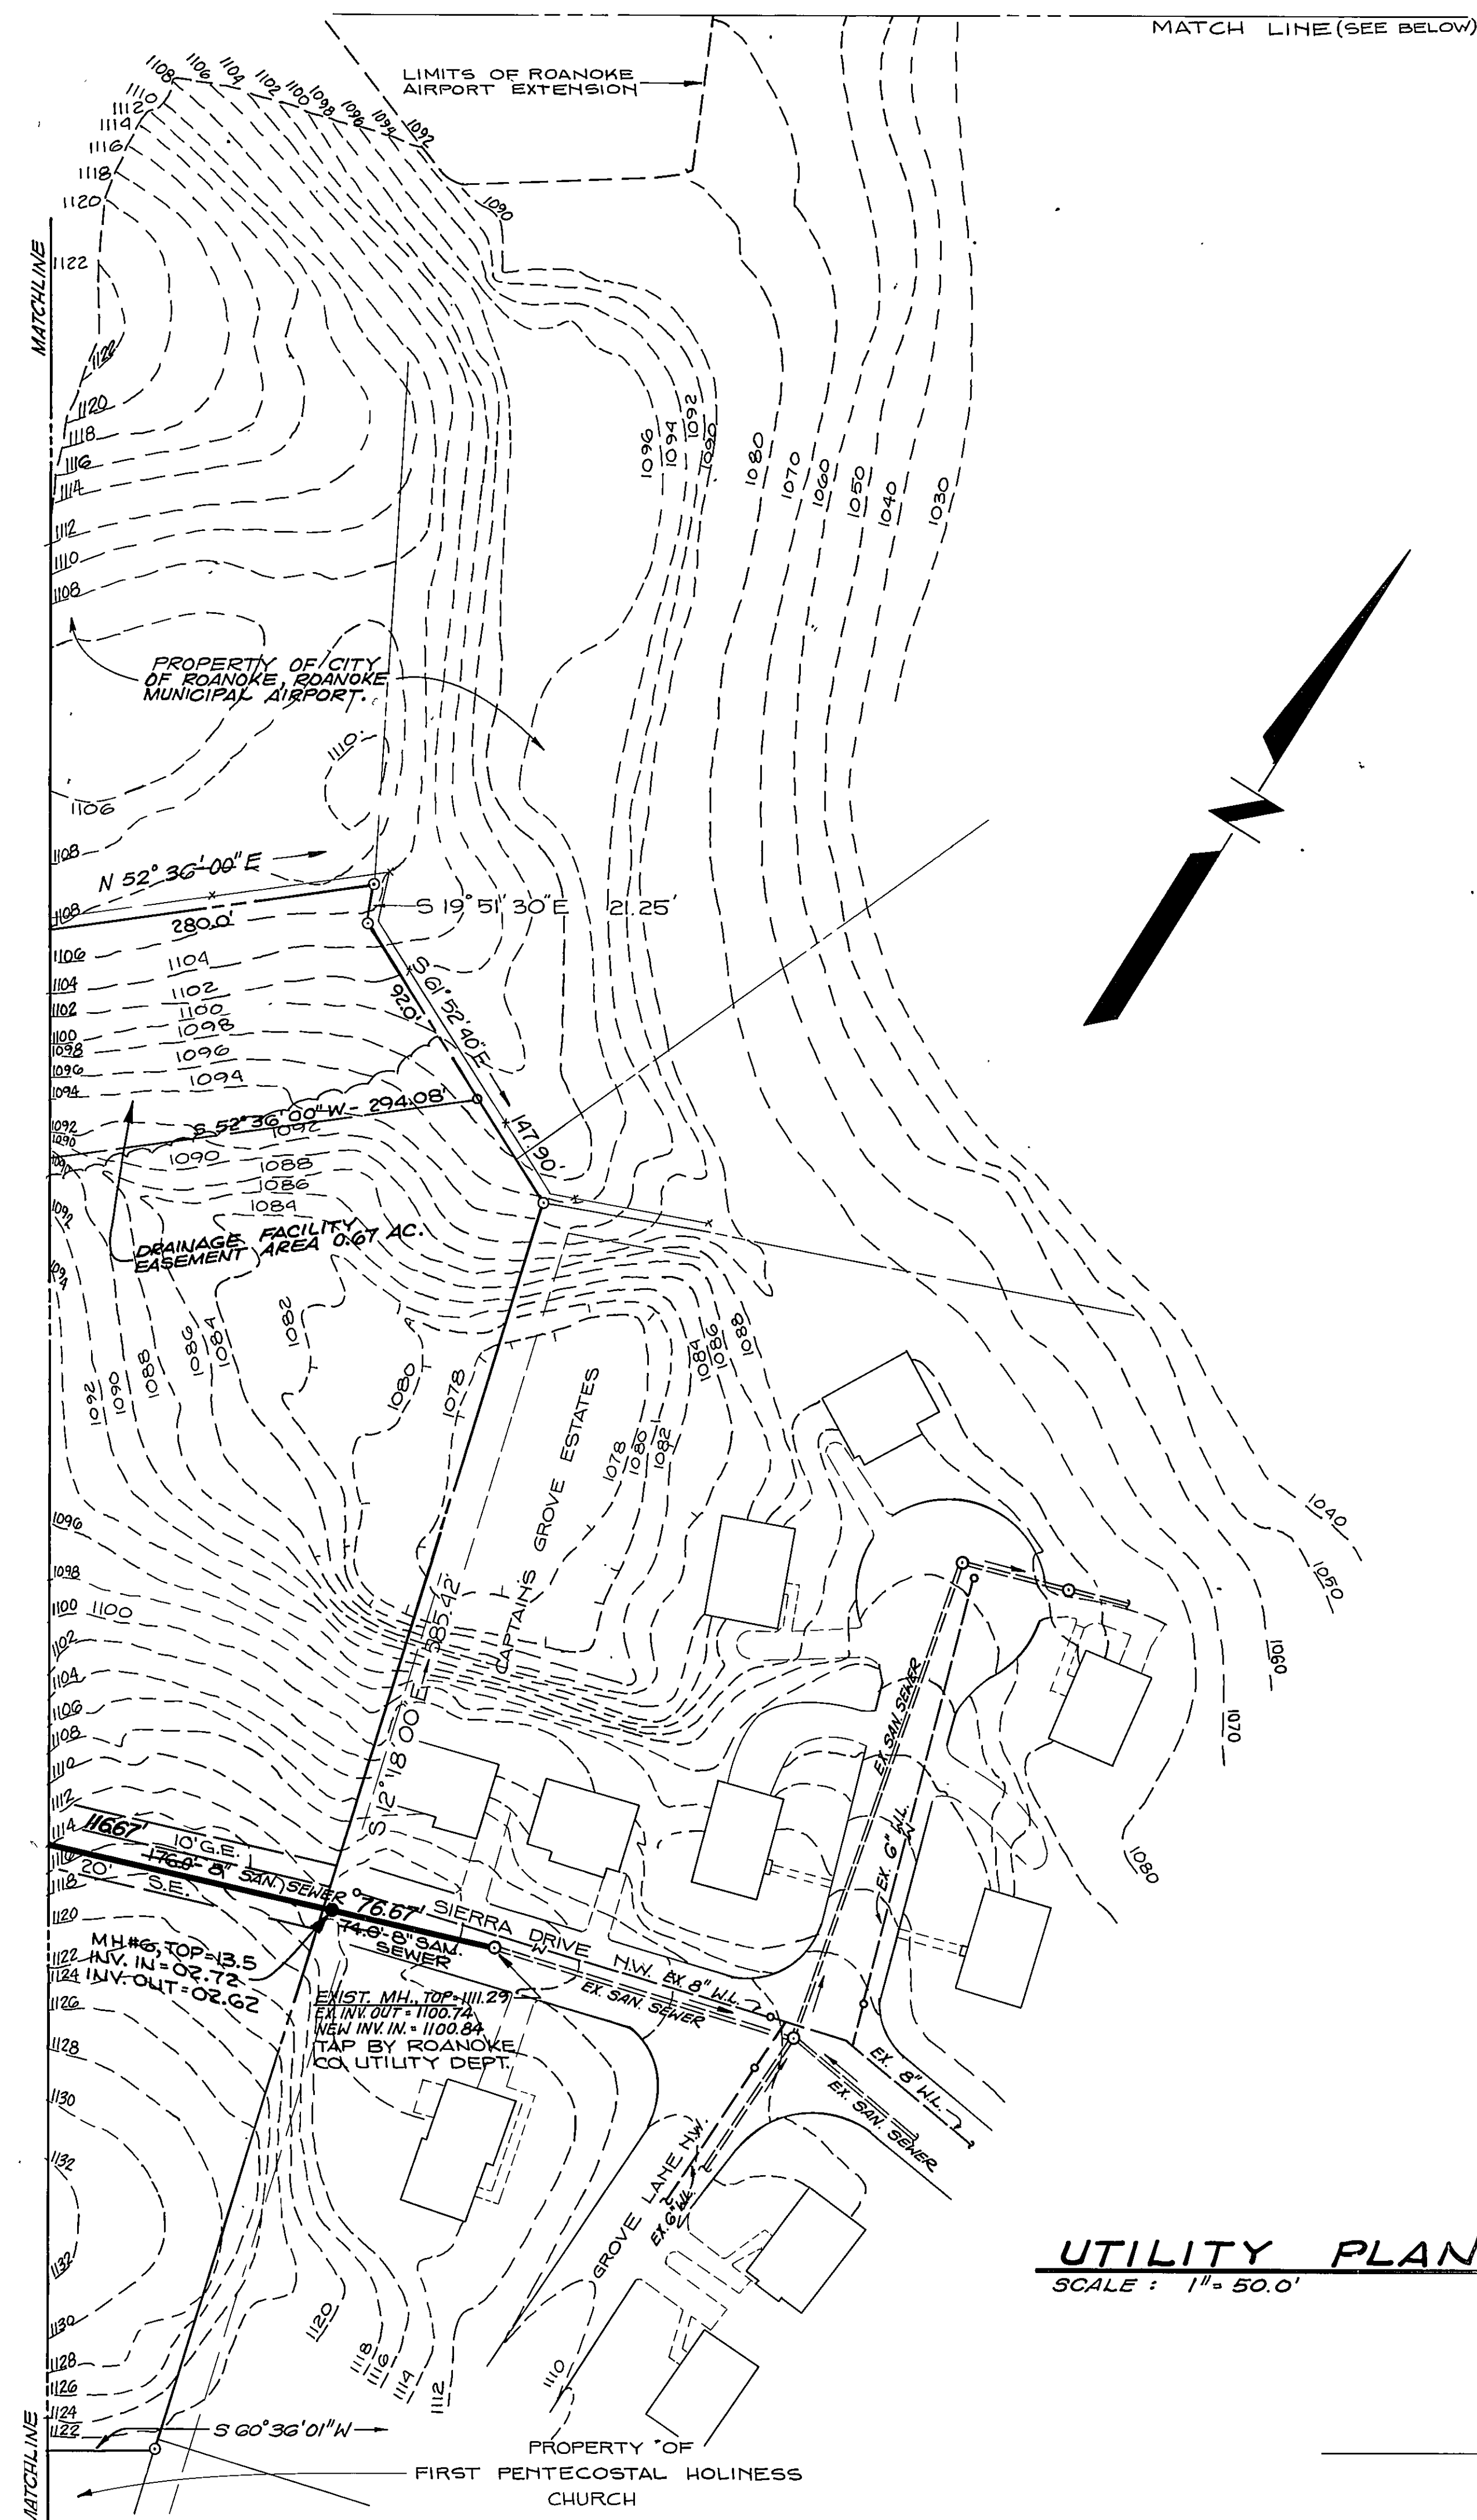

MATCH LINE (SEE BELOW)

LIMITS OF ROANOKE
AIRPORT EXTENSION

UTILITY PLAN

SCALE : 1" = 50.0'

MATCH LINE (SEE ABOVE)

AS-BUILT

A circular professional engineer seal for the Commonwealth of Virginia. The outer ring contains the text "COMMONWEALTH OF VIRGINIA" at the top and "PROFESSIONAL ENGINEER" at the bottom. The center of the seal contains the name "JOHN A. GARLAND" and the license number "10323". A handwritten signature, "John A. Garland", is written across the center of the seal.

[illegible]

ROANOKE BUSINESS CONDOMINIUMS
ROANOKE, VIRGINIA

UTILITY PLAN

SPECTRUM ENGINEERS, P.C.
CONSULTING PROFESSIONAL ENGINEERS
325 MOUNTAIN AVENUE - ROANOKE, VIRGINIA 24016 - 703-345-8020

DRAWN <i>G. E. G.</i>
CHECKED <i>J. A. G.</i>
DATE <i>6-29-87</i>
SCALE <i>AS SHOWN</i>
JOB NO. <i>87069</i>
SHEET

C-6

OF THIRTEEN SHEETS

6054