

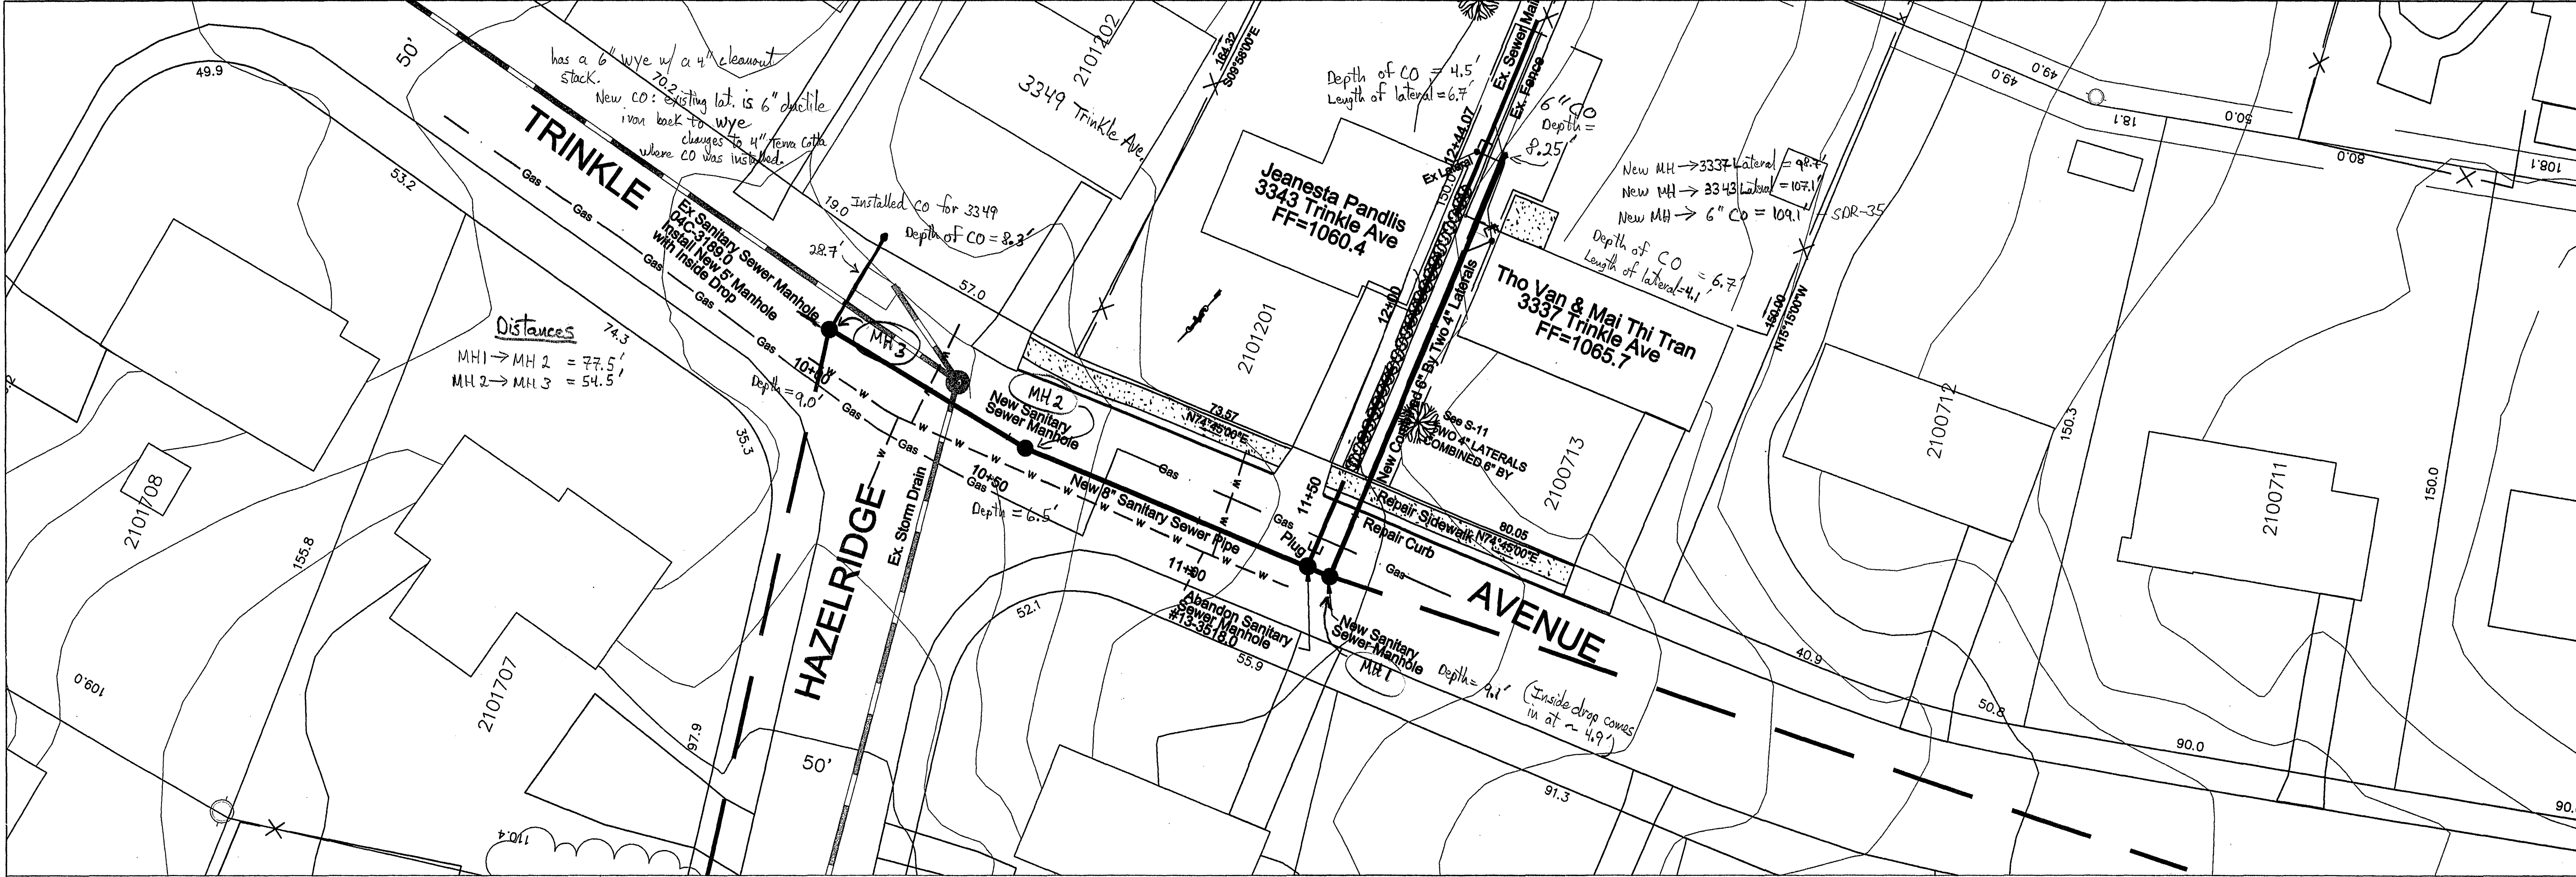


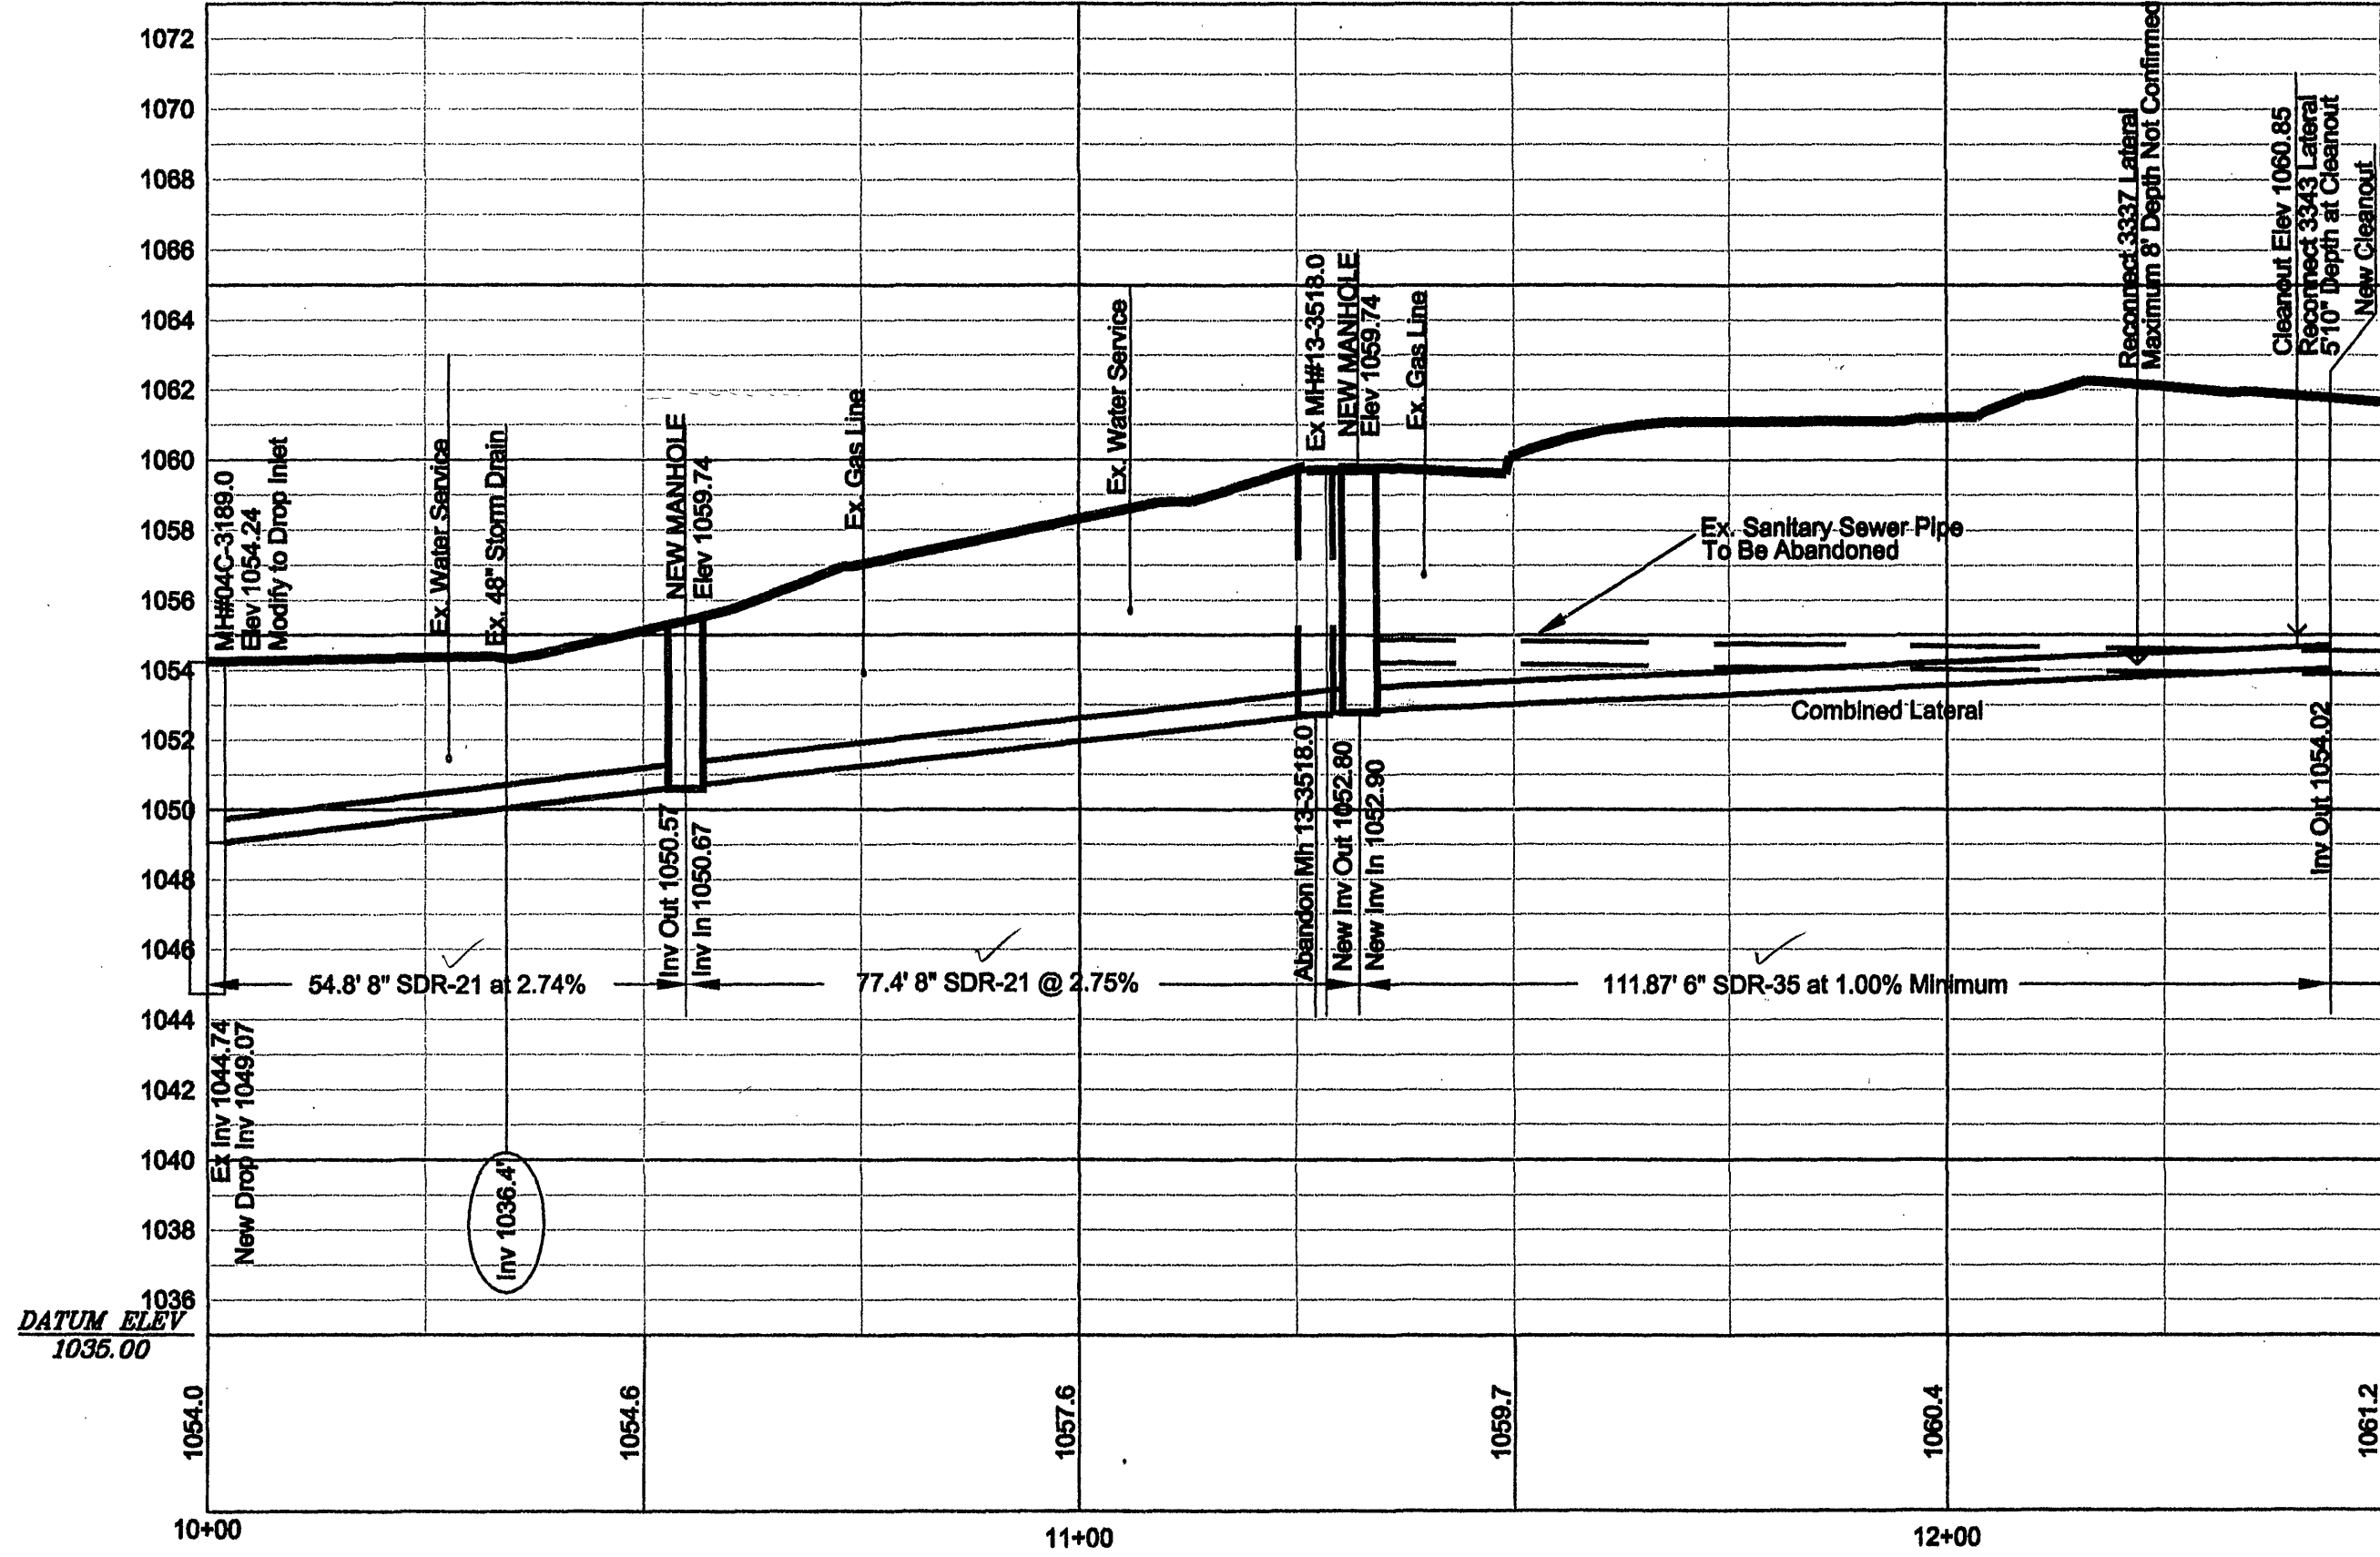

- Notes:
1. Laterals:
3337 Trinkle - appears to be 4" cast iron
3330 Troy - PVC 6" off main; possible 4" cast iron to home
3338 Troy - unknown
 2. All lateral elevations are to be confirmed prior to excavation
 3. New laterals shall have a minimum grade of 1%

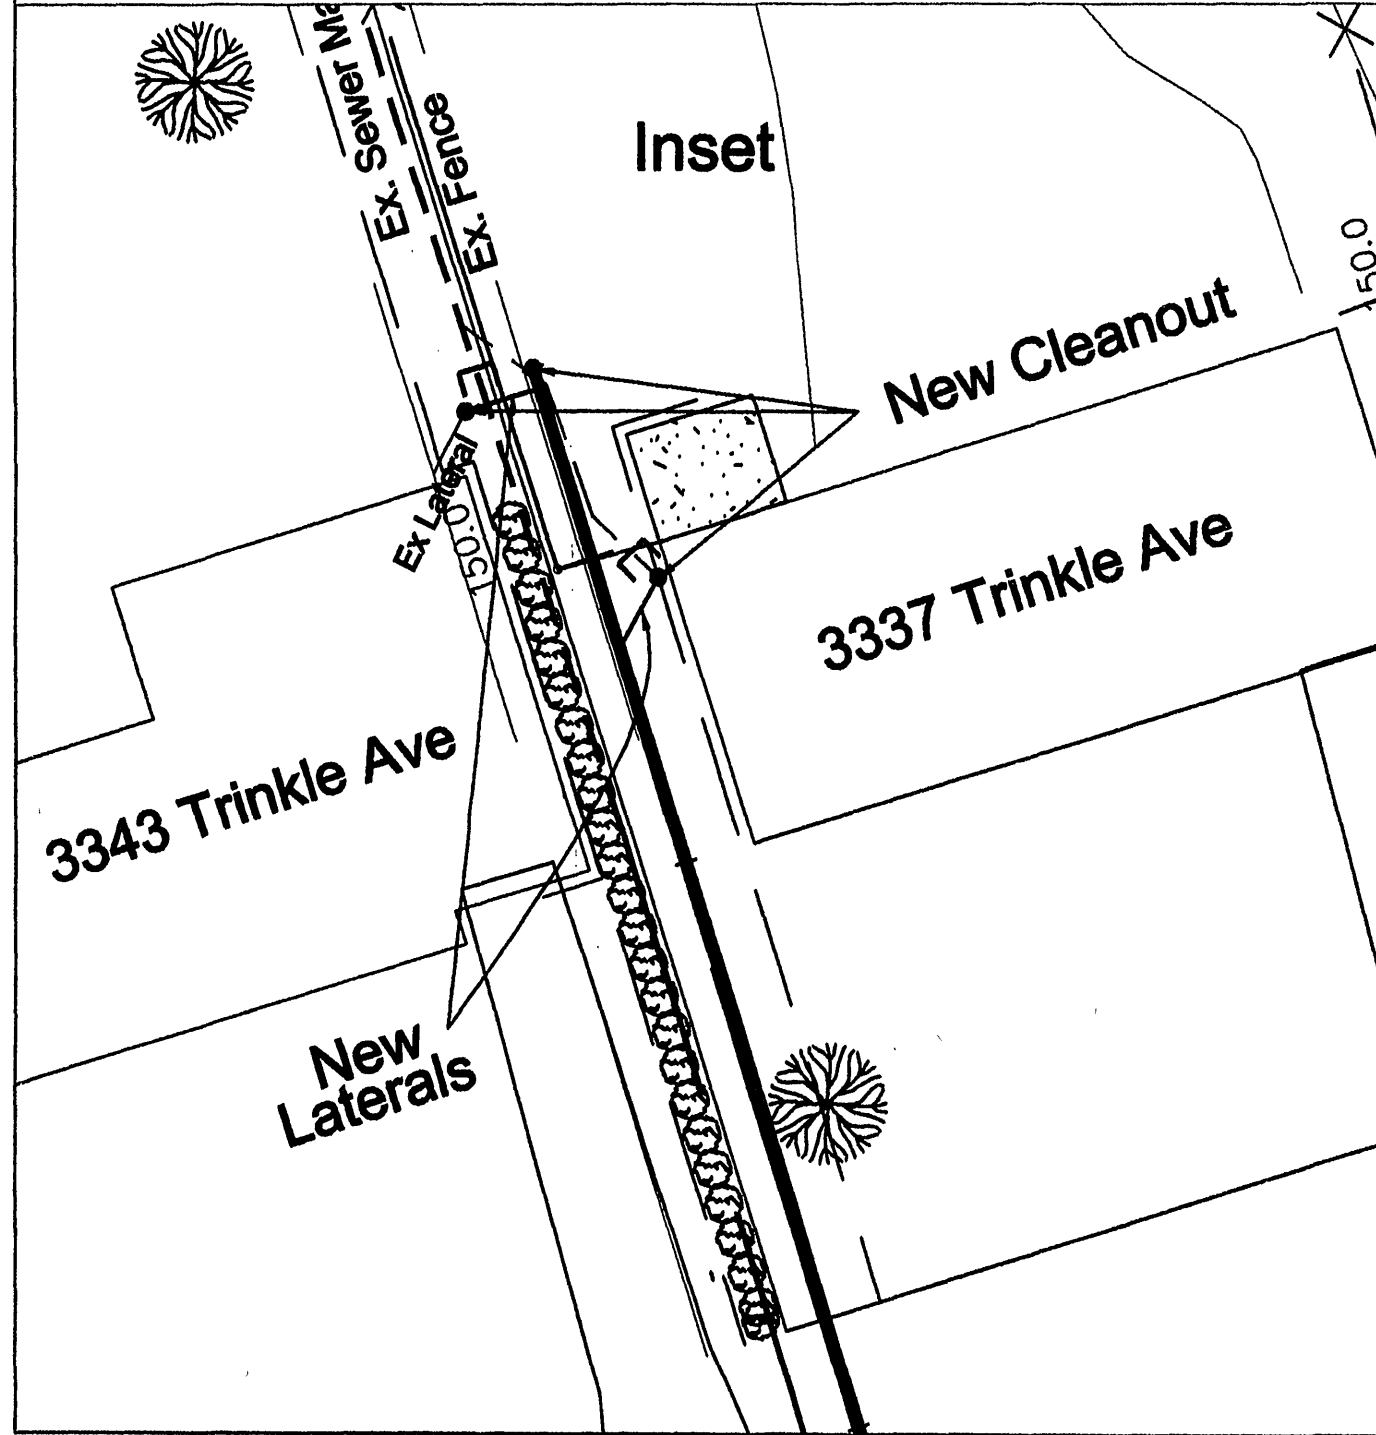

LEGEND

- EXISTING STORM
- EXISTING WATER
- EXISTING SANITARY SEWER
- PROPOSED SANITARY SEWER
- EXISTING SANITARY SEWER MANHOLE
- PROPOSED SANITARY SEWER MANHOLE
- PROPOSED SANITARY SEWER EASEMENT
- - - - - PROPERTY LINE
- - - - - EXISTING FENCELINE

SCALE: HOR. 1 IN. = 20 FT.
VERT. 1 IN. = 5 FT.

NOTES:
ALL WORK SHALL CONFORM TO THE LATEST EDITION OF WESTERN VIRGINIA WATER AUTHORITY DESIGN & CONSTRUCTION STANDARDS.

Trinkle manhole structures are CSI
Frames & Covers are Capitol Foundry
Pipe is Crestline

Troy Ave. MH Frame & Cover = East Jordan

MH Depths
MH 1 = 9.1' (Inside drop @ ~4.9')
MH 2 = 6.5'
MH 3 = 9.0'

WESTERN VIRGINIA



WATER AUTHORITY


ENGINEERING SERVICES

601 S JEFFERSON ST, SUITE 300

ROANOKE, VA 24011

540-853-5641

COMMONWEALTH OF VIRGINIA

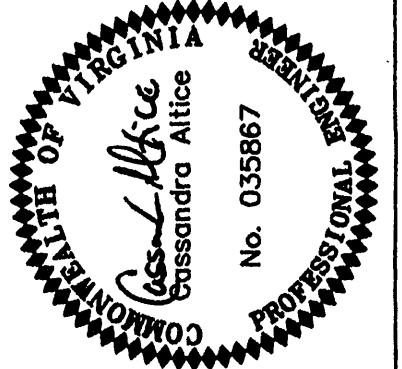

Cassandra Altice

No. 035867

PROFESSIONAL

Trinkle Avenue

Sewer Replacement

CIVIL/SITEWORK

PLAN

Rev	Description	Date	By
AS-BUILT		12/06/2006	K.V.

Designed: CDA

Drawn: CDA

Checked: CDA

Approved: JGR

Date: 29 AUG 2006

Project: 6T7HZ8

C2

Sheet 2 of 4

WVWA ID# 6T7HZ8