
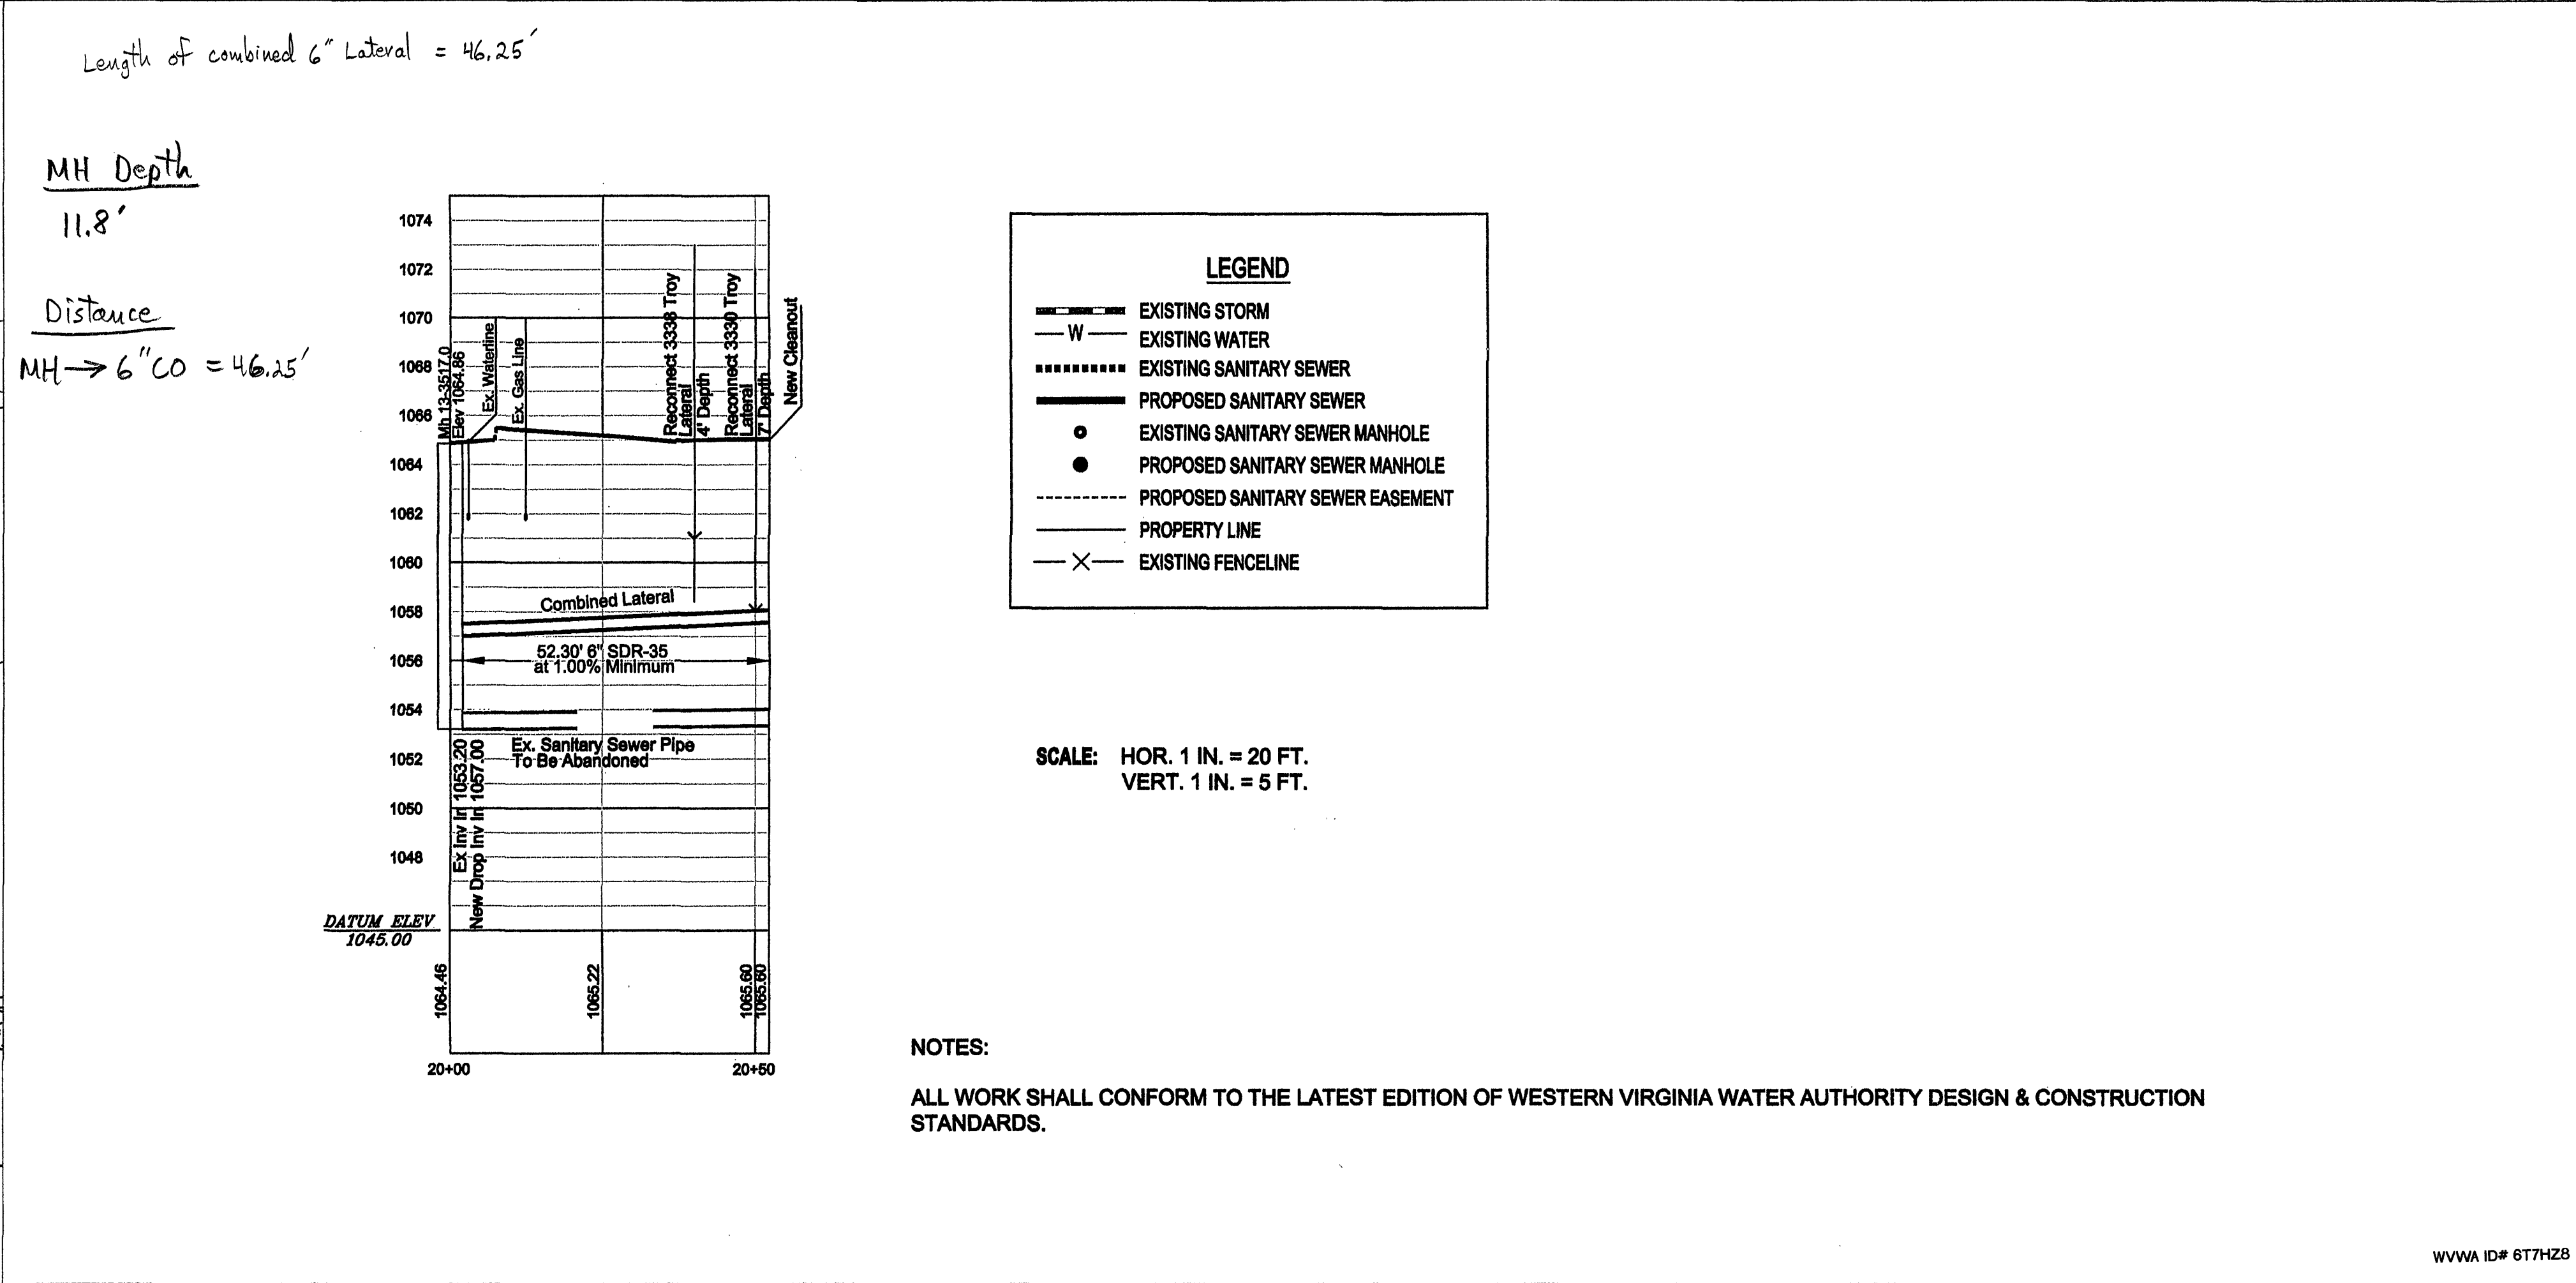
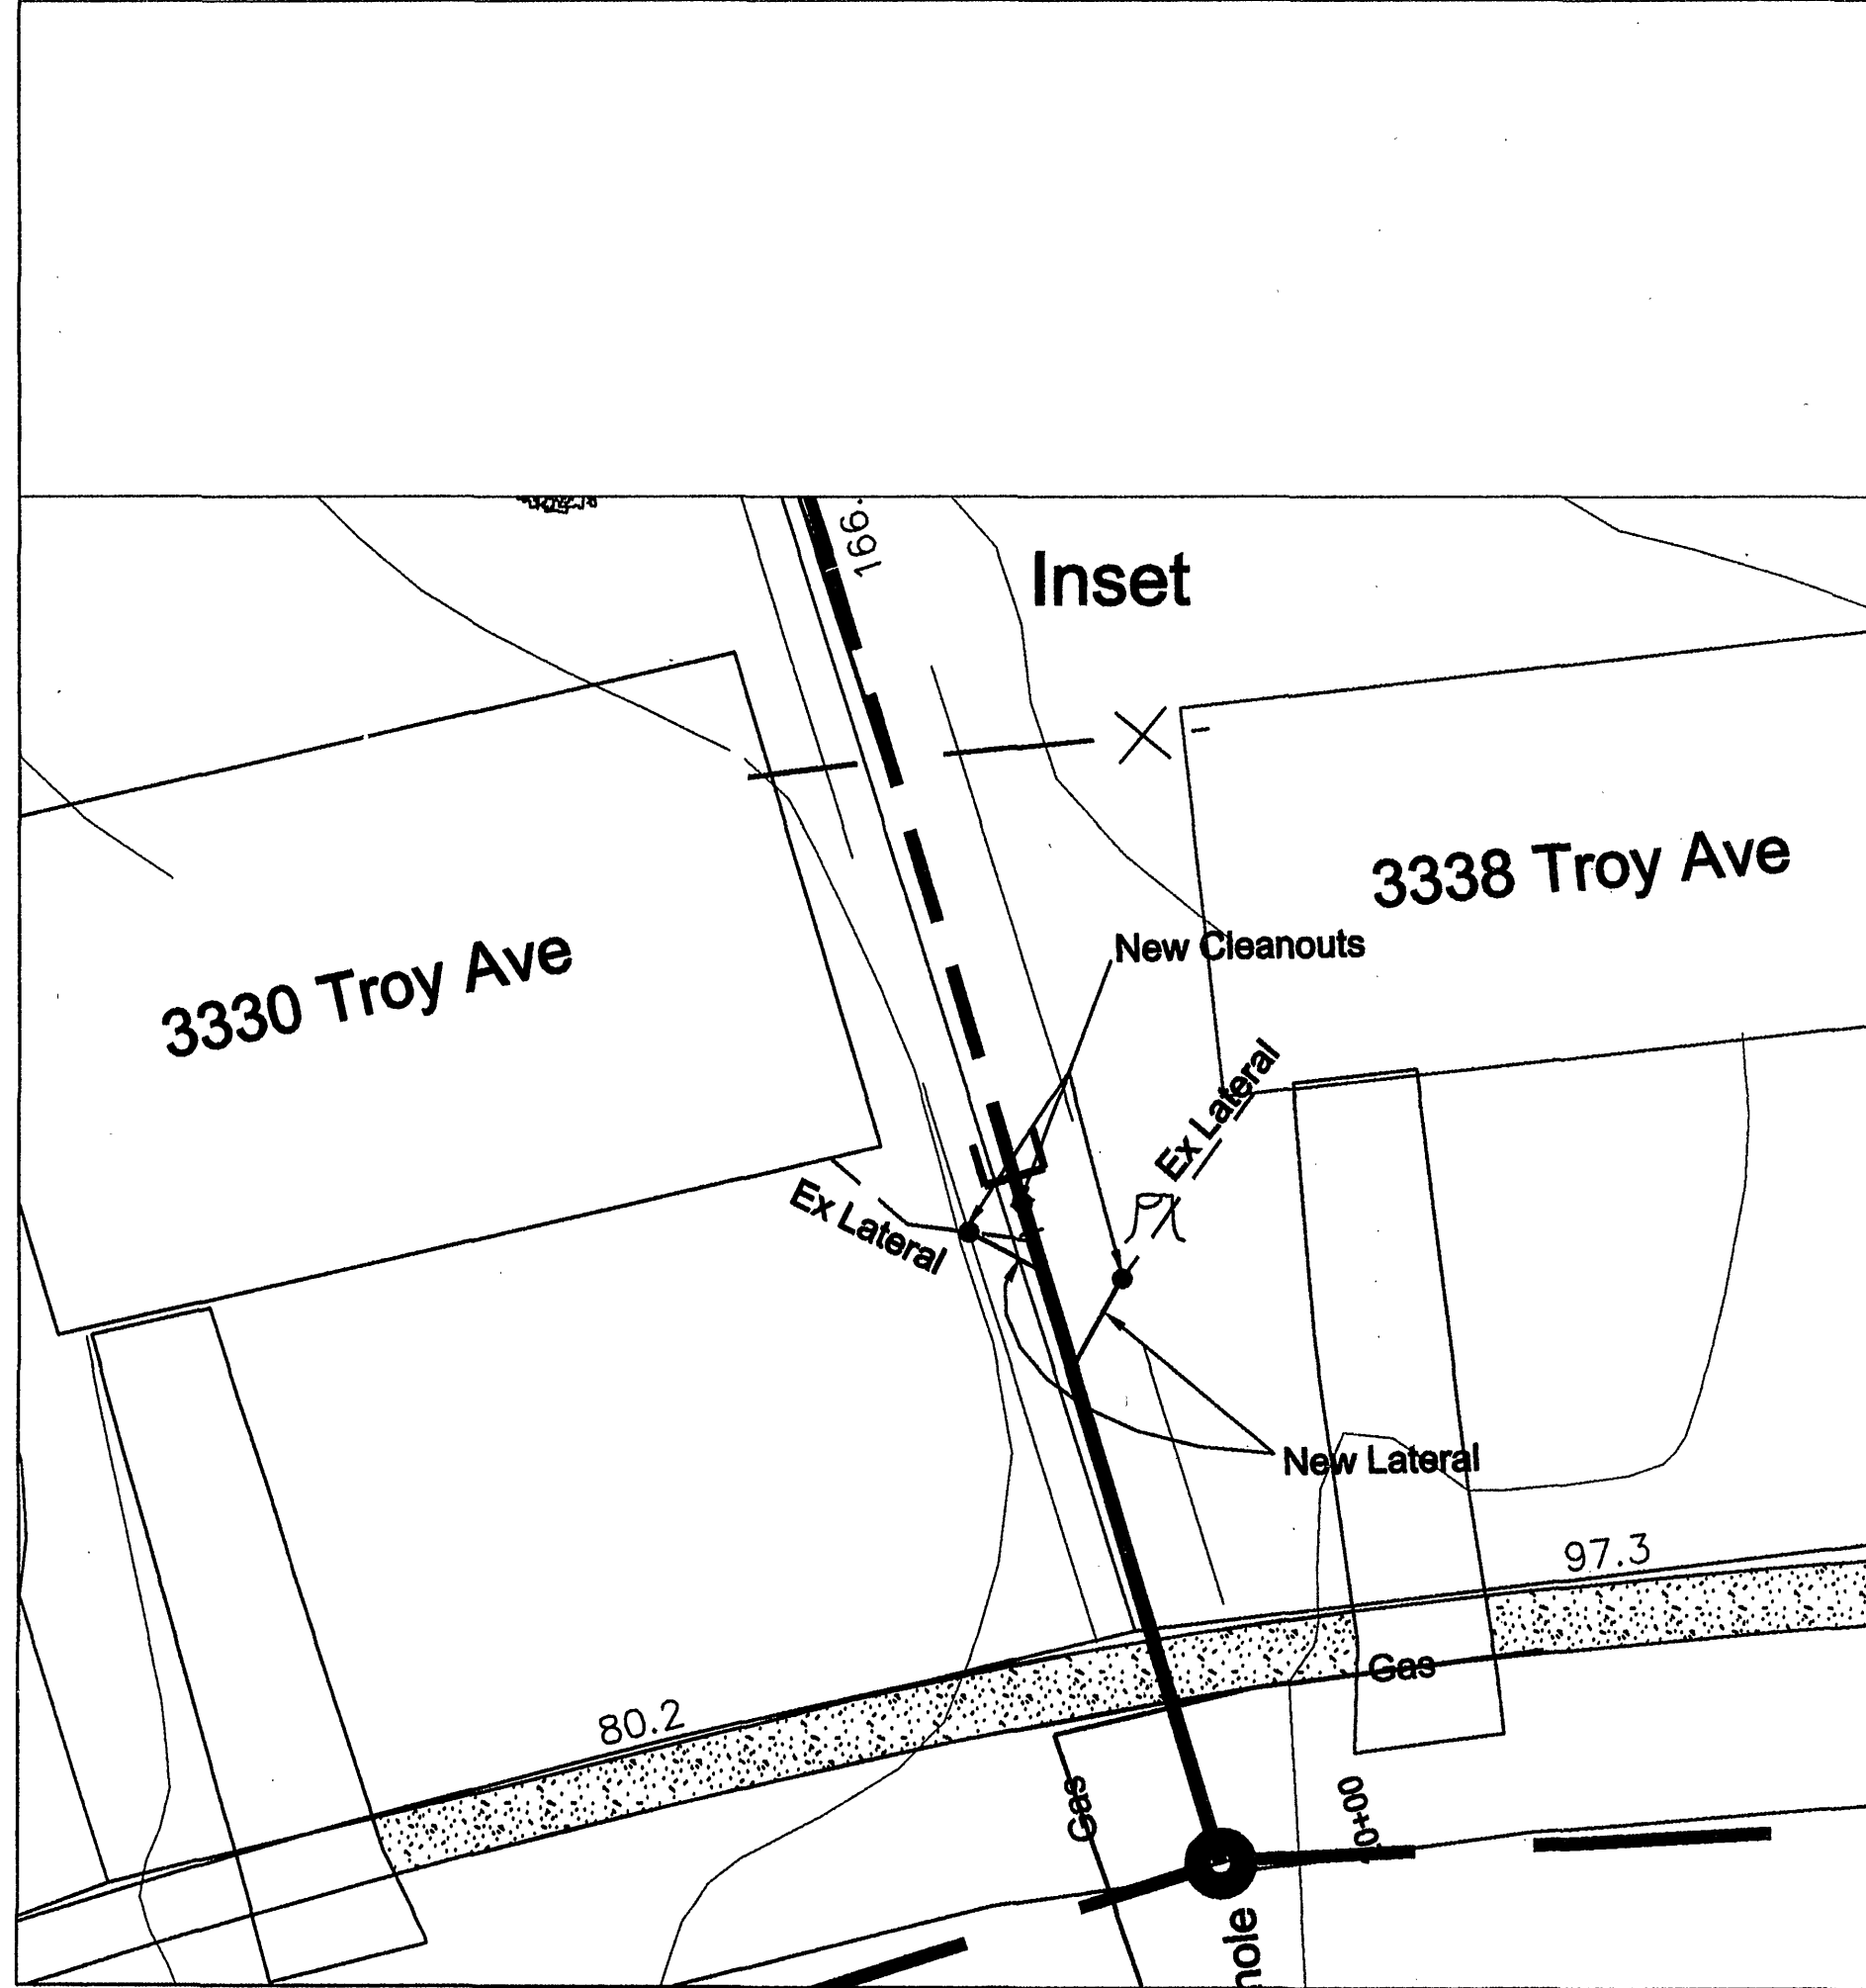


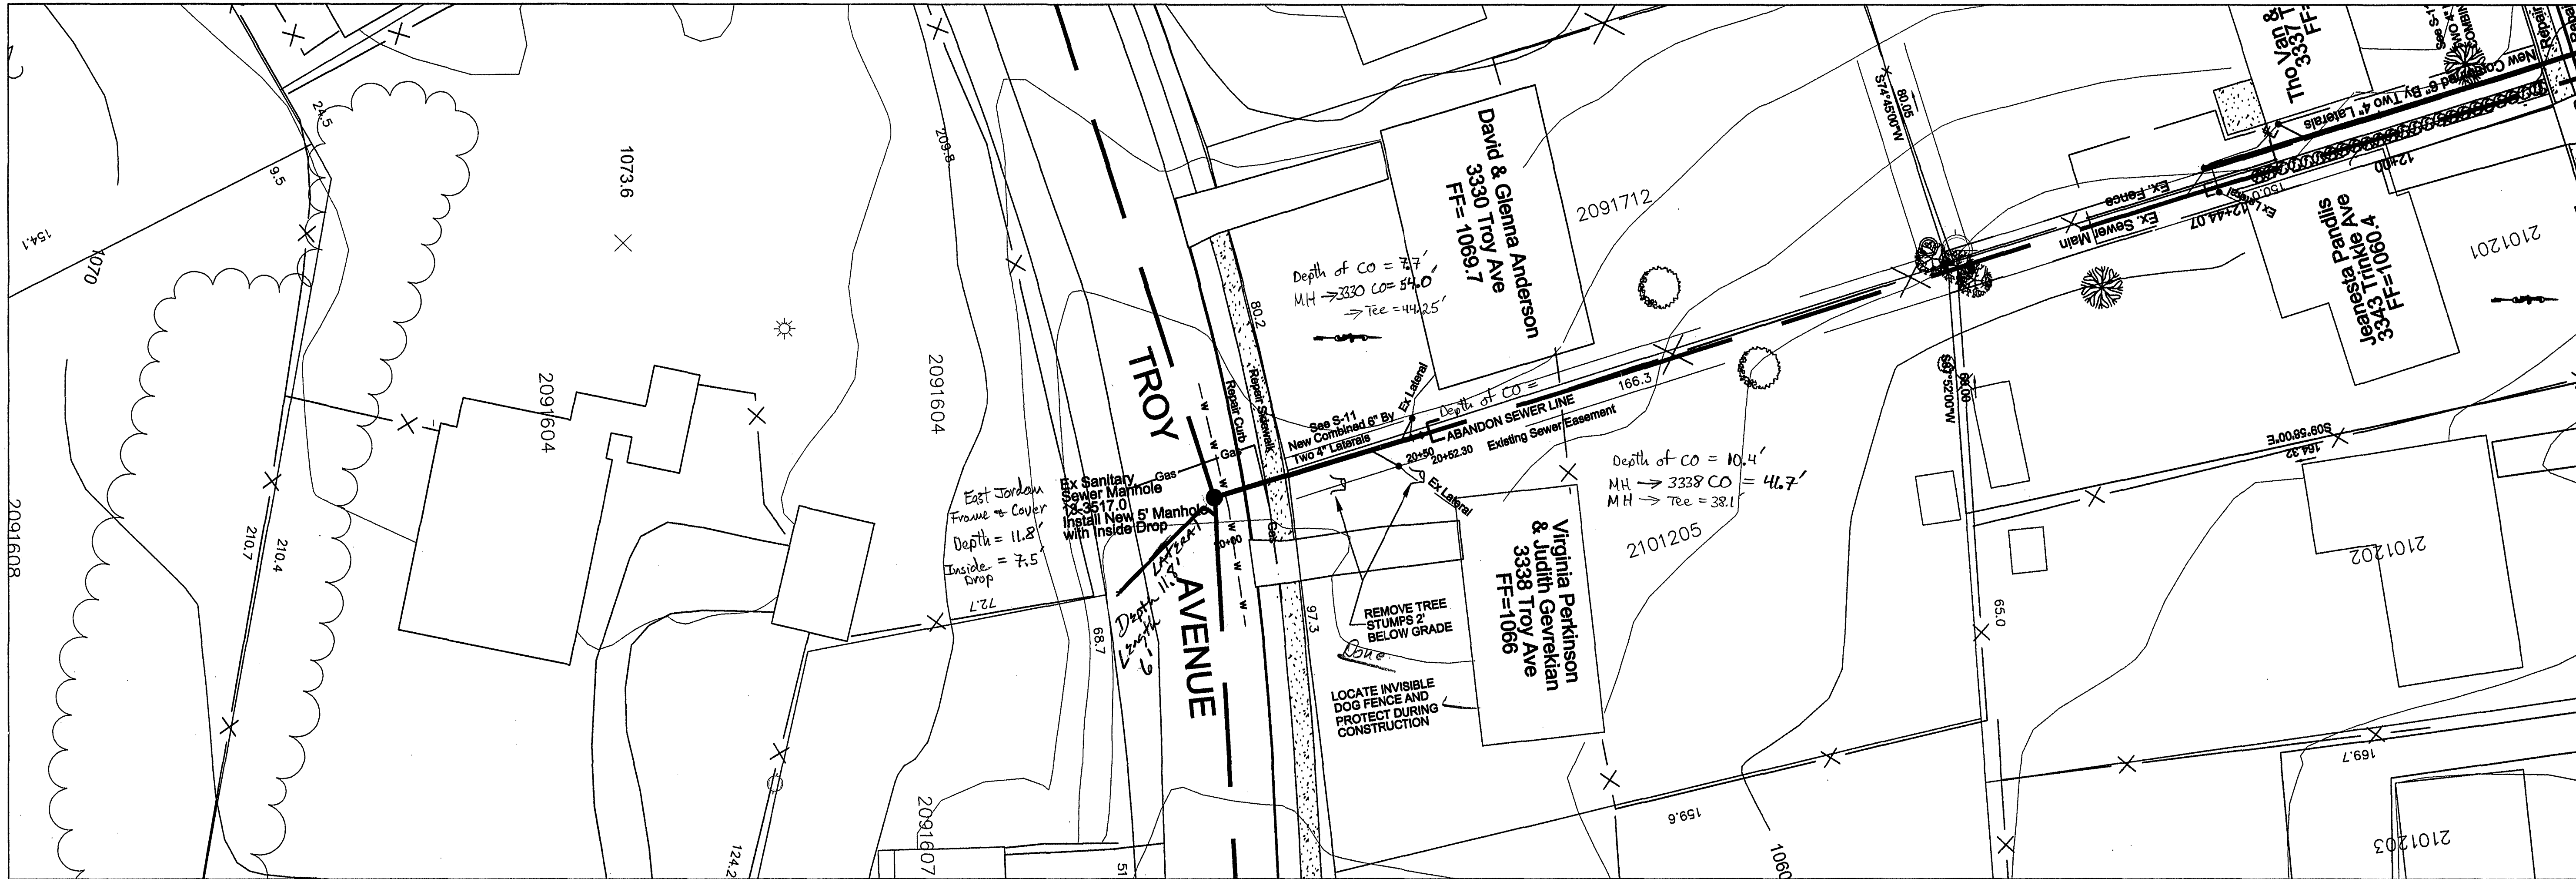

**WESTERN VIRGINIA
WATER AUTHORITY**

ENGINEERING SERVICES
601 S JEFFERSON ST, SUITE 300
ROANOKE, VA 24011
540-853-5700

Trinkle Avenue
Sewer Replacement
CIVIL/SITEWORK
PLAN

Rev	Description	Date	By
AS-BUILT		12/08/2008	K.W.

Designed: CDA
Drawn: CDA
Checked: CDA
Approved: JGR
Date: 29 AUG 2006
Project: 6T7HZ8

C3
Sheet 3 of 4