




LOCATION AND INDEX MAP
SCALE: 1"=1000'

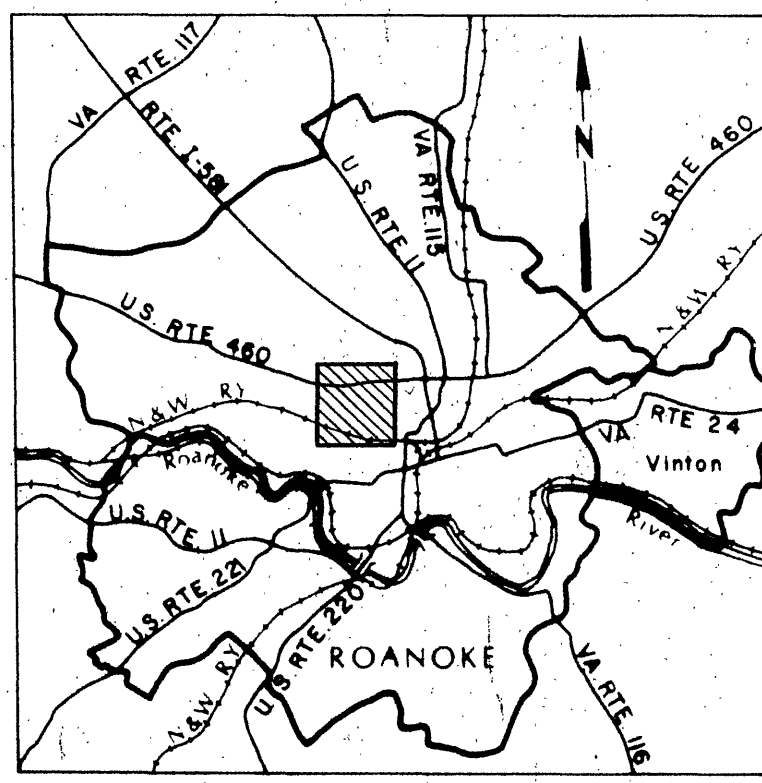

VICINITY MAP
SCALE: 1"=2 MILES

INTERCEPTOR SEWERS

PROJECT NO. 3
TROUT RUN INTERCEPTOR

CITY OF ROANOKE, VIRGINIA

INDEX OF DRAWINGS	
SHEET NO.	DESCRIPTION
1	TITLE SHEET
2	TYPICAL SECTION & SUMMARY SHEET
3-16	PLAN & PROFILE SHEETS
17	METERING CHAMBER

GENERAL NOTES:

- ALL DISTANCES AND INVERTS ARE OF MANHOLE.
- ALL DISTANCES SHOWN ARE HORIZONTAL MEASUREMENTS.
- LOCATION AND DEPTHS OF UTILITIES ARE APPROXIMATE AND THE CONTRACTOR IS RESPONSIBLE FOR DETERMINING EXACT LOCATIONS AND DEPTHS.
- LOCATIONS OF EXIST. LATERALS WERE TAKEN FROM MAPS AND RECORDS. EXACT LOCATIONS SHALL BE DETERMINED DURING CONSTRUCTION.
- THE EXISTING SEWERAGE SYSTEM INDICATED TO BE ABANDONED SHALL REMAIN IN SERVICE UNTIL ALL DOWNSTREAM SECTIONS OF THE MAIN SEWER ARE TESTED AND PLACED INTO OPERATION.
- EXISTING MANHOLE TO BE REMOVED.
- EXISTING MANHOLE TO BE REMOVED AND FLOW CONNECTED TO NEW SYSTEM.
- EXISTING MANHOLE TO REMAIN.
- EXISTING MANHOLE TO REMAIN AND FLOW CONNECTED TO NEW SYSTEM.
- ALL SEWER LATERALS SHOWN ON THE PLANS OR LOCATED DURING CONSTRUCTION SHALL BE CONNECTED TO THE NEW SEWER LINE.

LEGEND

—●—	NEW SANITARY SEWER & MANHOLE
—S—	EXISTING SANITARY SEWER
—SD—	EXISTING STORM DRAIN
—E—	EXISTING FIRE ALARM
—G—	EXISTING GAS LINE
—T—	EXISTING TELEPHONE DUCT
—W—	EXISTING WATER LINE
—X—X—X—	SEWER LINE TO BE ABANDONED
—O—	EXISTING UTILITY POLE
—○—	EXISTING MANHOLE
—△—	TREE OR SHRUB
—▲—	SURVEY BASE LINE
—+—+—+—	PLUG EXIST. SEWER
— — — —	NEW SEWER LATERAL


AS BUILT

FB 624
(July 1982)

CONTRACTOR'S
AS BUILT SET
Do Not DESTROY!

AS ADVERTISED

JAN 4 1976

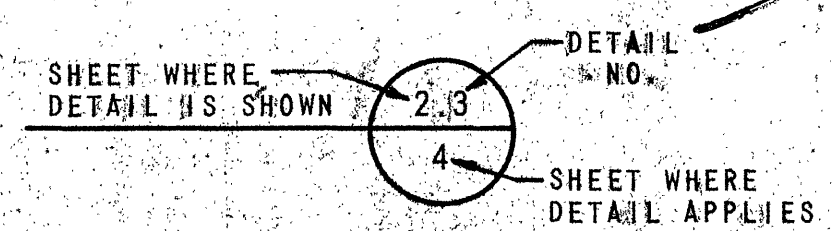

APPROVED
Charles H. Mattern
CITY ENGINEER
2-13-74

REVISION	DATE	DESCRIPTION	BY	APP
DESIGNED	1973	INTERCEPTOR SEWERS PROJECT NO. 3		
DRAWN	JT			
CHECKED	JMT	TITLE SHEET		
APPROVED	JMT			
SUBMITTED	1/2/74			
		CITY OF ROANOKE	VIRGINIA	
		HAYES, SEAY, MATTERN & MATTERN ARCHITECTS-ENGINEERS	SCALE AS NOTED	
		UPDATED BY CITY ENGINEERS OFFICE	DATE FEB 1974	
			COMM. NO. 3293	
			SHEET 1 OF 17	

5466 SET NO. 7