


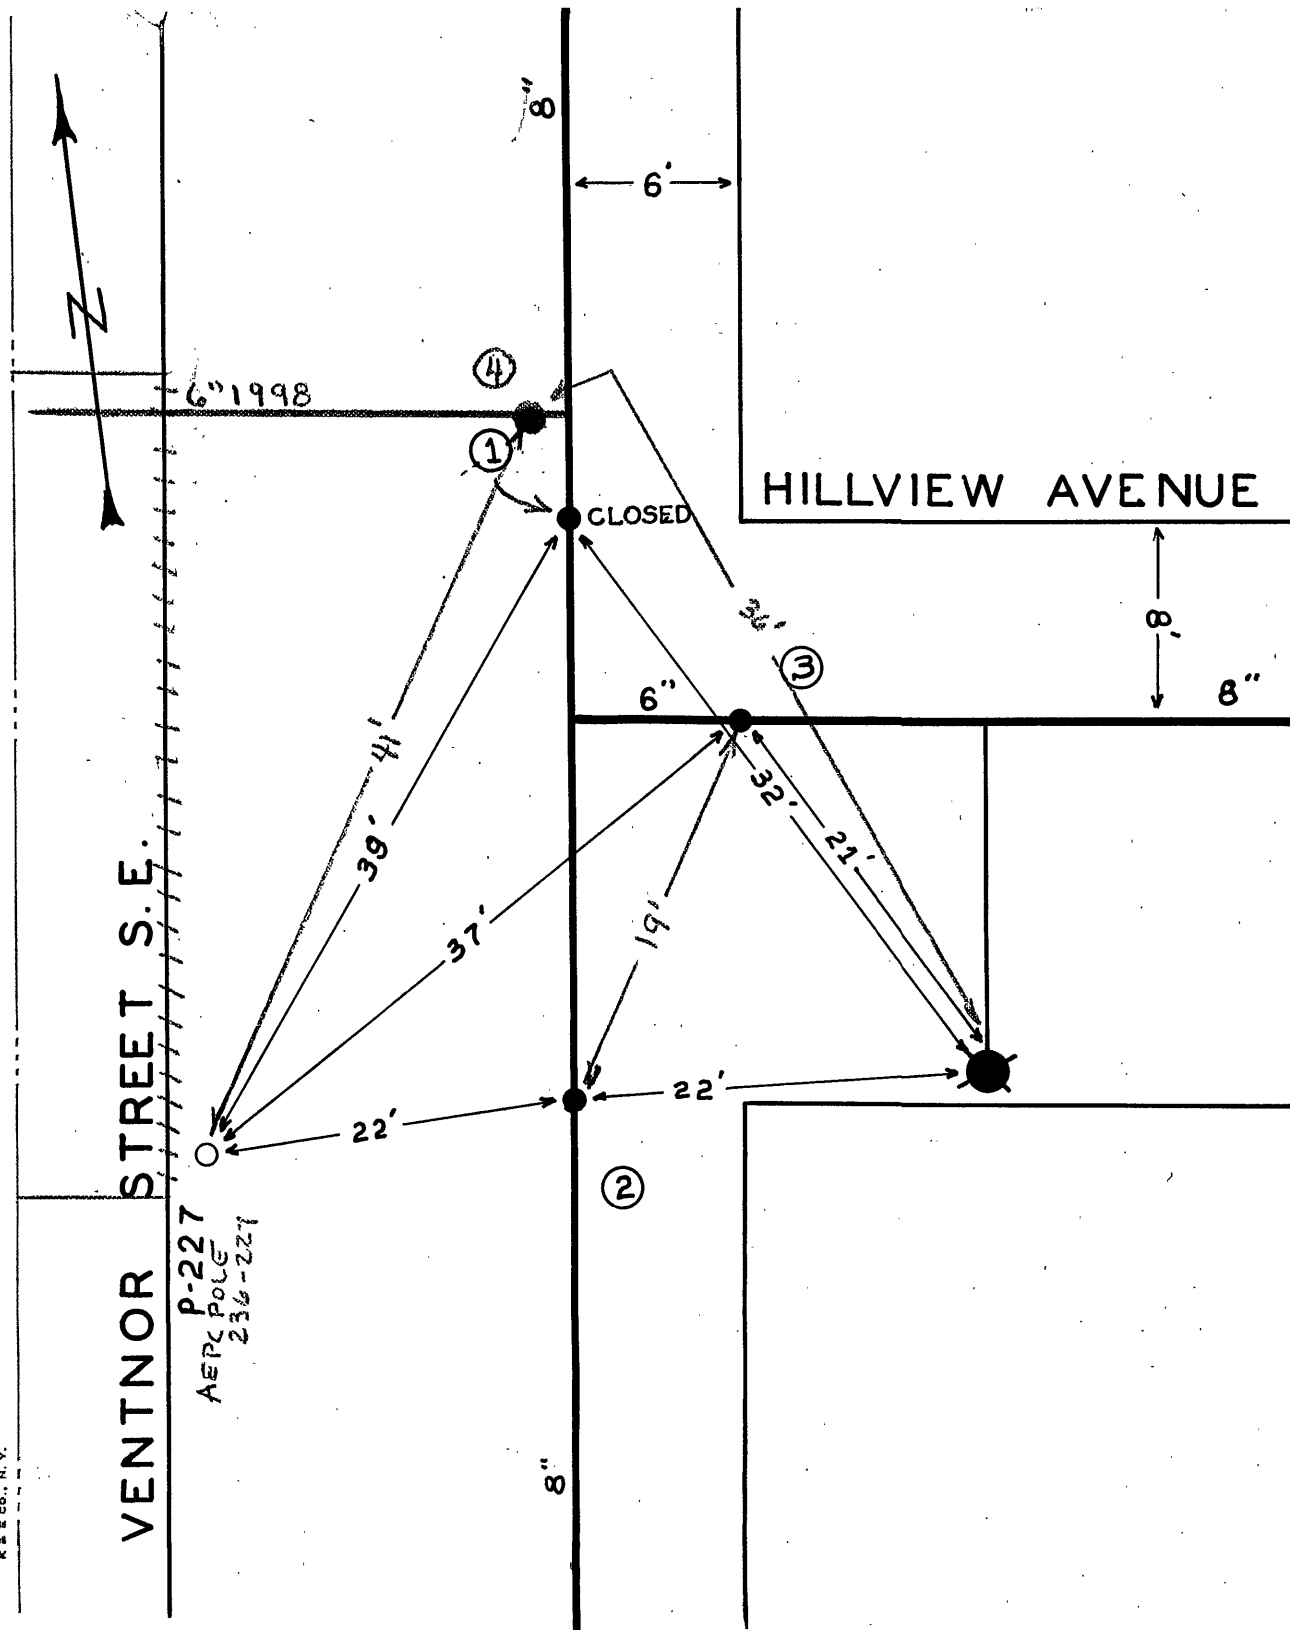

CITY OF ROANOKE—WATER DEPT.	
VALVE DIAGRAM	
HILLVIEW AVENUE &	
VENTNOR STREET S. E.	
SEC. MAP 439	
DATE	PAGE NO.

PAGE NO.