


TROXELL ROAD

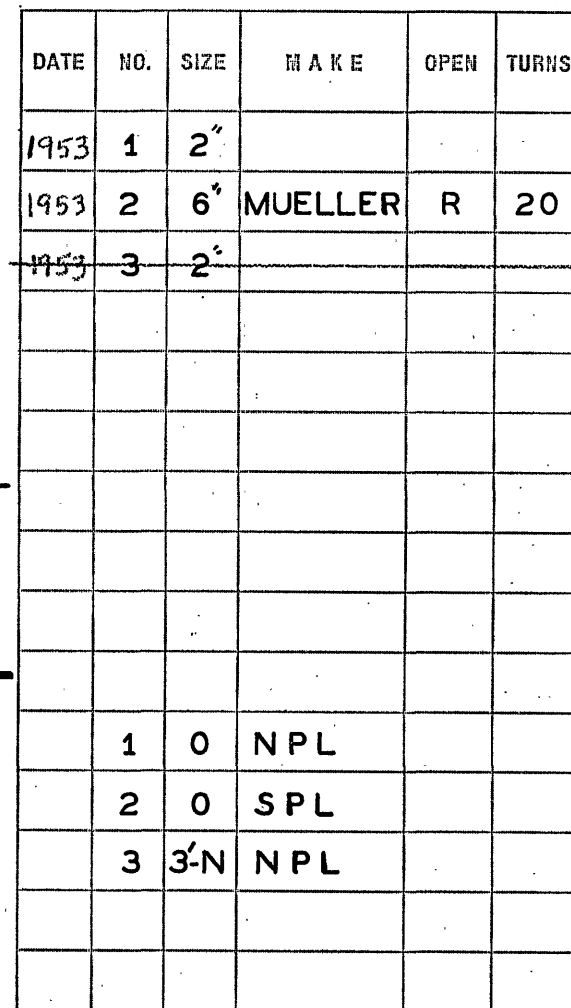

PAGE NO.