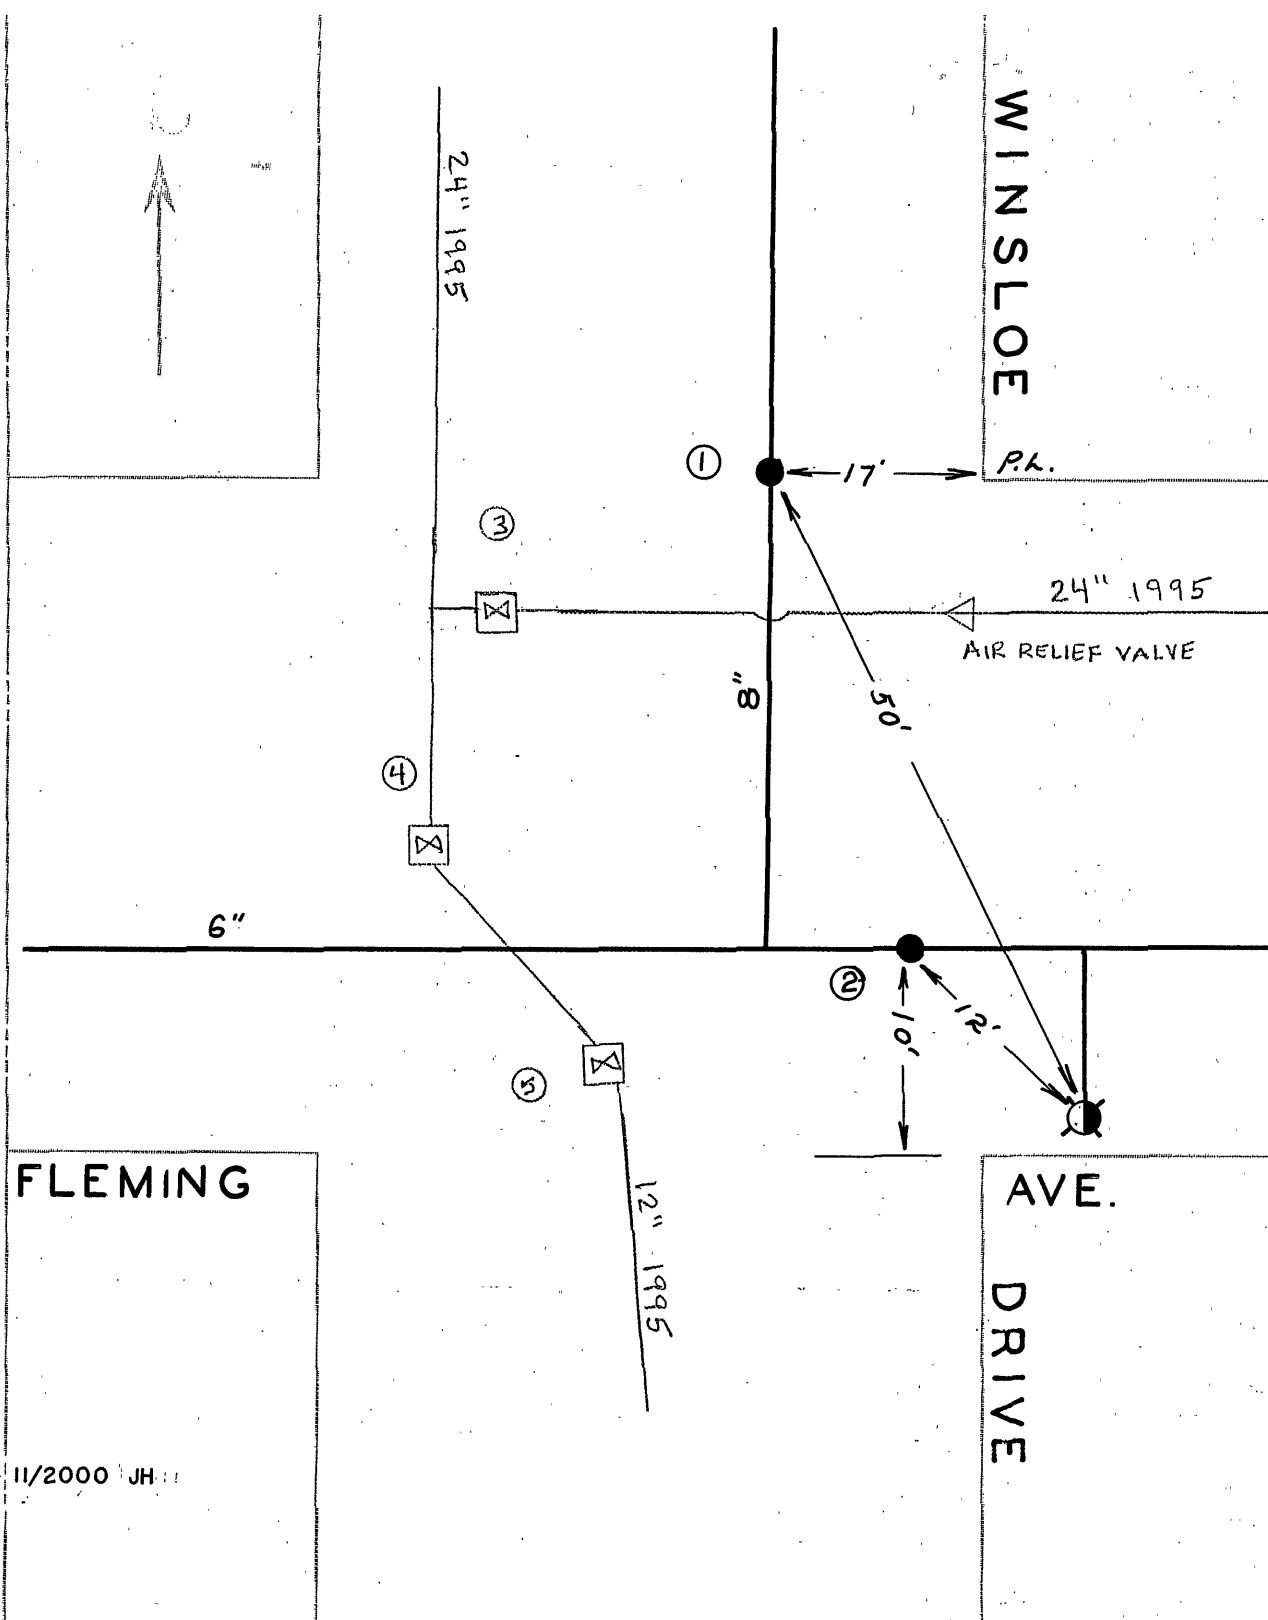


[illegible]

CITY OF ROANOKE—WATER DEPT	
VALVE DIAGRAM	
FLEMING AVE. & S. 1ST ST.	
WINSLOE DR.	
SEC. MAP	209
N. W.	
DATE	PAGE NO.