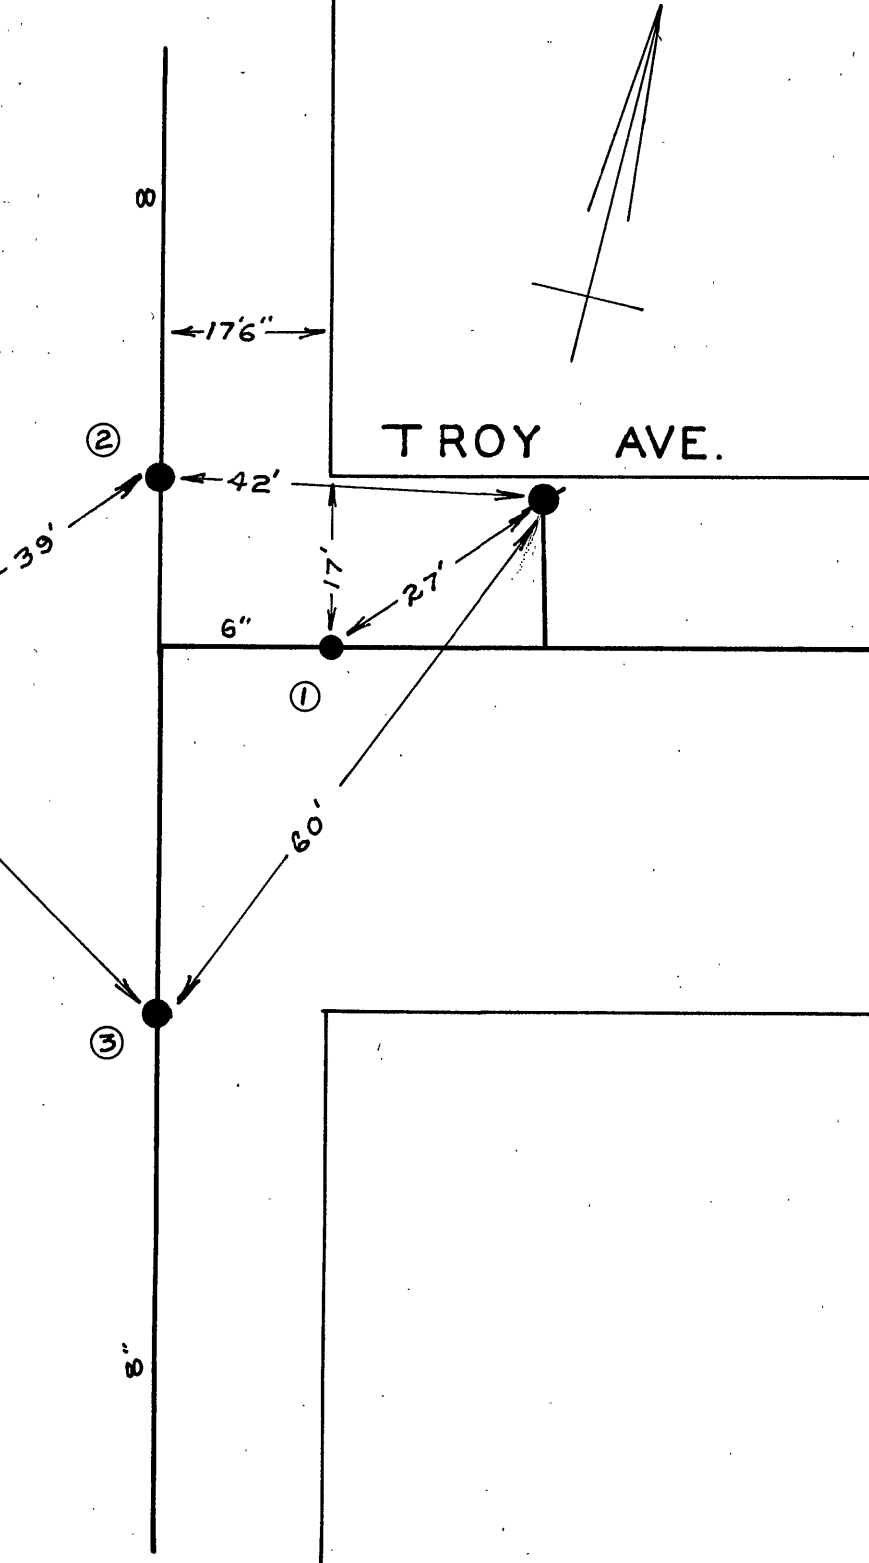


3/2001 JH

Q P-230-1099

24" 1995

24" 1995

[illegible]

CITY OF ROANOKE—WATER DEPT.
VALVE DIAGRAM

TROY AVE. &
WINSLOE DRIVE.

SEC. MAP: 209 N. W.

DATE: PAGE NO.