

"AS-BUILT" MARCH 4, 2002

# DEVELOPMENT PLANS

FOR

## SECTION 7

# "TULIPS IN THE GARDENS"

SITUATED IN

CAVE SPRING MAGISTERIAL DISTRICT  
ROANOKE COUNTY, VIRGINIA

DATE: 9 JULY 2001

PROPERTY OF

STRAUSS CONSTRUCTION CORPORATION

### "AS-BUILT"


#### NOTE:

1. "AS-BUILT" INFORMATION TAKEN FROM PLANS FURNISHED BY J.P. TURNER & BROTHERS, INC., CONTRACTOR.
2. "AS-BUILT" DIMENSIONS SHOWN IN BRACKETS.

### INDEX OF DRAWINGS

SHEET No.	DESCRIPTION
-----------	-------------

- |    |  |
|----|--|
| 1. | LUMSDEN ASSOCIATES COVER SHEET           |
| 2. | ROANOKE COUNTY STD. COVER SHEET          |
| 3. | RECORD MAP                               |
| 4. | NOTES & DETAILS                          |
| 5. | DIMENSIONAL LAYOUT & UTILITIES           |
| 6. | GRADING & STORM DRAINAGE                 |
| 7. | PROFILES                                 |
| 8. | EROSION & SEDIMENT CONTROL PLAN          |
| 9. | ROANOKE CO. STD. EROSION CONTROL DETAILS |

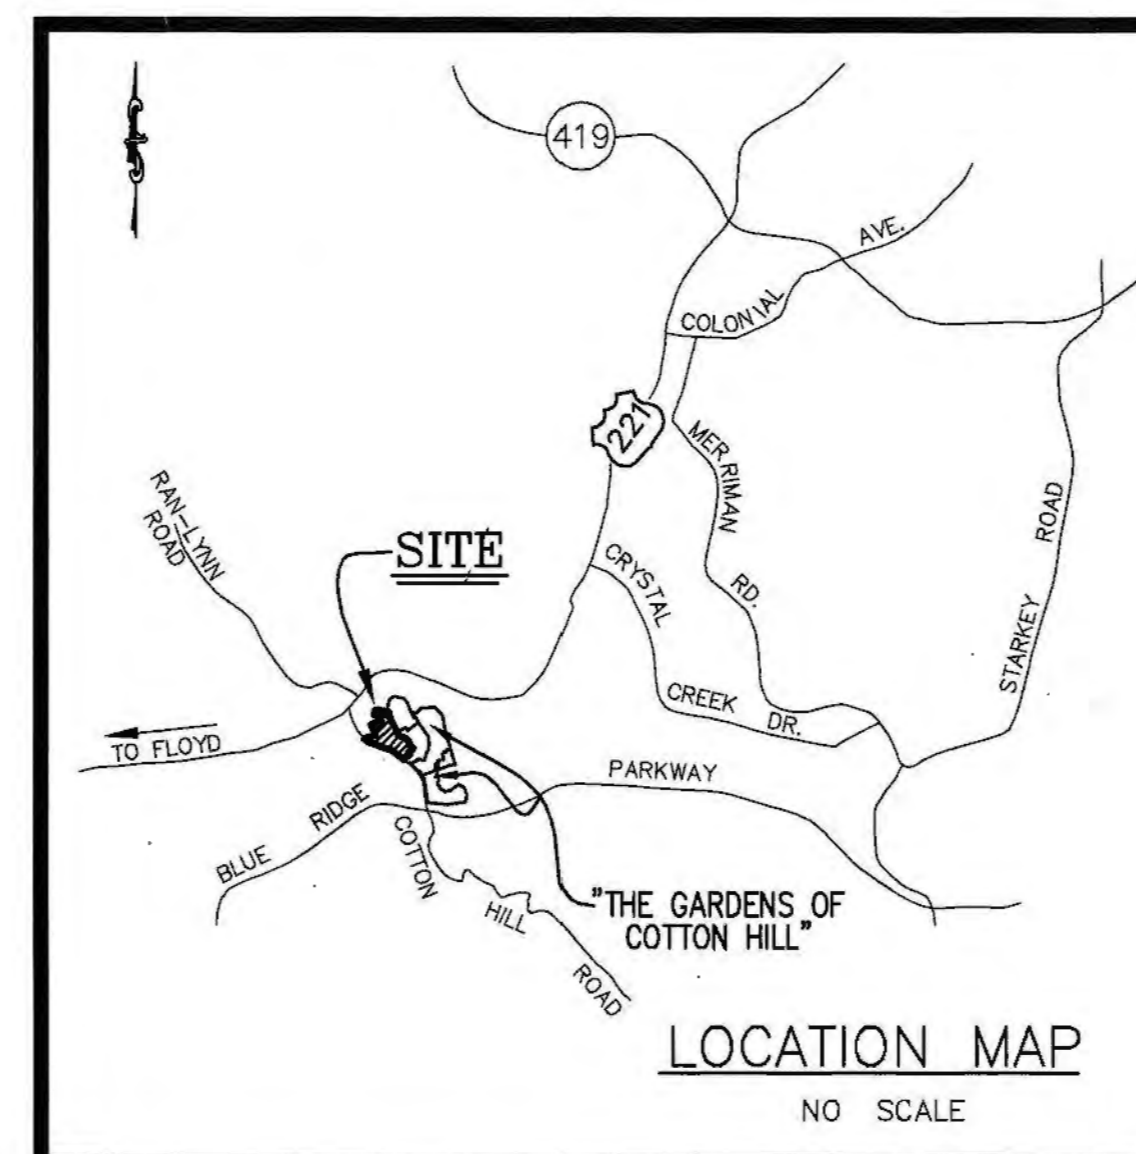

LUMSDEN ASSOCIATES, P.C.  
ENGINEERS-SURVEYORS-PLANNERS  
ROANOKE, VIRGINIA

#### REVISIONS

DATE	SHEETS	DATE	SHEETS