


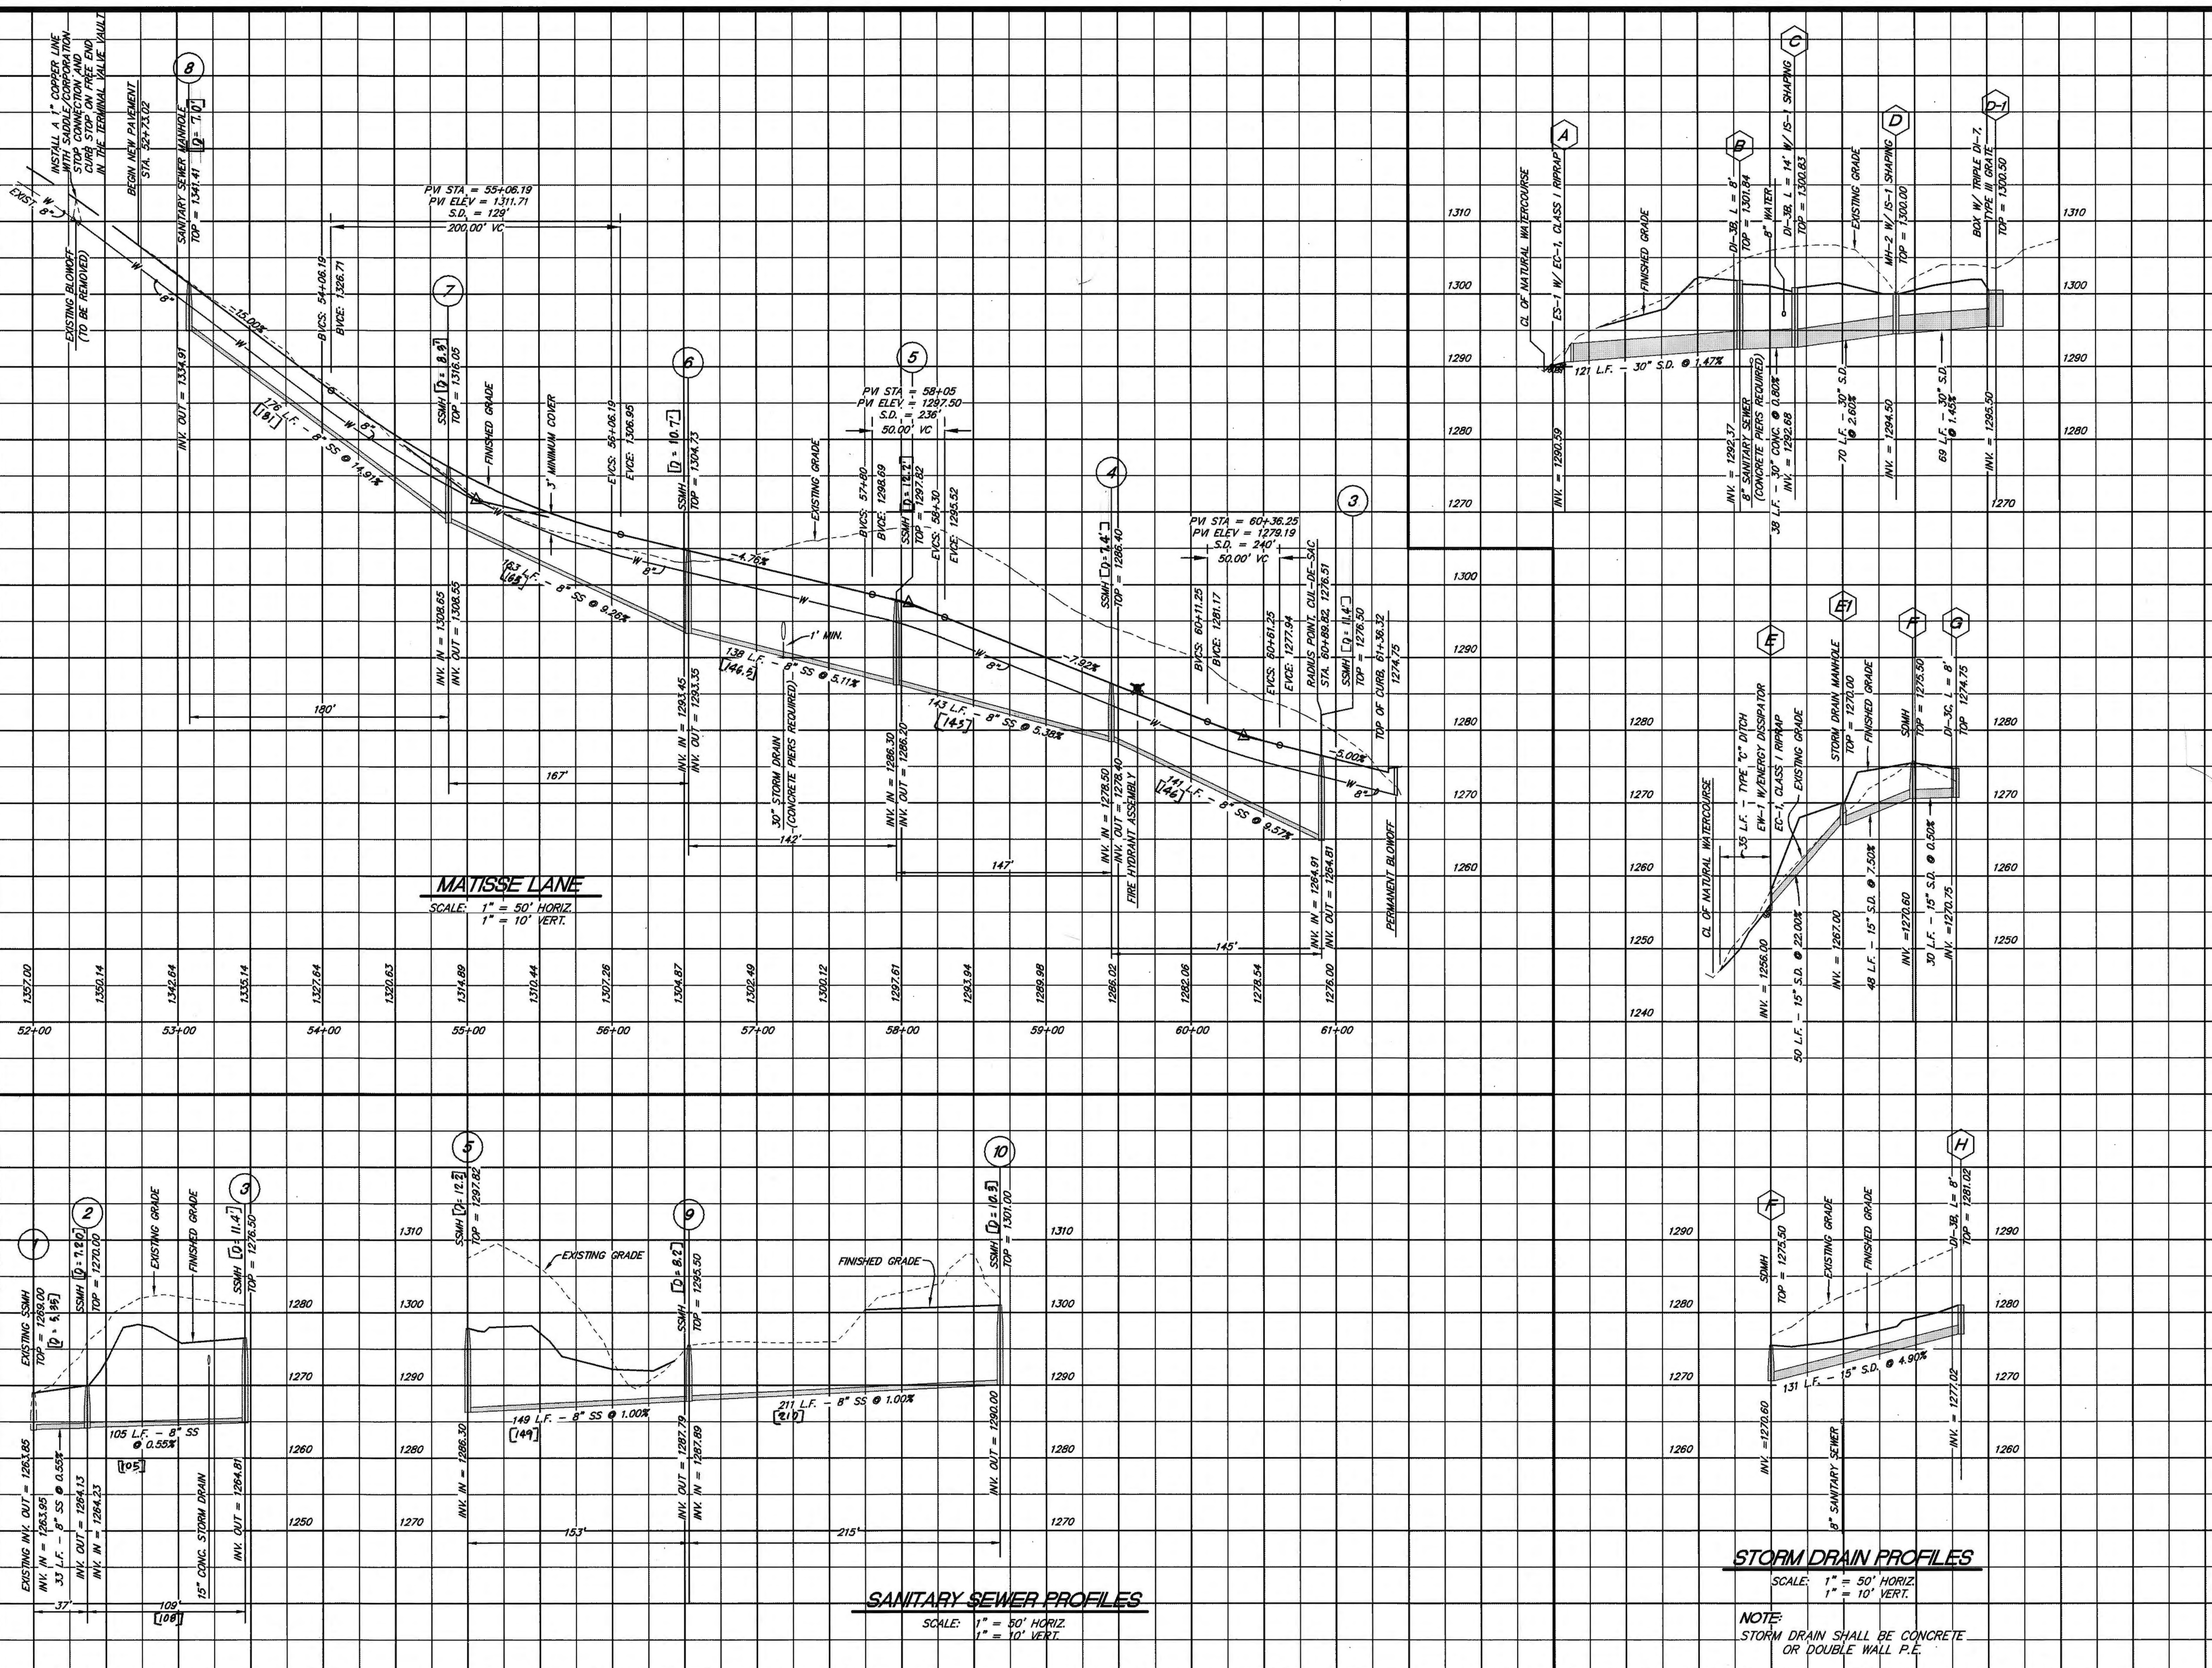

SECTION No. 7
TULIPS IN THE GARDENS
PREPARED FOR
STRAUSS CONSTRUCTION CORPORATION
CAVE SPRING MAGISTERIAL DISTRICT
ROANOKE COUNTY, VIRGINIA

LA
LUMSDEN ASSOCIATES, P.C.
ENGINEERS-SURVEYORS-PLANNERS
ROANOKE, VIRGINIA

PHONE: (540) 774-4411
FAX: (540) 772-9445
E-MAIL: MAIL@LUMSDENPC.COM

REVISIONS
NO. DATE DESCRIPTION
1 10/4/01 STRUCTURE D-1 TOP & INVERT ELEV.
2
3
4
5 9/14/02 "AS-BUILT"

DATE: 9 JULY 2001
SCALE: AS SHOWN
COMMISSION NO.: 01-076
CADD FILE: P:\01-01076\ENVS\DEVLANS\PROFILES
SHEET 7 OF 9

"AS-BUILT"

PROFILES

SECTION No. 7

TULIPS IN THE GARDENS

PREPARED FOR

STRAUSS CONSTRUCTION CORPORATION

CAVE SPRING MAGISTERIAL DISTRICT

ROANOKE COUNTY, VIRGINIA

REVISIONS

NO. DATE DESCRIPTION

1 10/4/01 STRUCTURE D-1 TOP & INVERT ELEV.

DATE: 9 JULY 2001

SCALE: AS SHOWN

COMMISSION NO.: 01-076

CADD FILE: P:\01-01076\ENVS\DEVLANS\PROFILES

SHEET 7 OF 9

"AS-BUILT"