

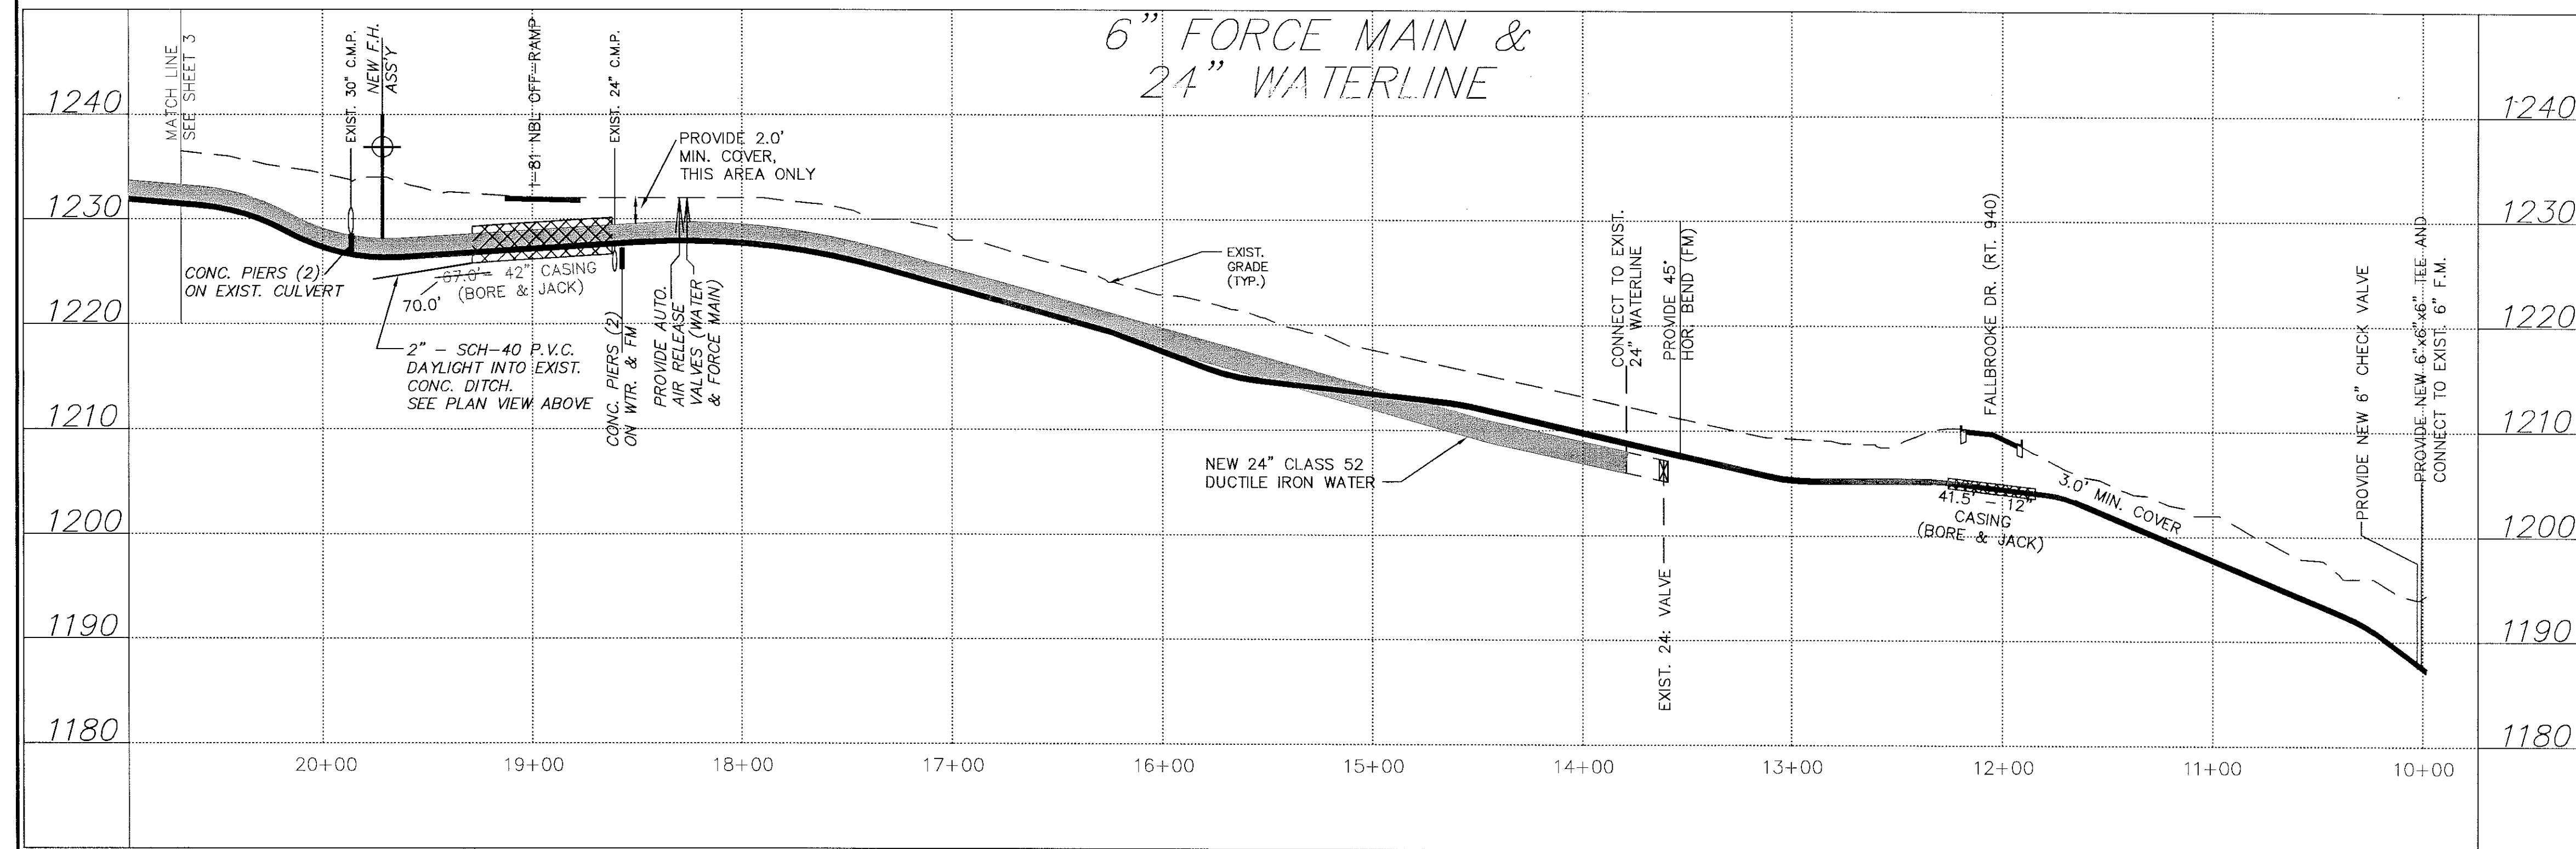


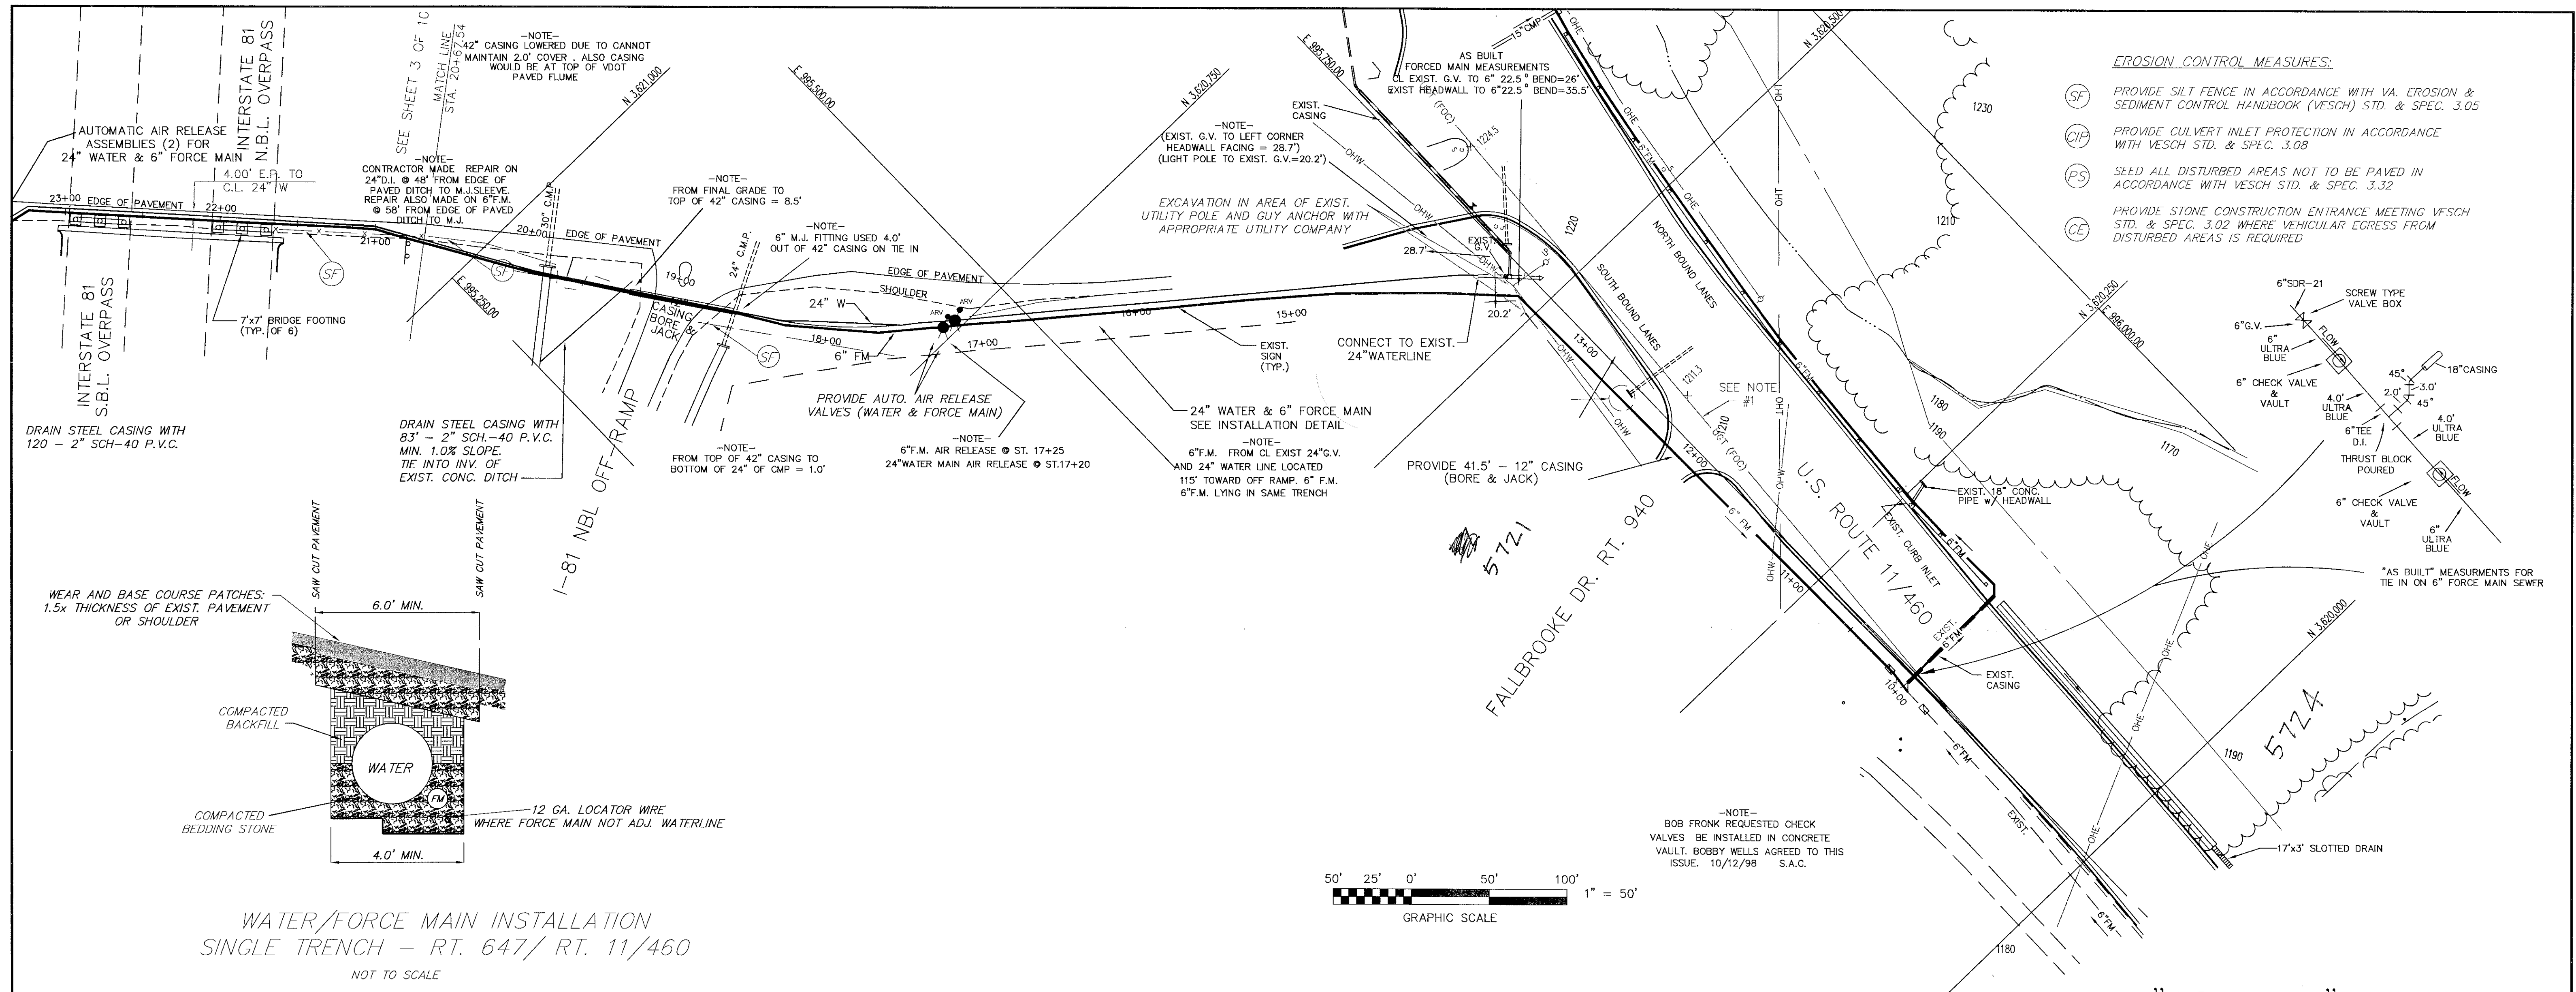


REVISION	DATE	BY	COMMENTS
1	3/12	JMS	REVISIONS PER ROANOKE COUNTY UTILITY DEPT.
2	4/14	JMS	BORE & JACK FALLBROOKE, MH#200 LOCATION
3	5/17/00	LG	"AS BUILT" PER ROANOKE COUNTY INSPECTION DEPT

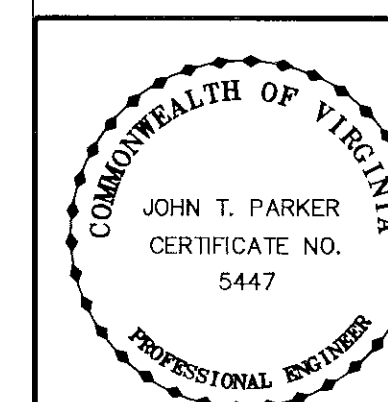

SANITARY SEWER & WATERLINE PLAN & PROFILE
FOR
TWINE HOLLOW WATERLINE & SANITARY
SEWER EXTENSION
COUNTY OF ROANOKE
SITUATE DOW HOLLOW ROAD AND TWINE HOLLOW
ROAD NEAR INTERSTATE 81
COUNTY OF ROANOKE, VIRGINIA
CATAWBA MAGISTERIAL DISTRICT
SCALE: 1" = 50' DATE: FEBRUARY 2, 1998

DESIGNED BY J.M. SCHULTHEIS
DRAWN BY J.M.S./J.P.R.
CHECKED BY J.T. PARKER
W.O. # 98-0335
N.B. RKE CO. PRO. #2
TAX NO.
DATE: FEB. 2, 1998

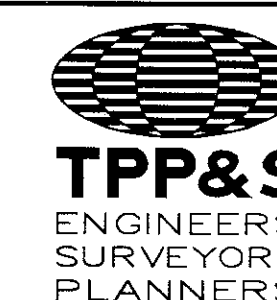

T. P. PARKER & SON
816 Boulevard
Post Office Box 39
Salem, Virginia 24153
Telephone: 540-387-1153
FAX: 540-389-5767