
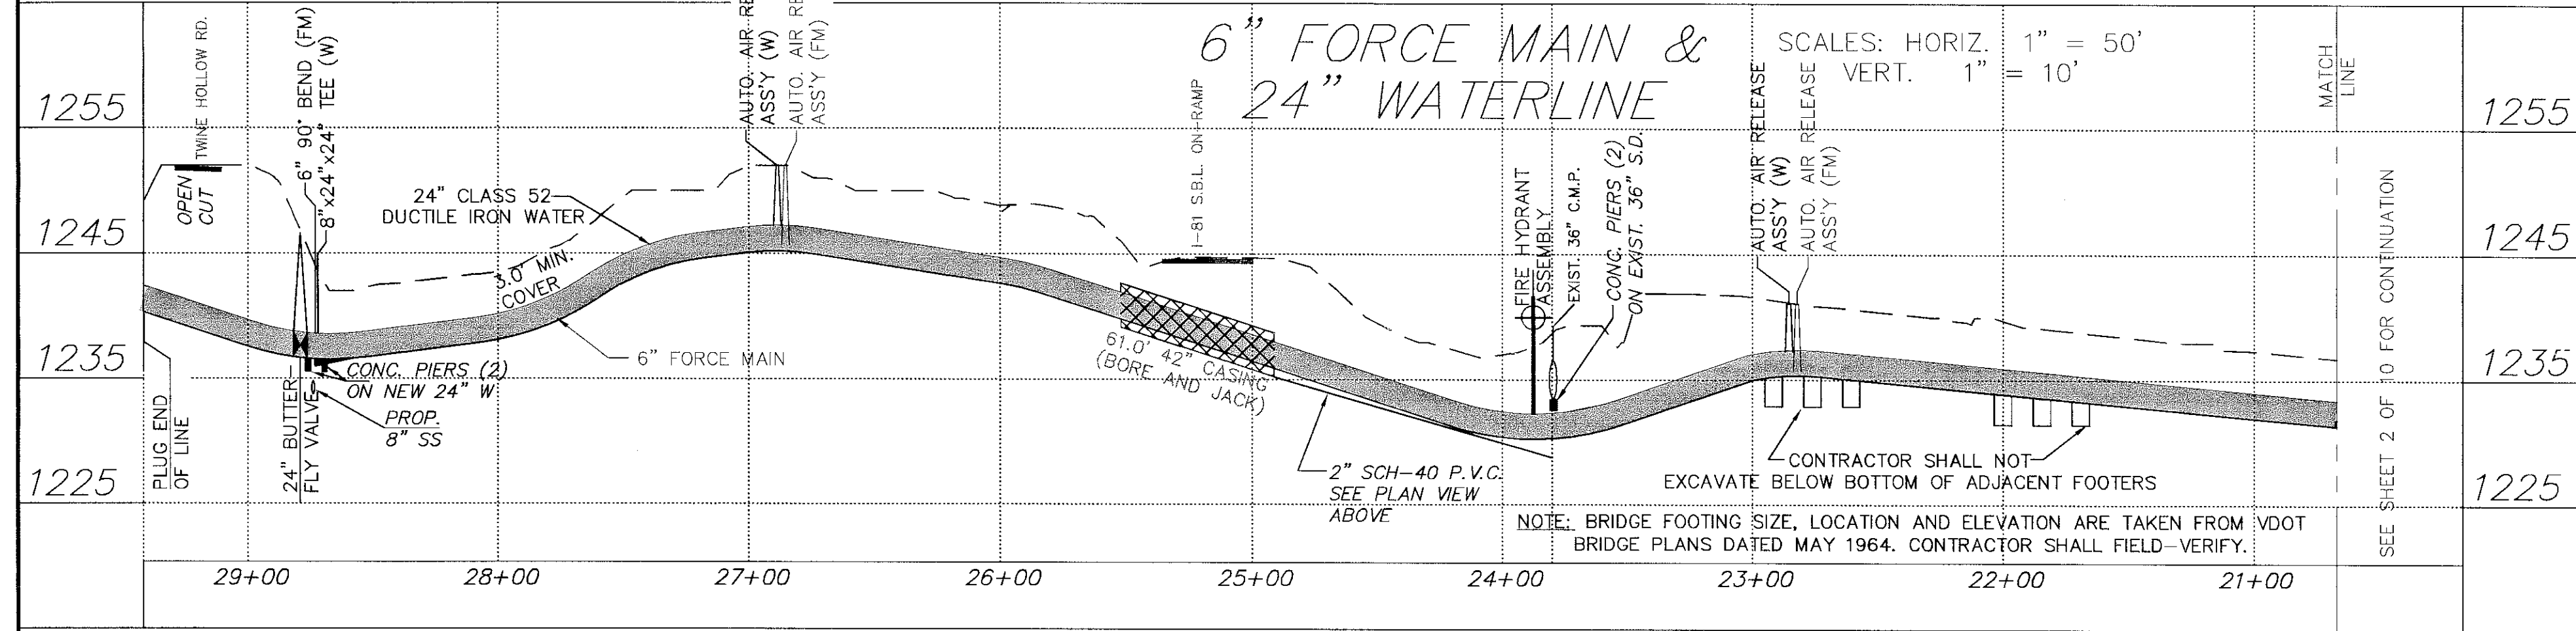


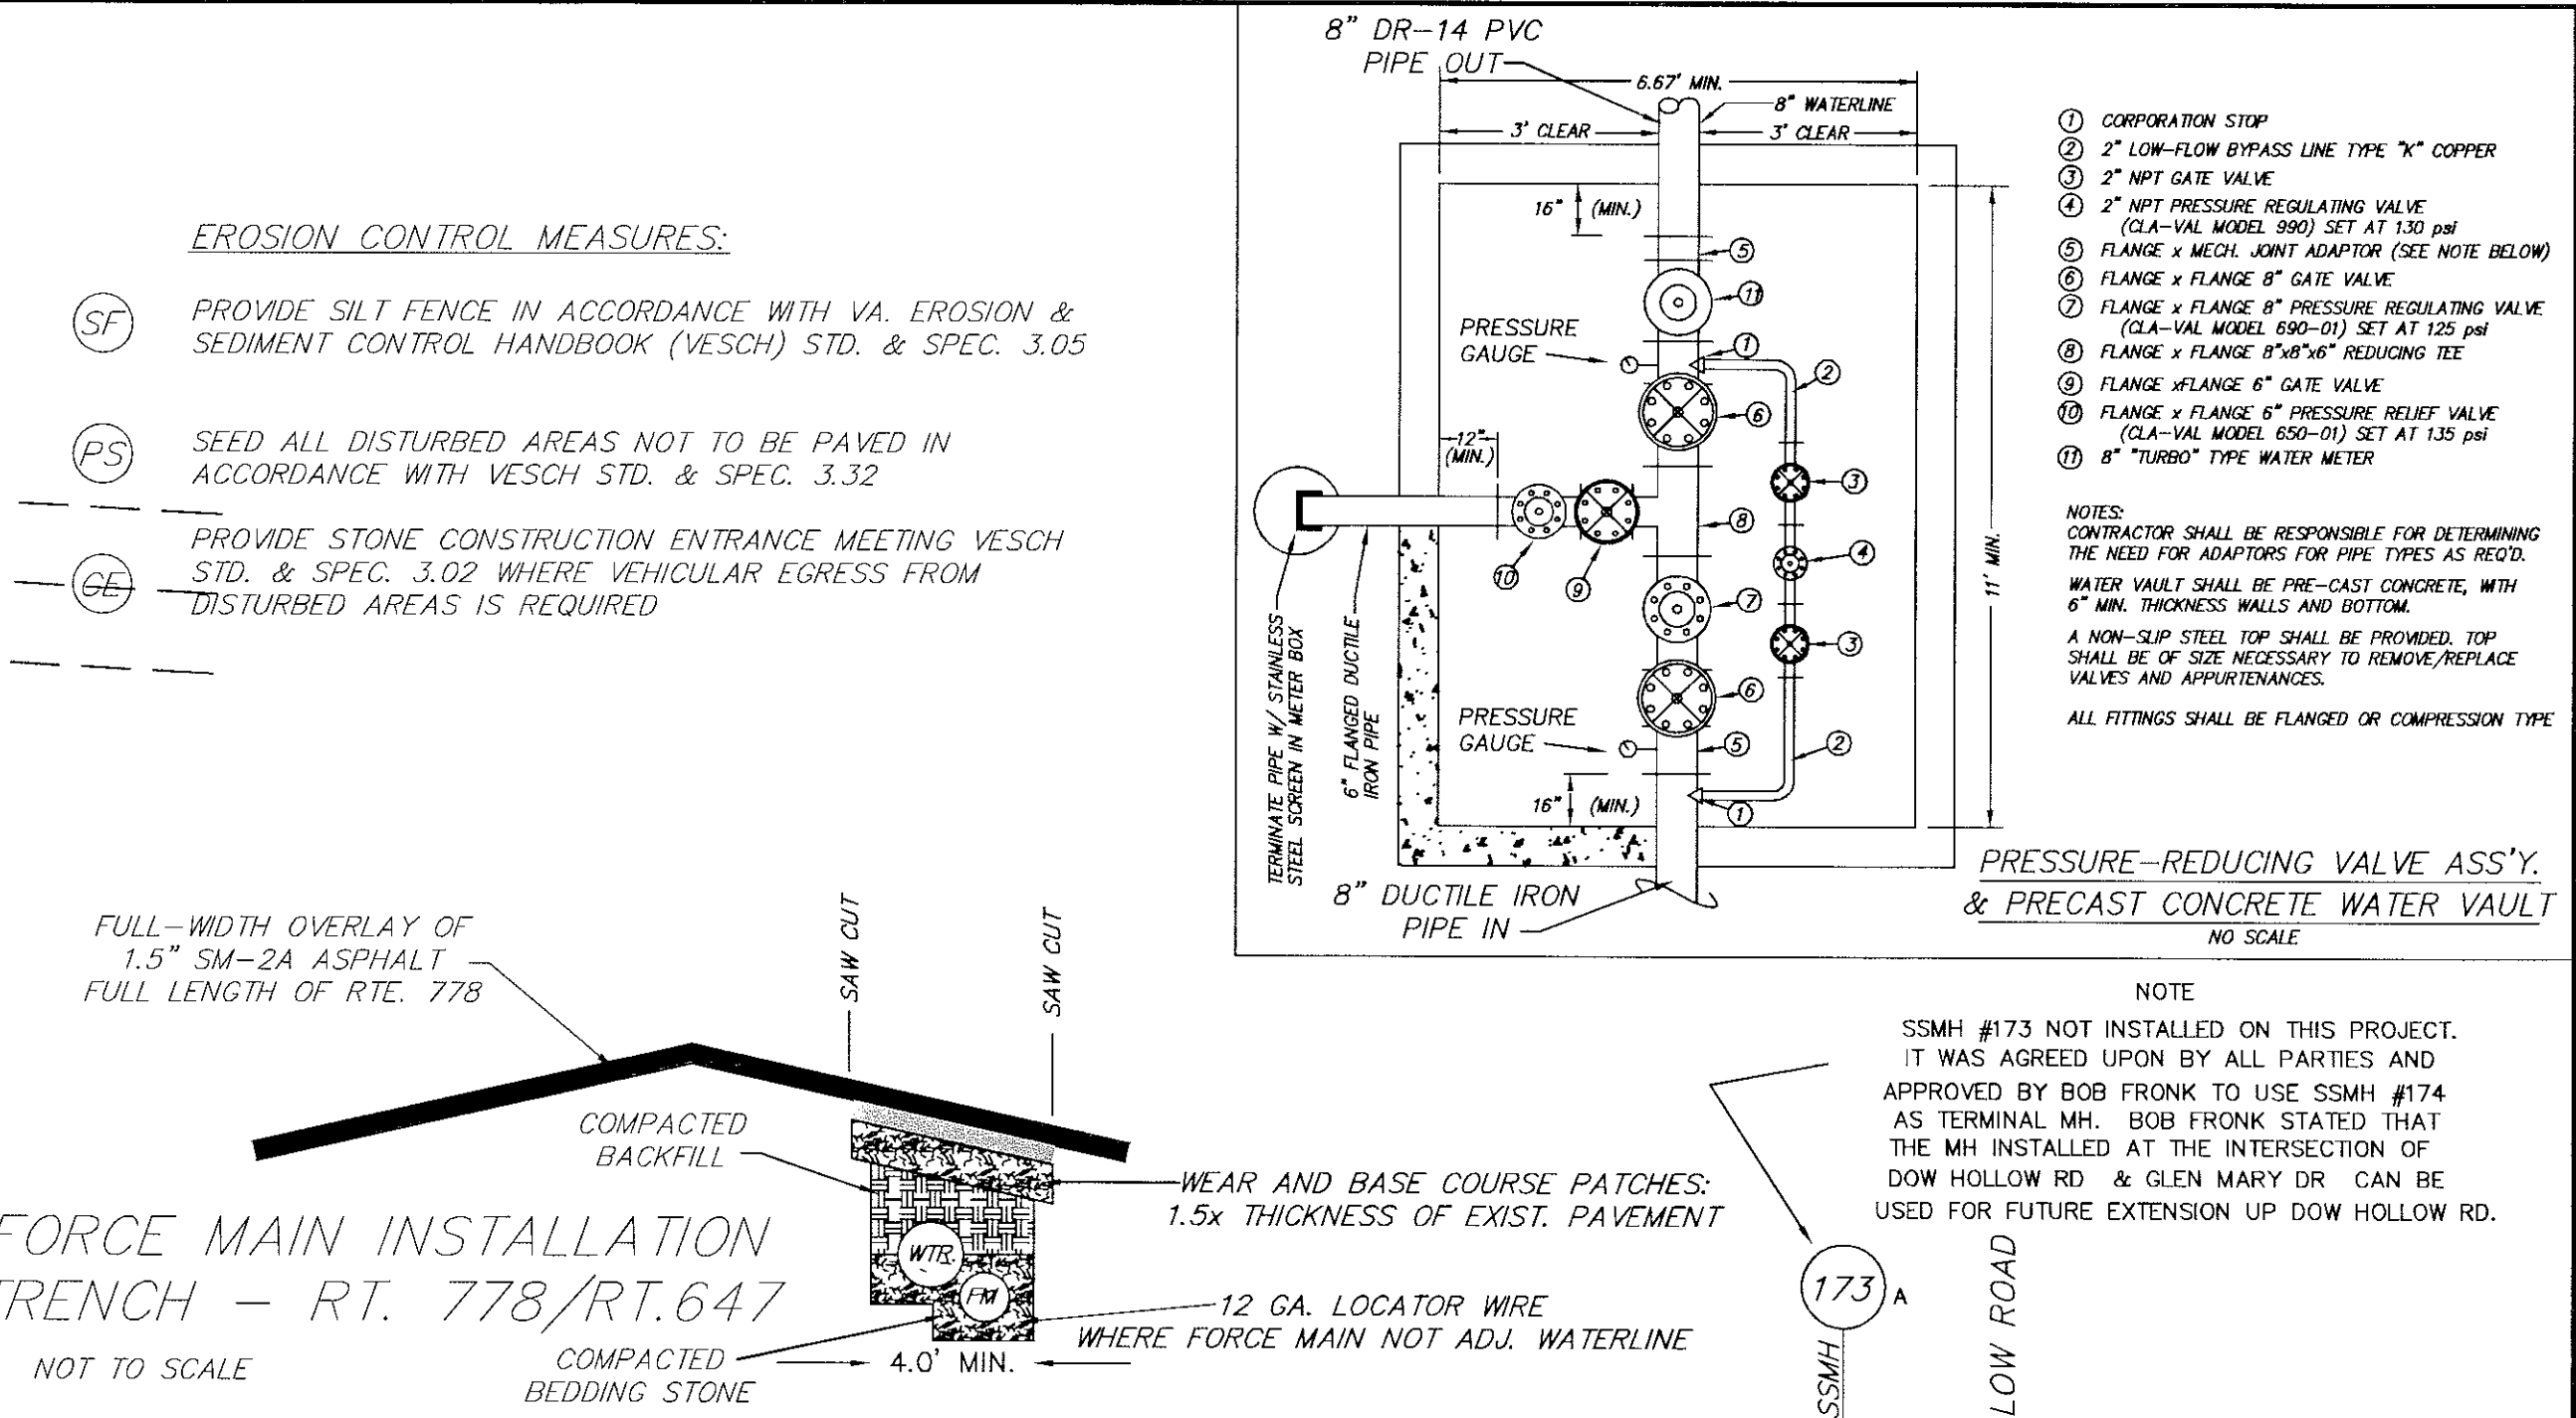

“AS BUILT”

—NOTE—

DRAWING IS NOT TO SCALE
AND PROFILE DOES NOT REFLECT
THE NEW LOCATION OF WATER
AND SEWER LINES

[illegible]