
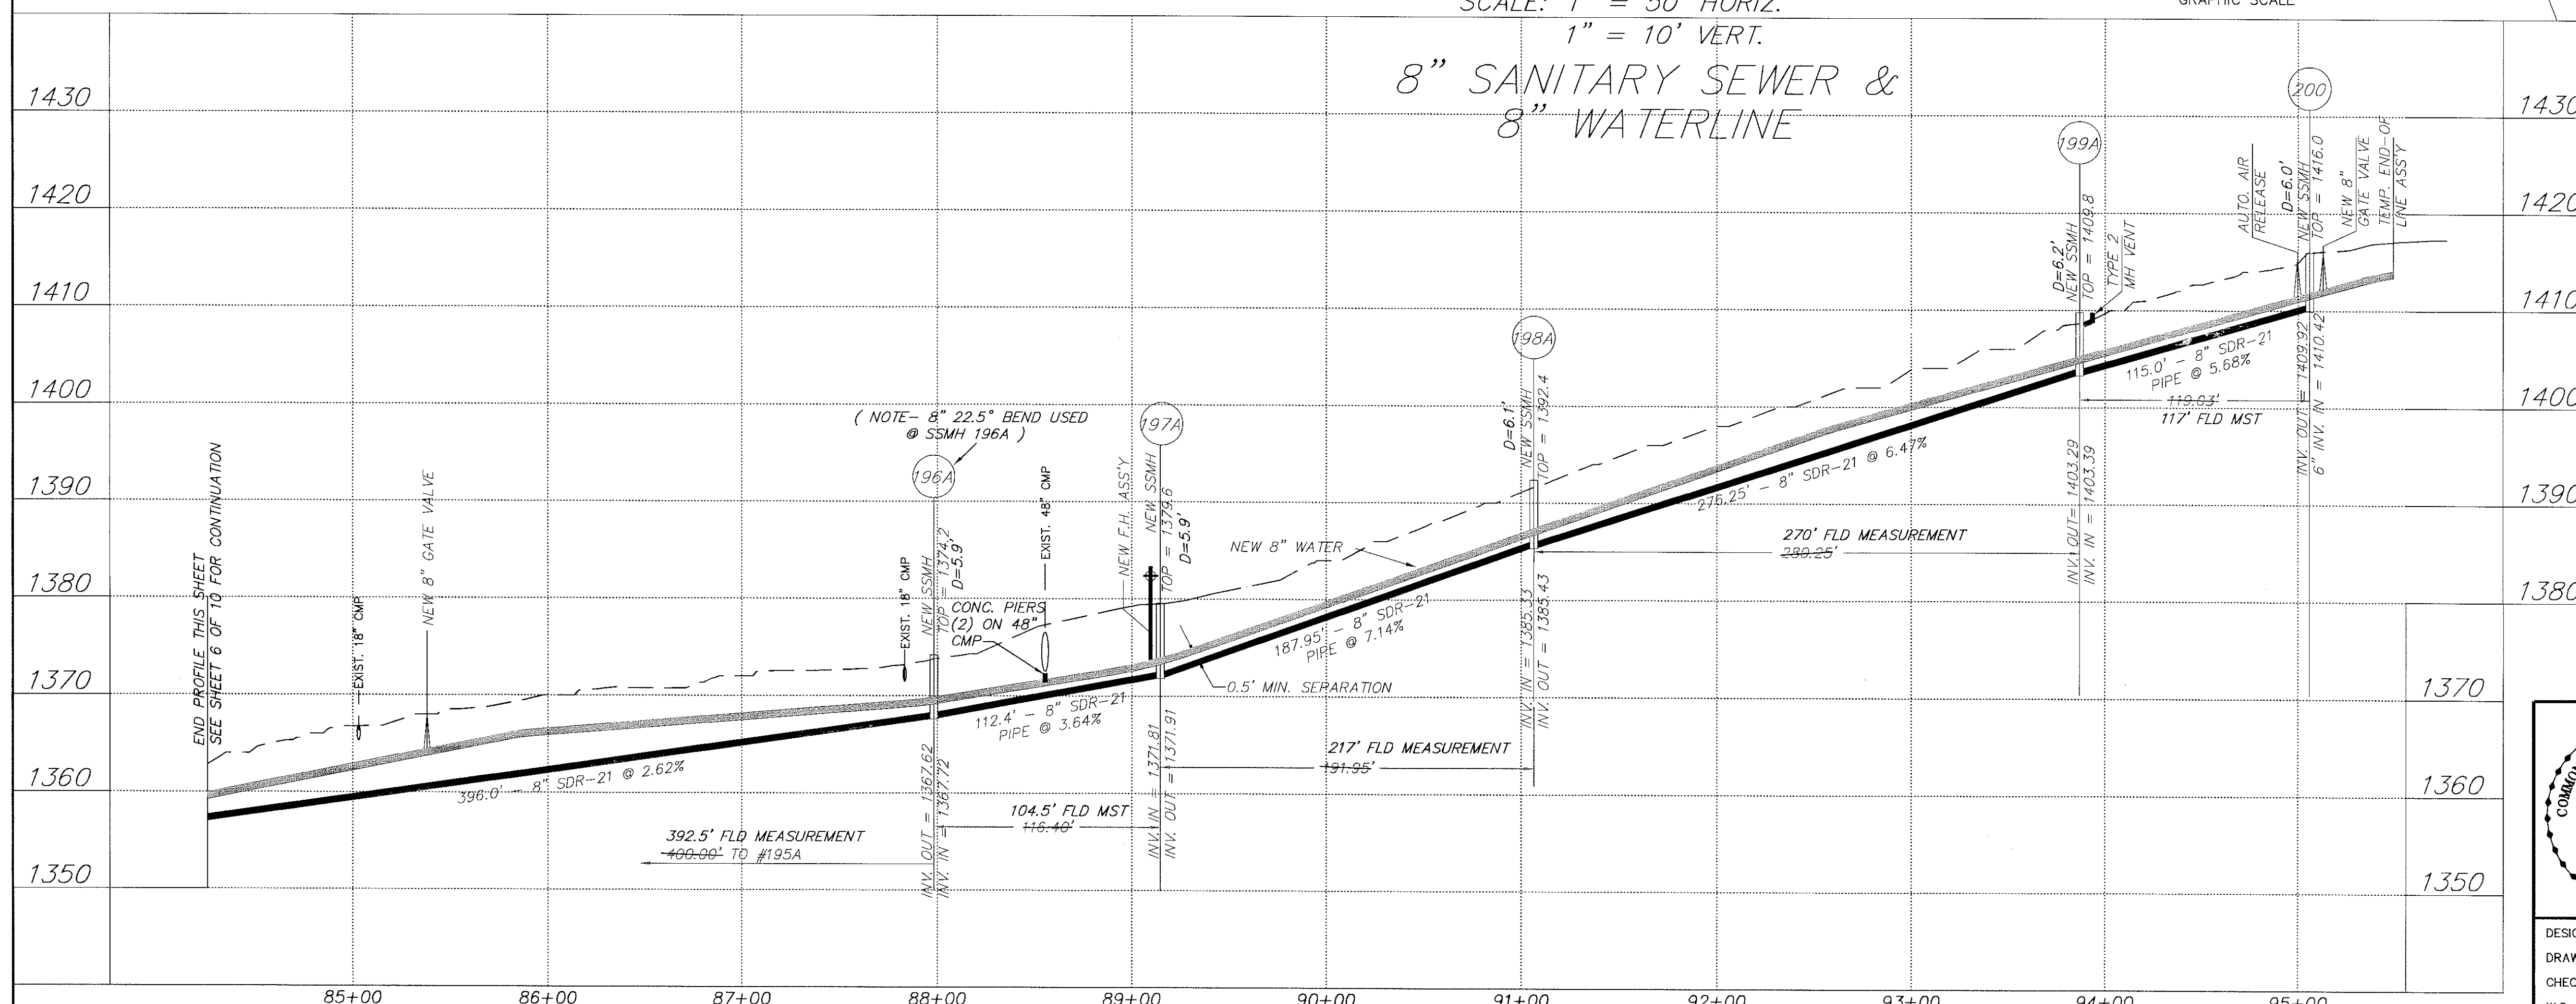


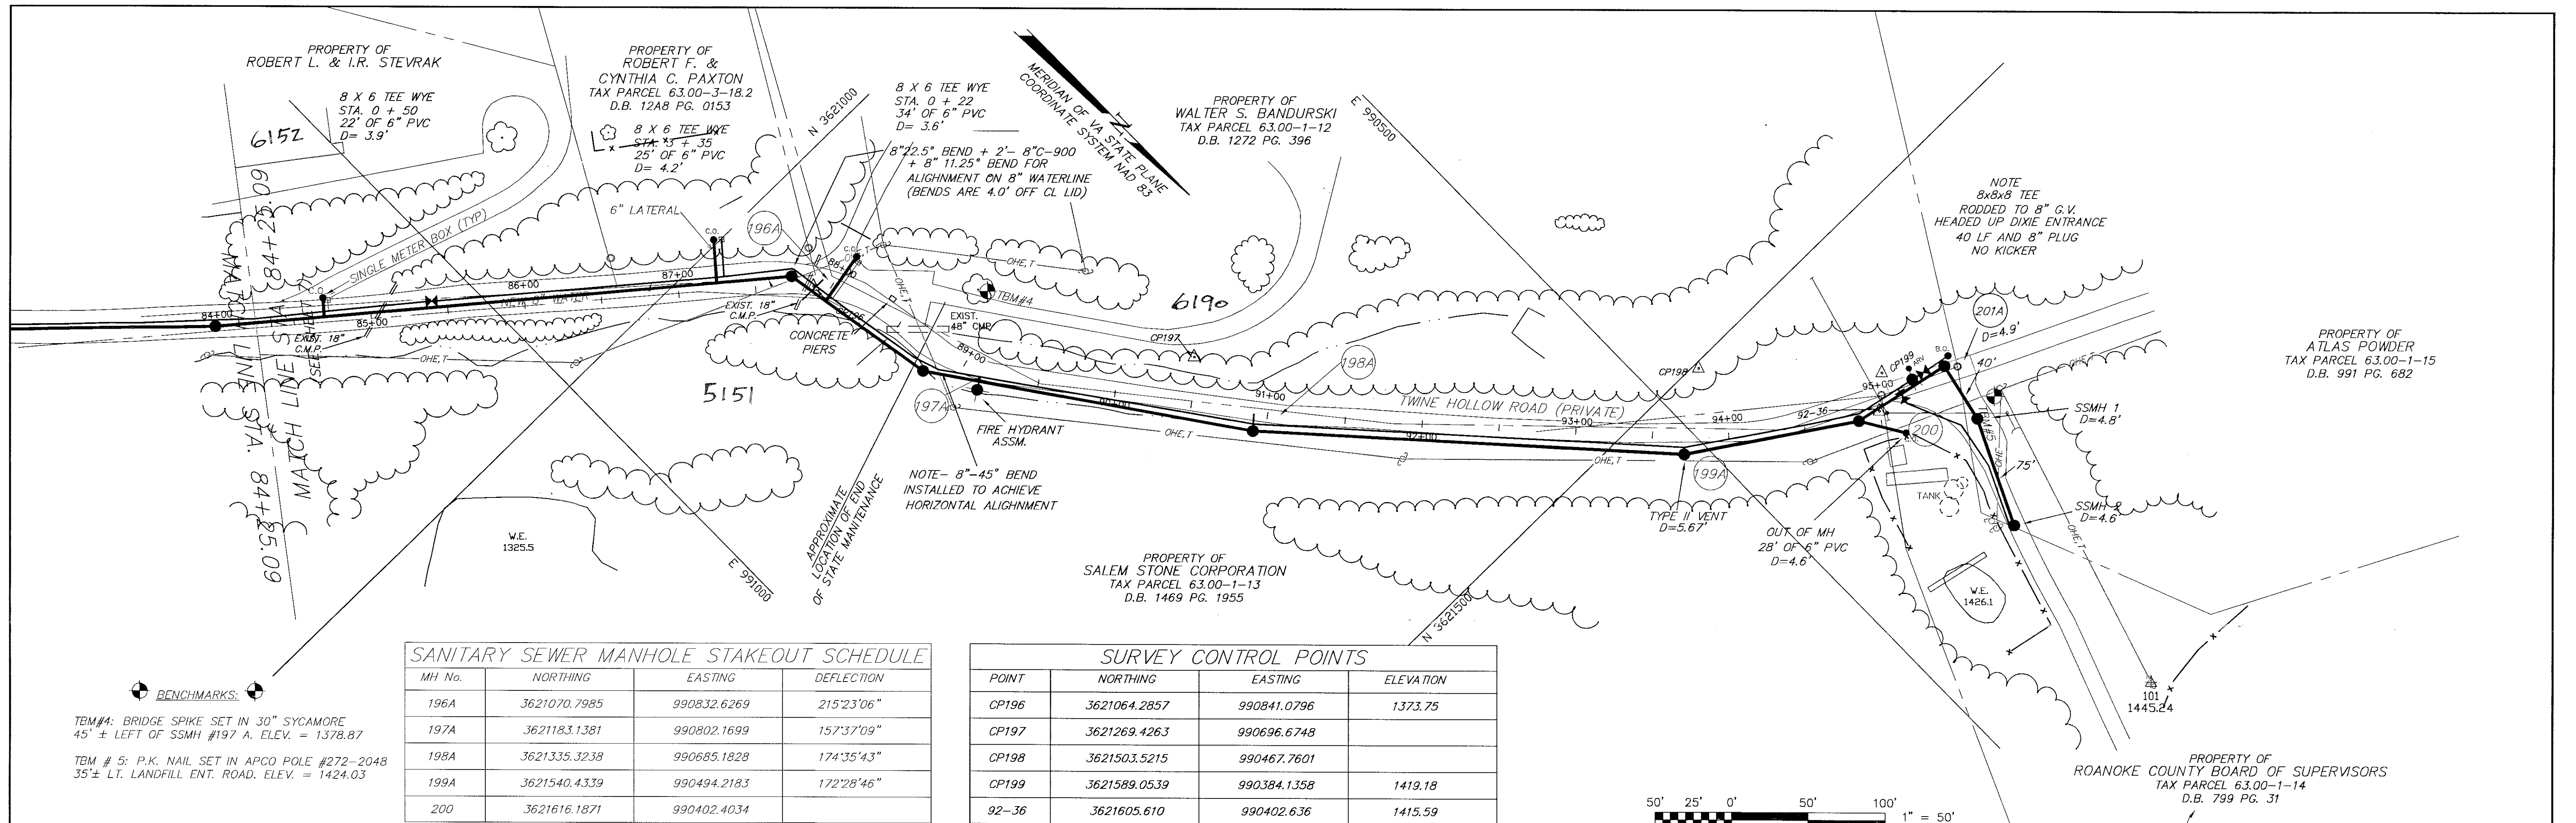

REVISED 5/17/00 - "AS BUILT"
 REVISED 4/14/98 - LOCATION OF MANHOLE #200

COMMONWEALTH OF VIRGINIA
 JOHN T. PARKER
 CERTIFICATE NO. 5447
 PROFESSIONAL ENGINEER

SANITARY SEWER & WATERLINE PLAN & PROFILE
 FOR
 TWINE HOLLOW WATERLINE & SANITARY
 SEWER EXTENSION
COUNTY OF ROANOKE
 SITUATE DOW HOLLOW ROAD AND TWINE HOLLOW
 ROAD NEAR INTERSTATE 81
 COUNTY OF ROANOKE, VIRGINIA
 CATAWBA MAGISTERIAL DISTRICT

T. P. PARKER & SON
 816 Boulevard
 Post Office Box 39
 Salem, Virginia 24153
 Telephone: 540-387-1153
 FAX: 540-389-5787

DESIGNED BY: J.M. SCHULTHEIS
 DRAWN BY: J.M. SCHULTHEIS
 CHECKED BY: J.T. PARKER
 W.D. #: 98-0335
 N.B.: RKE CO. PRO. #2
 TAX NO.:
 DATE: FEB. 2, 1998

SCALE: 1" = 50' DATE: FEBRUARY 2, 1997