



ARCHITECTURE
ENGINEERING
PLANNING

310 First Street, Suite 100 P.O. Box 2811
760344-1212 Fairfax, VA 22031-1212

RECORD DRAWING

This record drawing has been prepared, in part, based upon information furnished by others. While this information is believed to be reliable, the DESIGN PROFESSIONAL cannot assure its accuracy, thus is not responsible for the accuracy of this record drawing or for any errors or omissions which may have been incorporated into it as a result. Those relying on this record document are advised to obtain independent verification of its accuracy before applying it for any purpose.

PROPERTY OF
SUTTIE U. & ANNIE ECONO
TAX # 6010501
D.B. 973, PAGE. 693
2.13 AC.

PROPERTY OF
SUTTIE U. & ANNIE ECONO
TAX # 6010501
D.B. 973, PAGE. 693
2.13 AC.

12" GATE
S 88°20'43" E 85.98'
EX. IRON PIN



10' GATE
6" CHAIN LINK FENCE
EW#100
DETECTION BASIN
DI#99
DI#100A

10' GATE
6" CHAIN LINK FENCE
EW#100
DETECTION BASIN
DI#99
DI#100A

FOR
COMMONWEALTH OF VA.
DEPT. OF VETERANS' AFFAIRS
AGENCY NO: 131
PROJECT CODE: 131-15112
APPROX. NO: 504669.3
CHAPTER 668:1989
FAI # 51-001

DIMENSIONAL
LAYOUT &
UTILITY
PLAN

Commission No. 19010100
Sheet No. 19010100
Scale 1"=40'-0"
C2-1

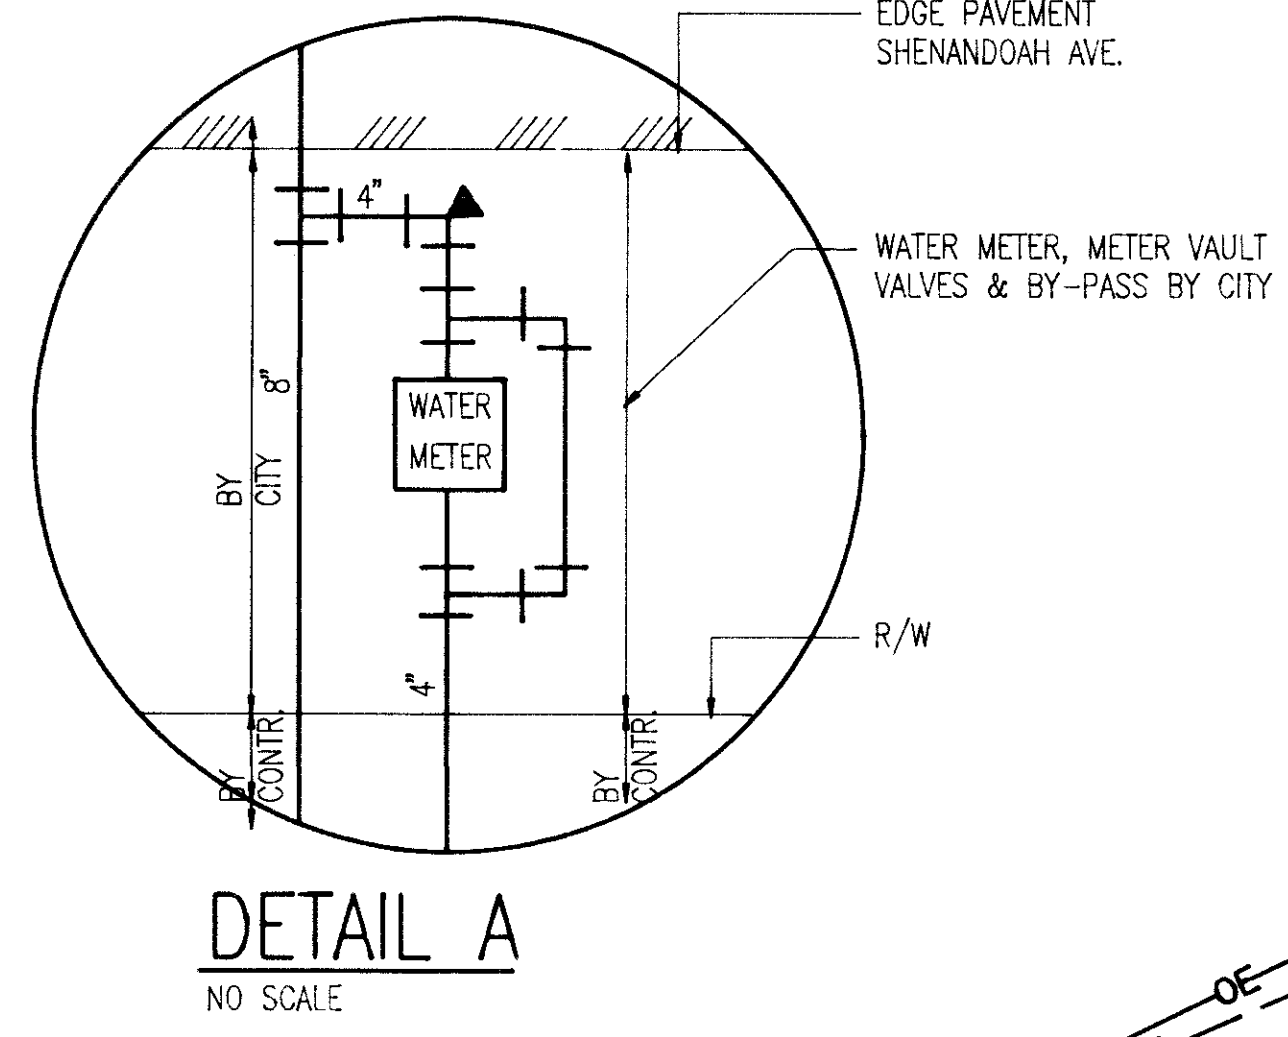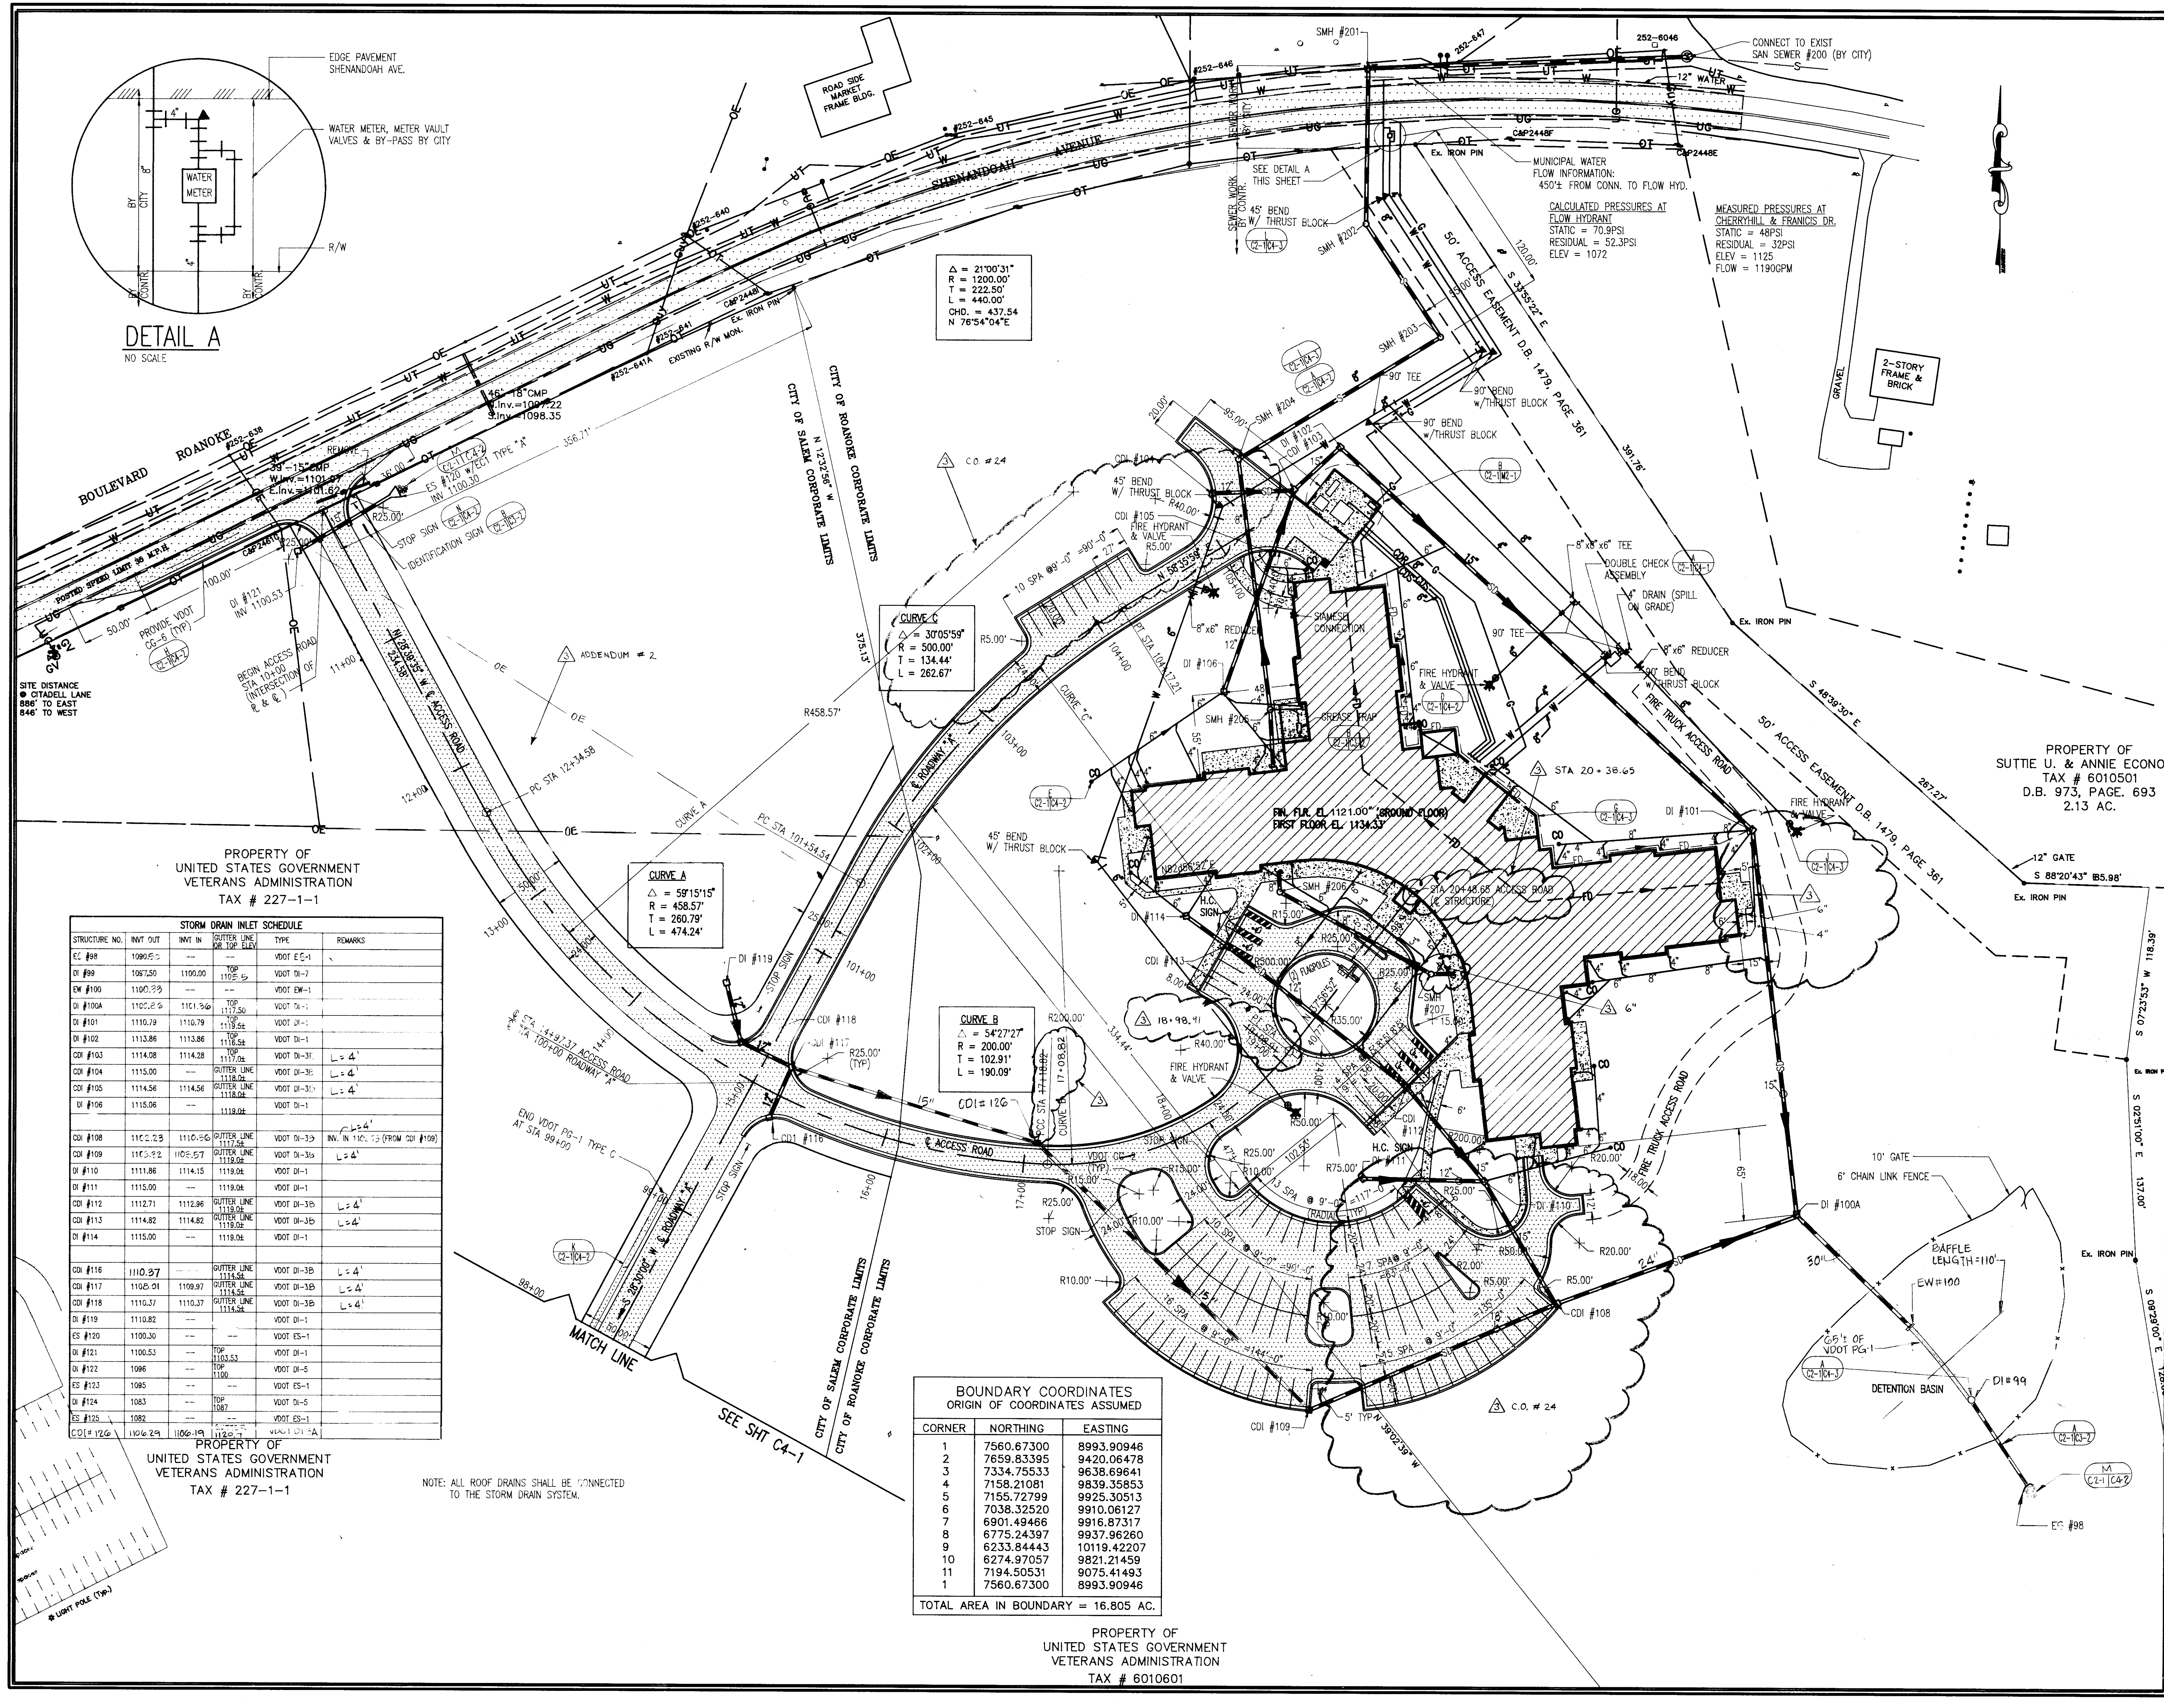

STRUCTURE NO.	INVT OUT	INVT IN	TYPE	REMARKS
CDI #98	1090.55	---	VOOT DI-1	
DI #99	1087.50	1100.00	VOOT DI-7	
EW #100	1100.33	---	VOOT DI-1	
DI #100A	1102.25	1101.30	VOOT DI-1	
DI #101	1110.79	1110.79	VOOT DI-1	
DI #102	1113.86	1113.86	VOOT DI-1	
CDI #103	1114.08	1114.28	VOOT DI-31	L=4'
CDI #104	1115.00	---	VOOT DI-31	L=4'
CDI #105	1114.56	1114.56	VOOT DI-31	L=4'
DI #106	1115.06	---	VOOT DI-1	
CDI #108	1115.23	1115.50	VOOT DI-31	L=4'
CDI #109	1115.57	1115.57	VOOT DI-31	L=4'
DI #110	1115.86	1114.15	VOOT DI-1	
DI #111	1115.00	---	VOOT DI-1	
CDI #112	1112.71	1112.96	VOOT DI-31	L=4'
CDI #113	1114.82	1114.82	VOOT DI-31	L=4'
DI #114	1115.00	---	VOOT DI-1	
CDI #116	1110.37	1114.54	VOOT DI-31	L=4'
CDI #117	1110.37	1110.37	VOOT DI-31	L=4'
CDI #118	1110.37	1110.37	VOOT DI-31	L=4'
DI #119	1110.82	---	VOOT DI-1	
ES #120	1100.30	---	VOOT DI-1	
DI #121	1100.53	---	VOOT DI-1	
DI #122	1096	---	VOOT DI-5	
ES #123	1095	---	VOOT DI-1	
DI #124	1083	---	VOOT DI-5	
ES #125	1082	---	VOOT DI-1	
CDI #126	1106.29	1106.29	VOOT DI-1	

BOUNDARY COORDINATES ORIGIN OF COORDINATES ASSUMED		
CORNER	NORTHING	EASTING
1	7560.67300	8993.90946
2	7659.83395	9420.06478
3	7334.75533	9638.69641
4	7158.21081	9839.35853
5	7155.72799	9925.30513
6	7038.32520	9910.06127
7	6901.49466	9916.87317
8	6775.24397	9937.96260
9	6233.84443	10119.42207
10	6274.97057	9821.21459
11	7194.50531	9075.41493
1	7560.67300	8993.90946
TOTAL AREA IN BOUNDARY = 16.805 AC.		

PROPERTY OF
UNITED STATES GOVERNMENT
VETERANS ADMINISTRATION
TAX # 227-1-1

PROPERTY OF
UNITED STATES GOVERNMENT
VETERANS ADMINISTRATION
TAX # 227-1-1

NOTE: ALL ROOF DRAINS SHALL BE CONNECTED
TO THE STORM DRAIN SYSTEM.

PROPERTY OF
UNITED STATES GOVERNMENT
VETERANS ADMINISTRATION
TAX # 6010601