


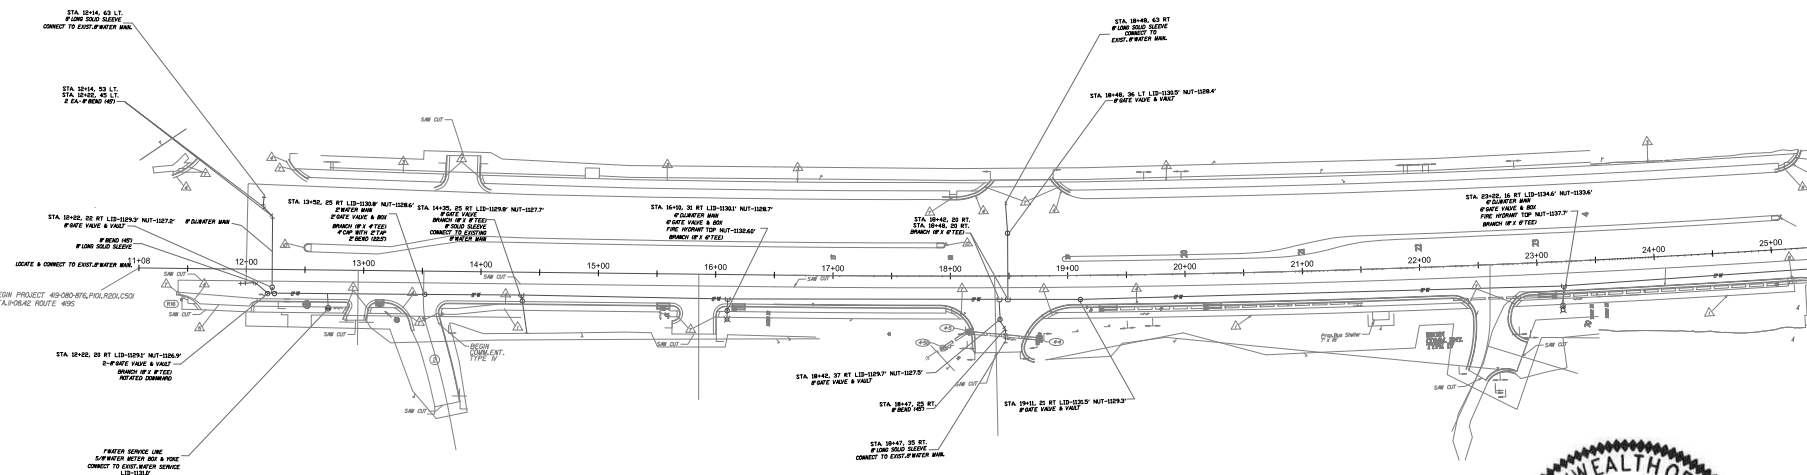
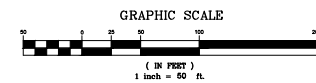





WATERLINE AS BUILT

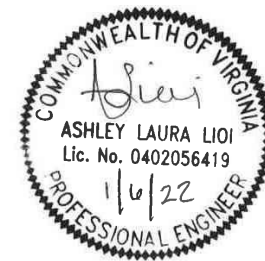

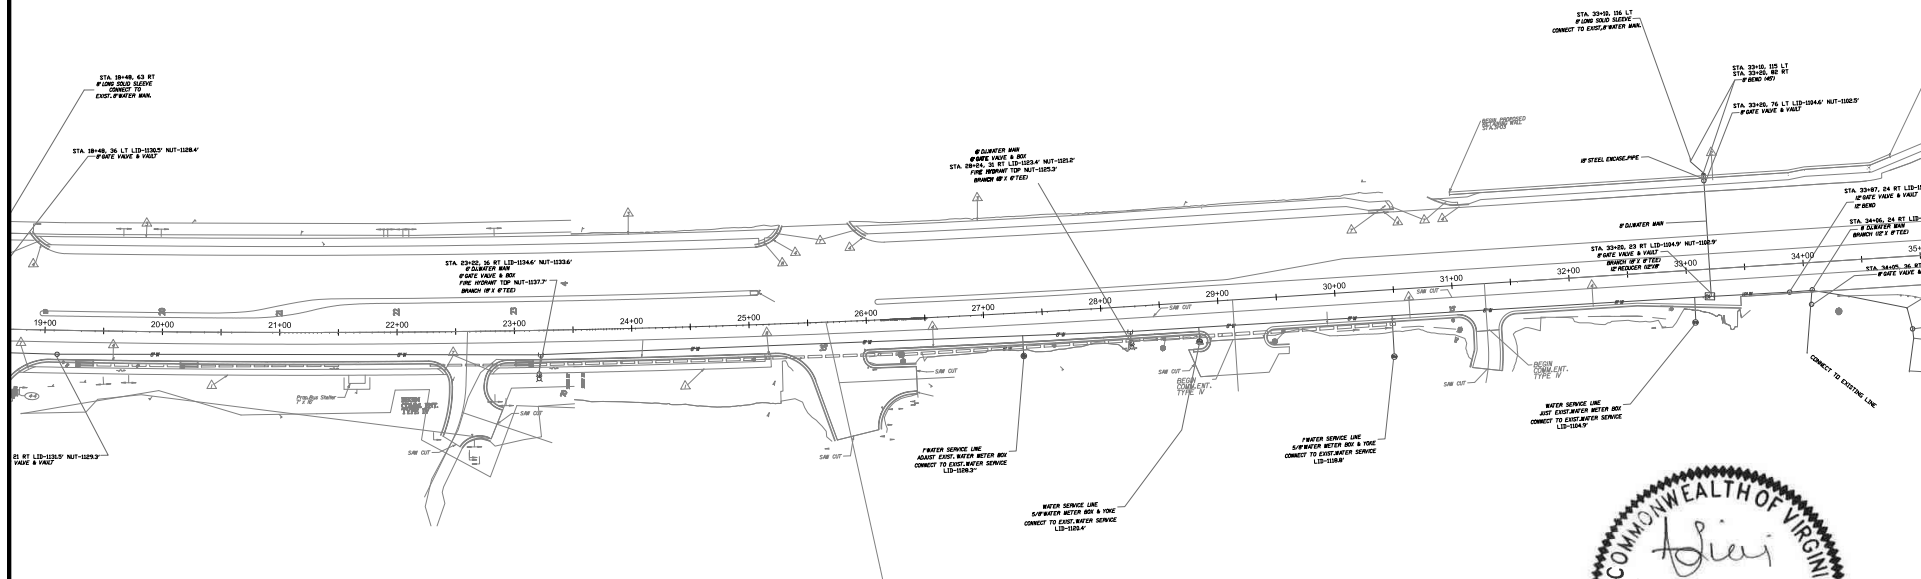


WATERLINE AS BUILT

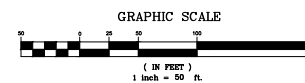

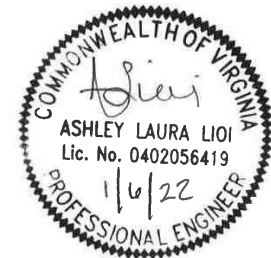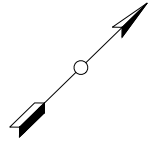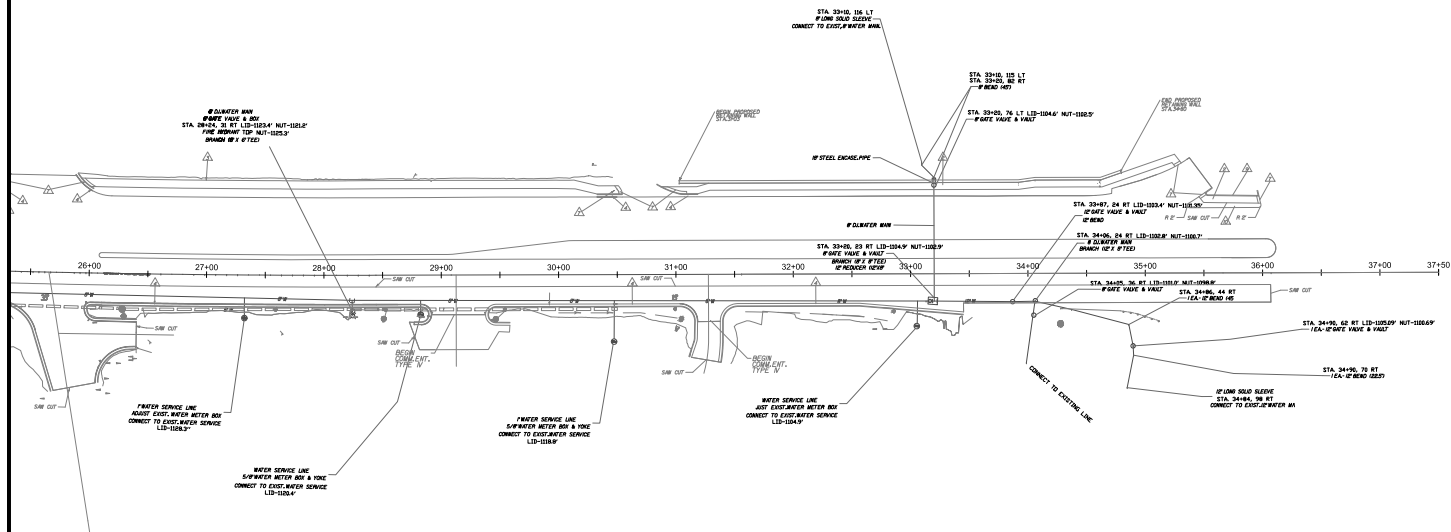

WATERLINE AS BUILT

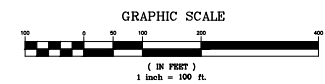[illegible]