



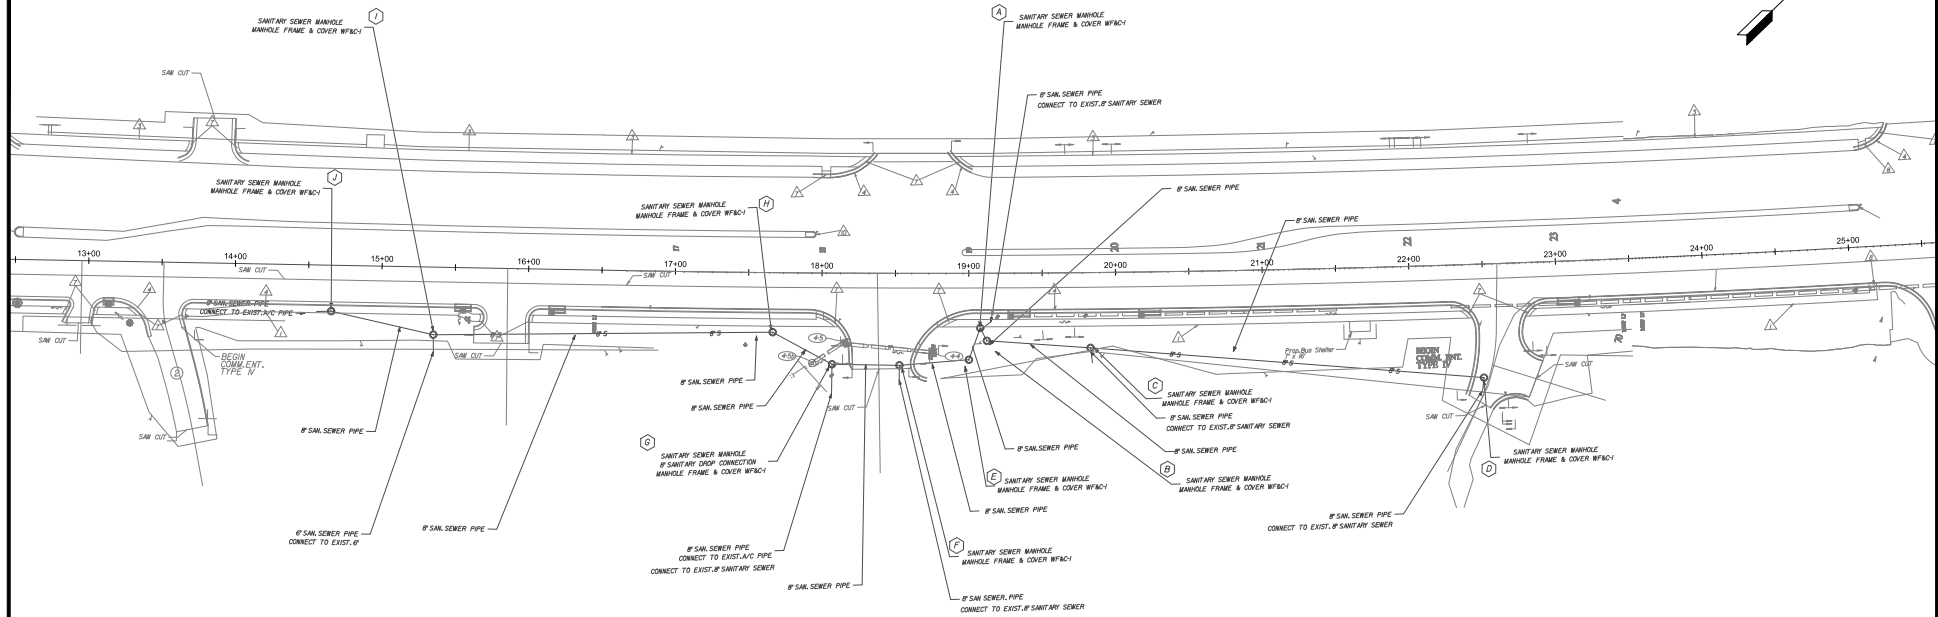

Sewer As-Built Elevations

STR #/DESCRIPTION	TOP	INV IN	INV OUT
J	1129.84	1127.35	1127.20
I	1131.34	1126.85	1126.75
I FROM SOUTH (EXISTING)		1127.10	
H	1133.12	1125.74	1125.67
G	1133.16	1125.42	1125.30
G FROM SOUTH (EXISTING)		1129.20	
F	1132.28	1125.18	1125.09
F FROM SOUTH (EXISTING)		1125.40	
E	1132.46	1123.51	1123.43
A FROM E	1133.38	1122.81	1122.71
A FROM B		1123.16	
B	1132.72	1124.11	1124.04
C	1136.97	1127.41	1127.30
C FROM SOUTH (EXISTING)		1127.45	
D	1140.75	1134.98	1134.59

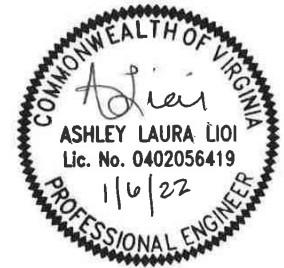

SANITARY SEWER AS BUILT

