


PROJECT MANAGER: Brian Becker, P.E. (540) 387-5049
SURVEYED BY: DATE Christopher B. Kohns, L.S. (540) 552-5592 (Hurt and Profit)
ROADWAY DESIGN BY: Brett Ellledge, P.E. (540) 375-3580
HYDRAULICS DESIGN BY: Ryan Fedak, P.E. (540) 857-3349 (AECOM)
SUBSURFACE UTILITY BY: DATE Gary Campbell, P.E. (757) 499-1895 (JMT, Inc.)
UTILITY DESIGN BY: Whitman Reardon & Associates, LLP (540) 951-3727

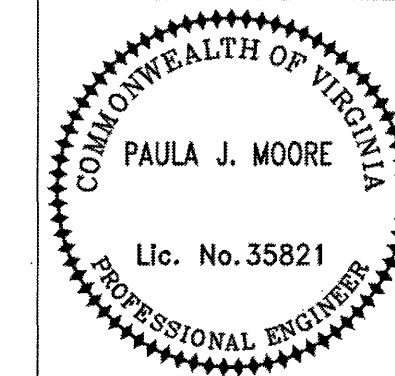


Paula J. Moore
Whitman Reardon & Associates
Blacksburg, Virginia
UTILITIES ENGINEER

REVISED	STATE	ROUTE	PROJECT	SHEET NO.
	VA.	419	0419-080-876, C501	8(6)

DESIGN FEATURES RELATING TO CONSTRUCTION OR TO REGULATION AND CONTROL OF TRAFFIC MAY BE SUBJECT TO CHANGE AS DEEMED NECESSARY BY THE DEPARTMENT


- Denotes Concrete Sidewalk
- Denotes 1.5" Mill and Replace of Pavement
- Denotes Proposed Full-Depth Pavement
- Denotes Demolition of Pavement/Curb

UTILITY PLAN, WATER

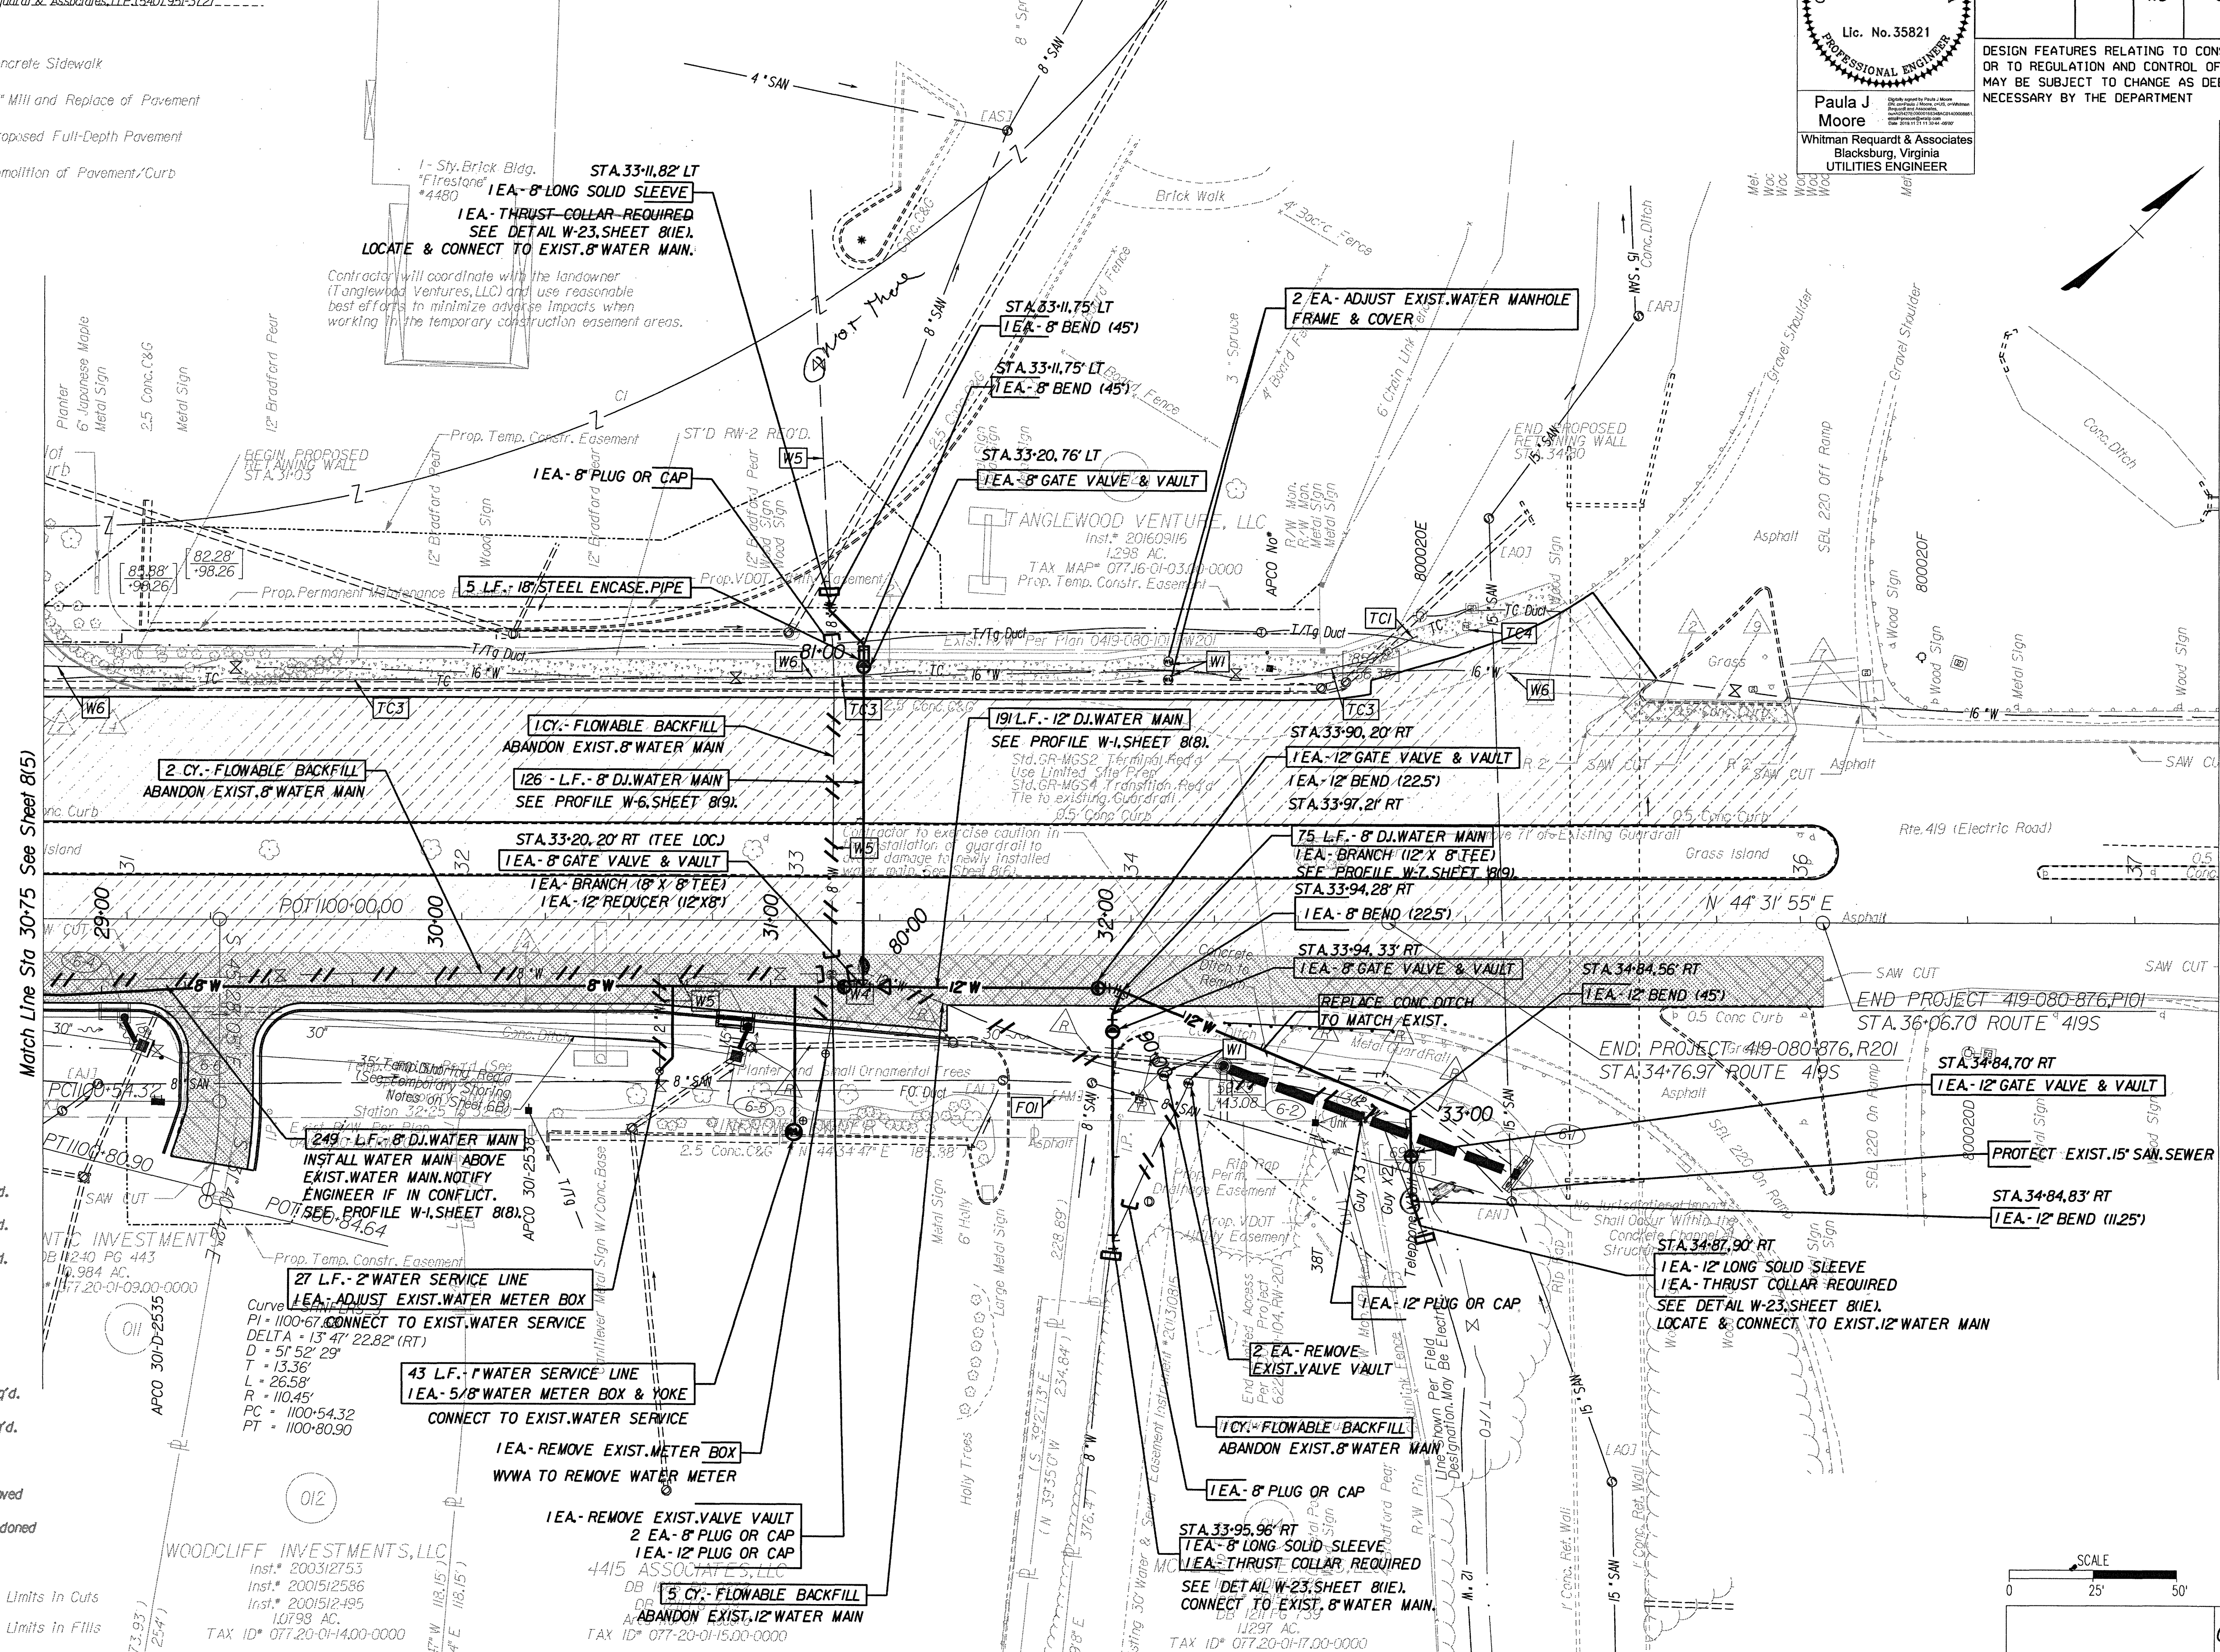

- 5' Conc. Sidewalk Req'd.
- 6' Conc. Sidewalk Req'd.
- 7' Conc. Sidewalk Req'd.
- Sf'd. CG-6 Req'd.
- Sf'd. CG-9 Req'd.
- Sf'd. CG-13 Req'd.
- Sf'd. CG-12, Type B Req'd.
- Sf'd. CG-12, Type C Req'd.
- Sf'd. CG-2 Req'd.
- Structures to be Removed
- Structures to be Abandoned

- Denotes Construction Limits in Cuts
- Denotes Construction Limits in Fills

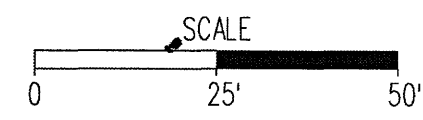

Match Line Sta 37-25 See Sheet 7

PROJECT	SHEET NO.
0419-080-876, C501	8(6)

THIS SHEET FOR UTILITY ADJUSTMENT/RELOCATION ONLY