


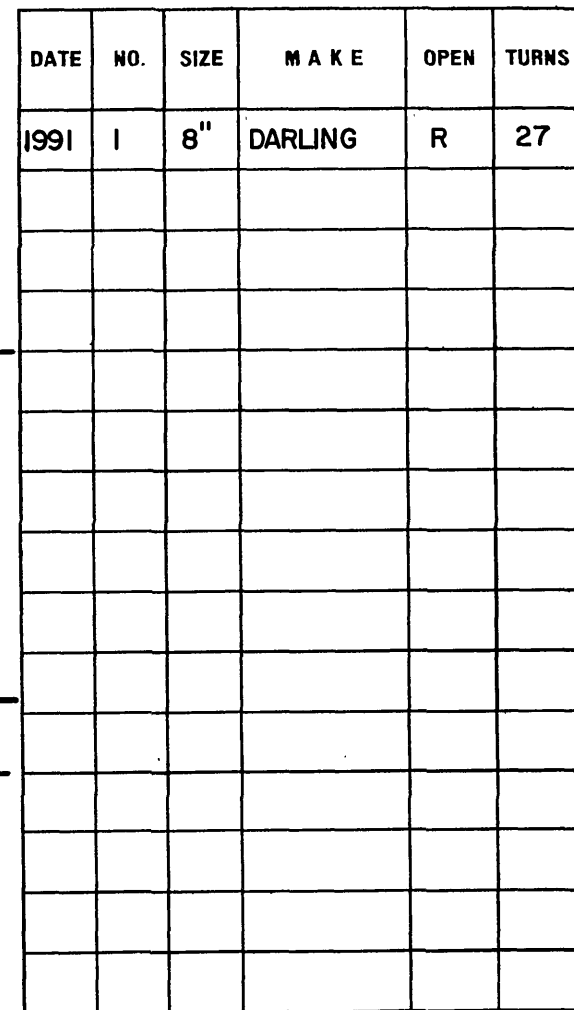

CITY OF ROANOKE—WATER DEPT	
VALVE DIAGRAM	
3347 VALENTINE	AVE. RD.
SEC. MAP 505,518	S.W.
DATE	PAGE NO.