

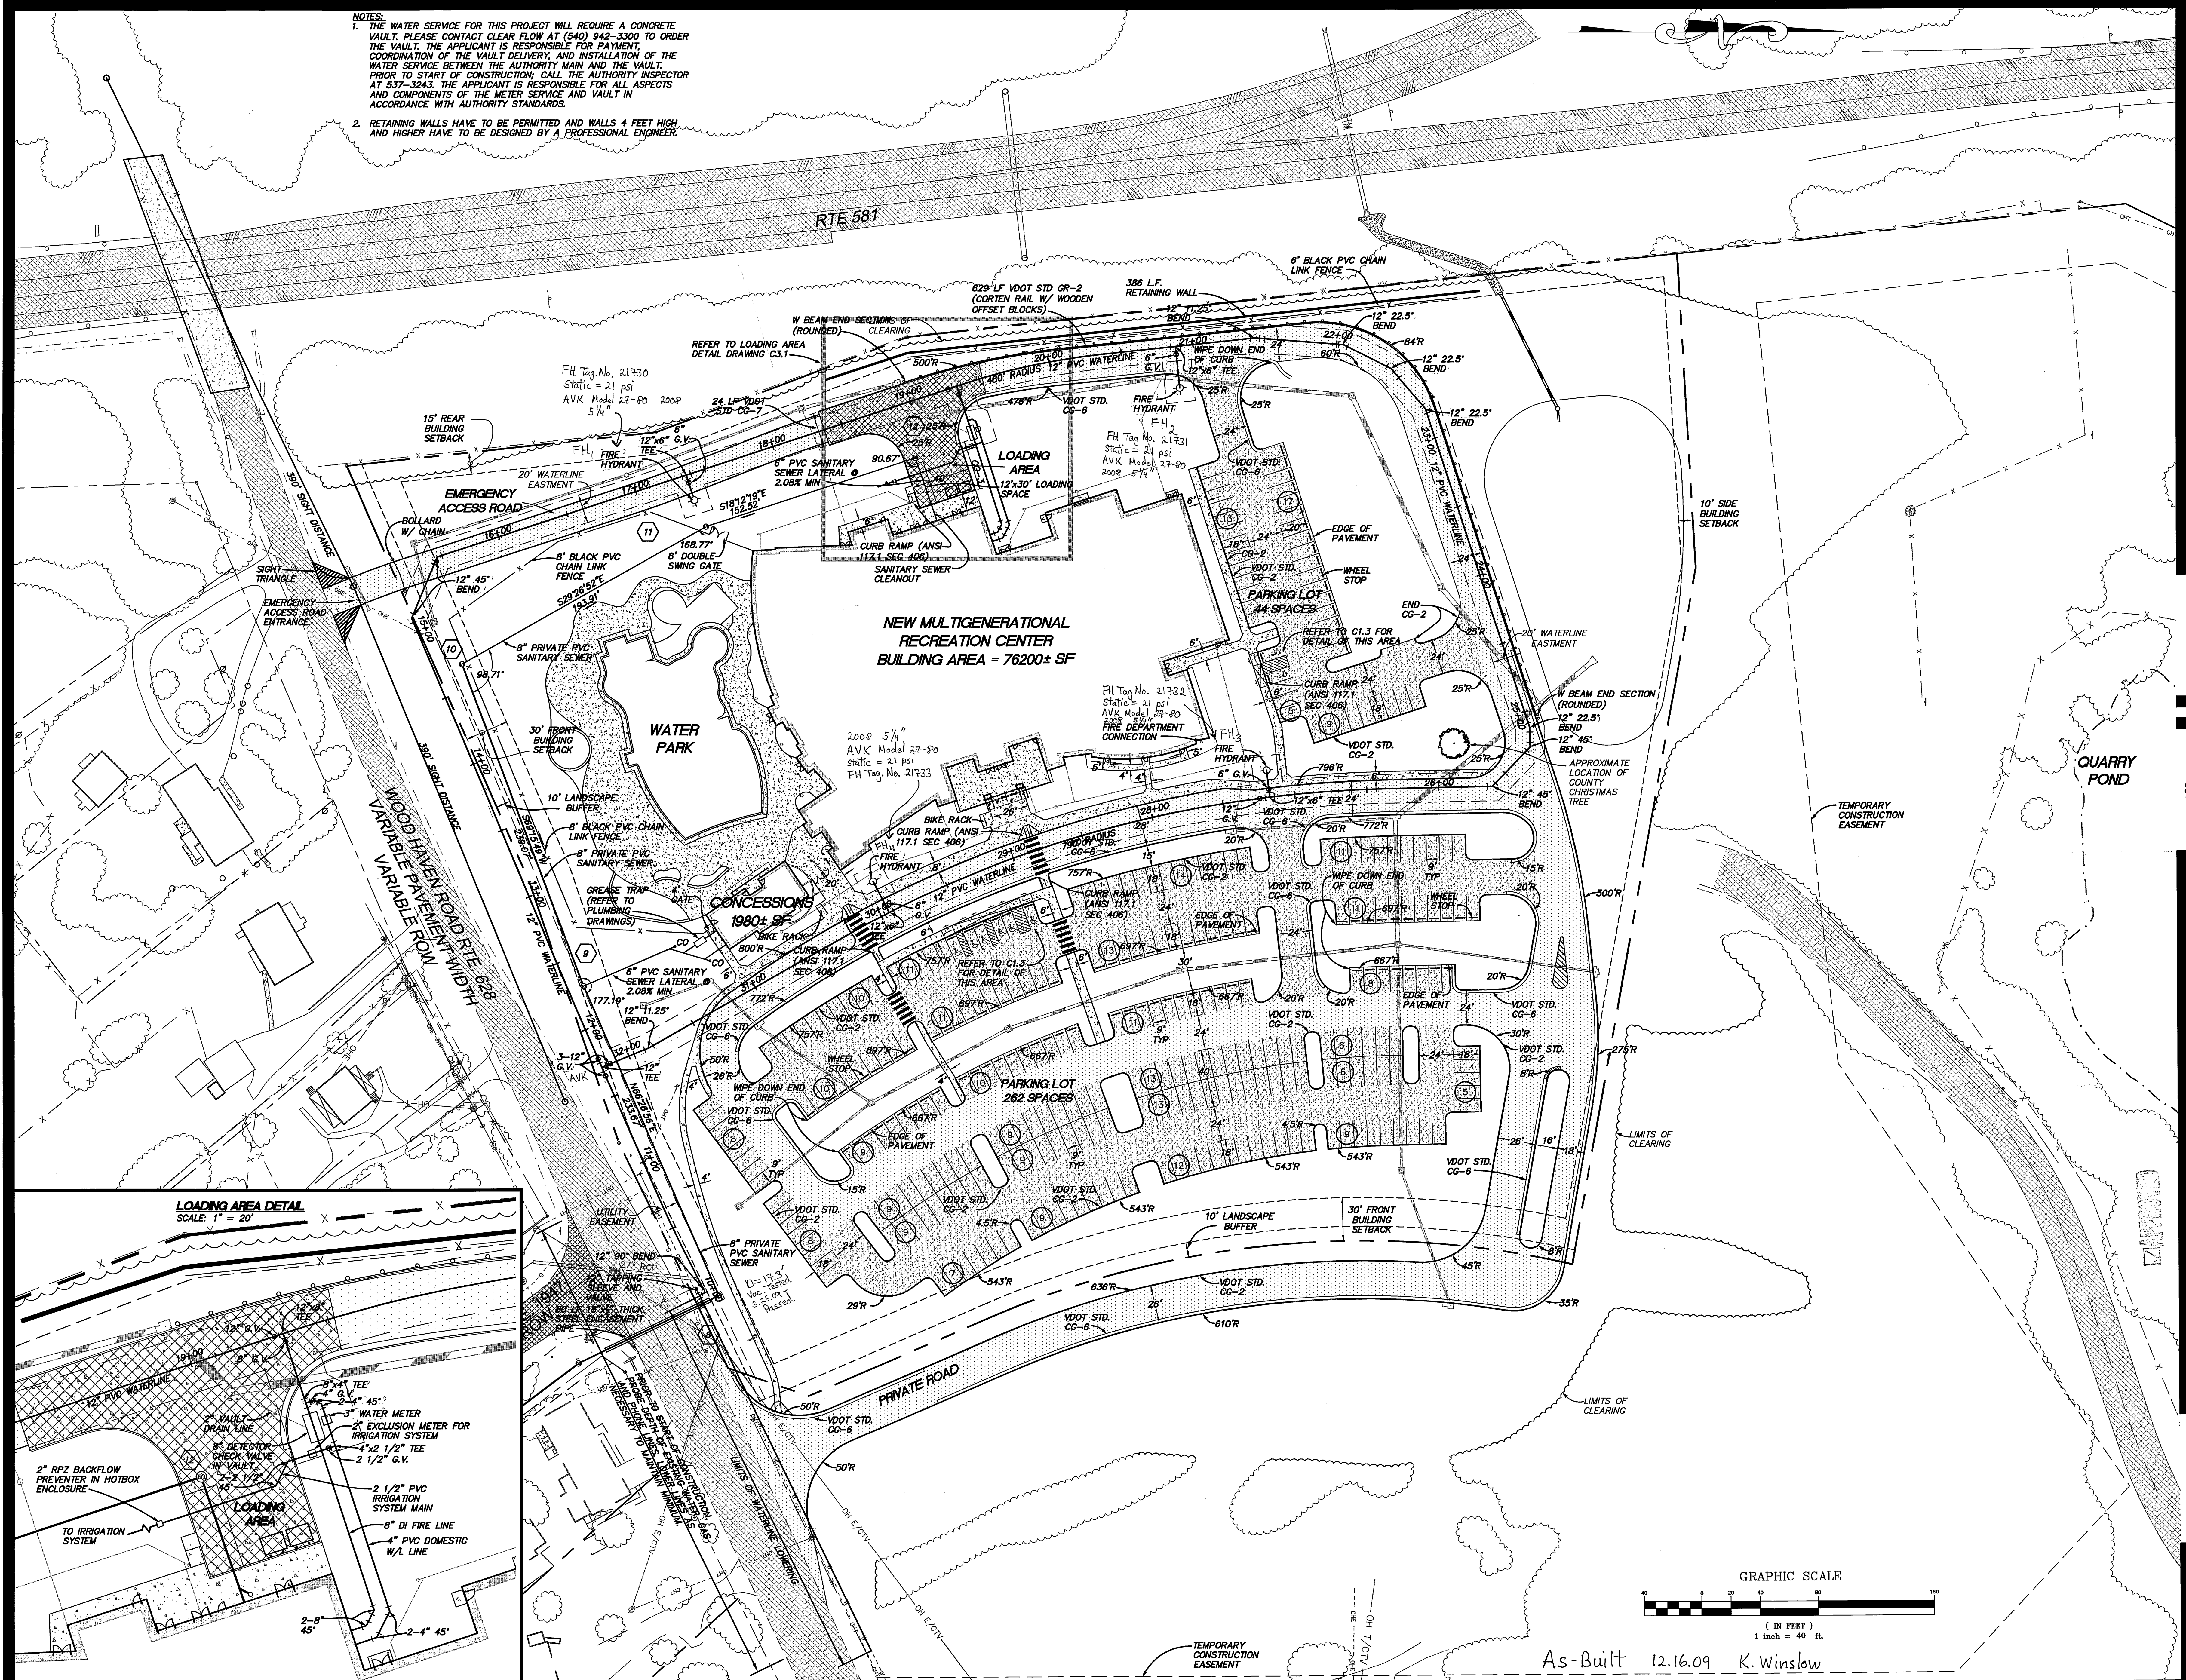


- NOTES:
1. THE WATER SERVICE FOR THIS PROJECT WILL REQUIRE A CONCRETE VAULT. PLEASE CONTACT CLEAR FLOW AT (540) 942-3300 TO ORDER THE VAULT. THE APPLICANT IS RESPONSIBLE FOR PAYMENT, COORDINATION OF THE VAULT DELIVERY, AND INSTALLATION OF THE WATER SERVICE BETWEEN THE AUTHORITY MAIN AND THE VAULT. PRIOR TO START OF CONSTRUCTION, CALL THE AUTHORITY INSPECTOR AT 537-3243. THE APPLICANT IS RESPONSIBLE FOR ALL ASPECTS AND COMPONENTS OF THE METER SERVICE AND VAULT IN ACCORDANCE WITH AUTHORITY STANDARDS.
 2. RETAINING WALLS HAVE TO BE PERMITTED AND WALLS 4 FEET HIGH AND HIGHER HAVE TO BE DESIGNED BY A PROFESSIONAL ENGINEER.

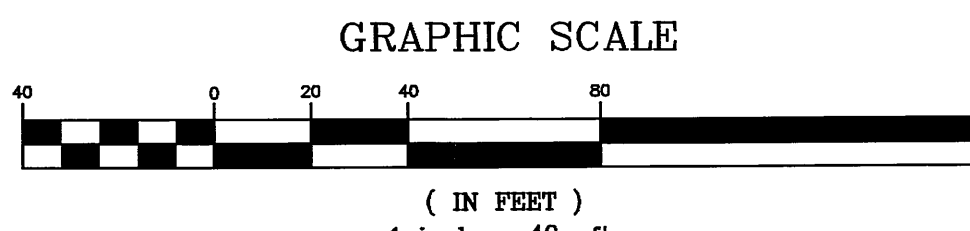

LOADING AREA DETAIL
SCALE: 1" = 20'

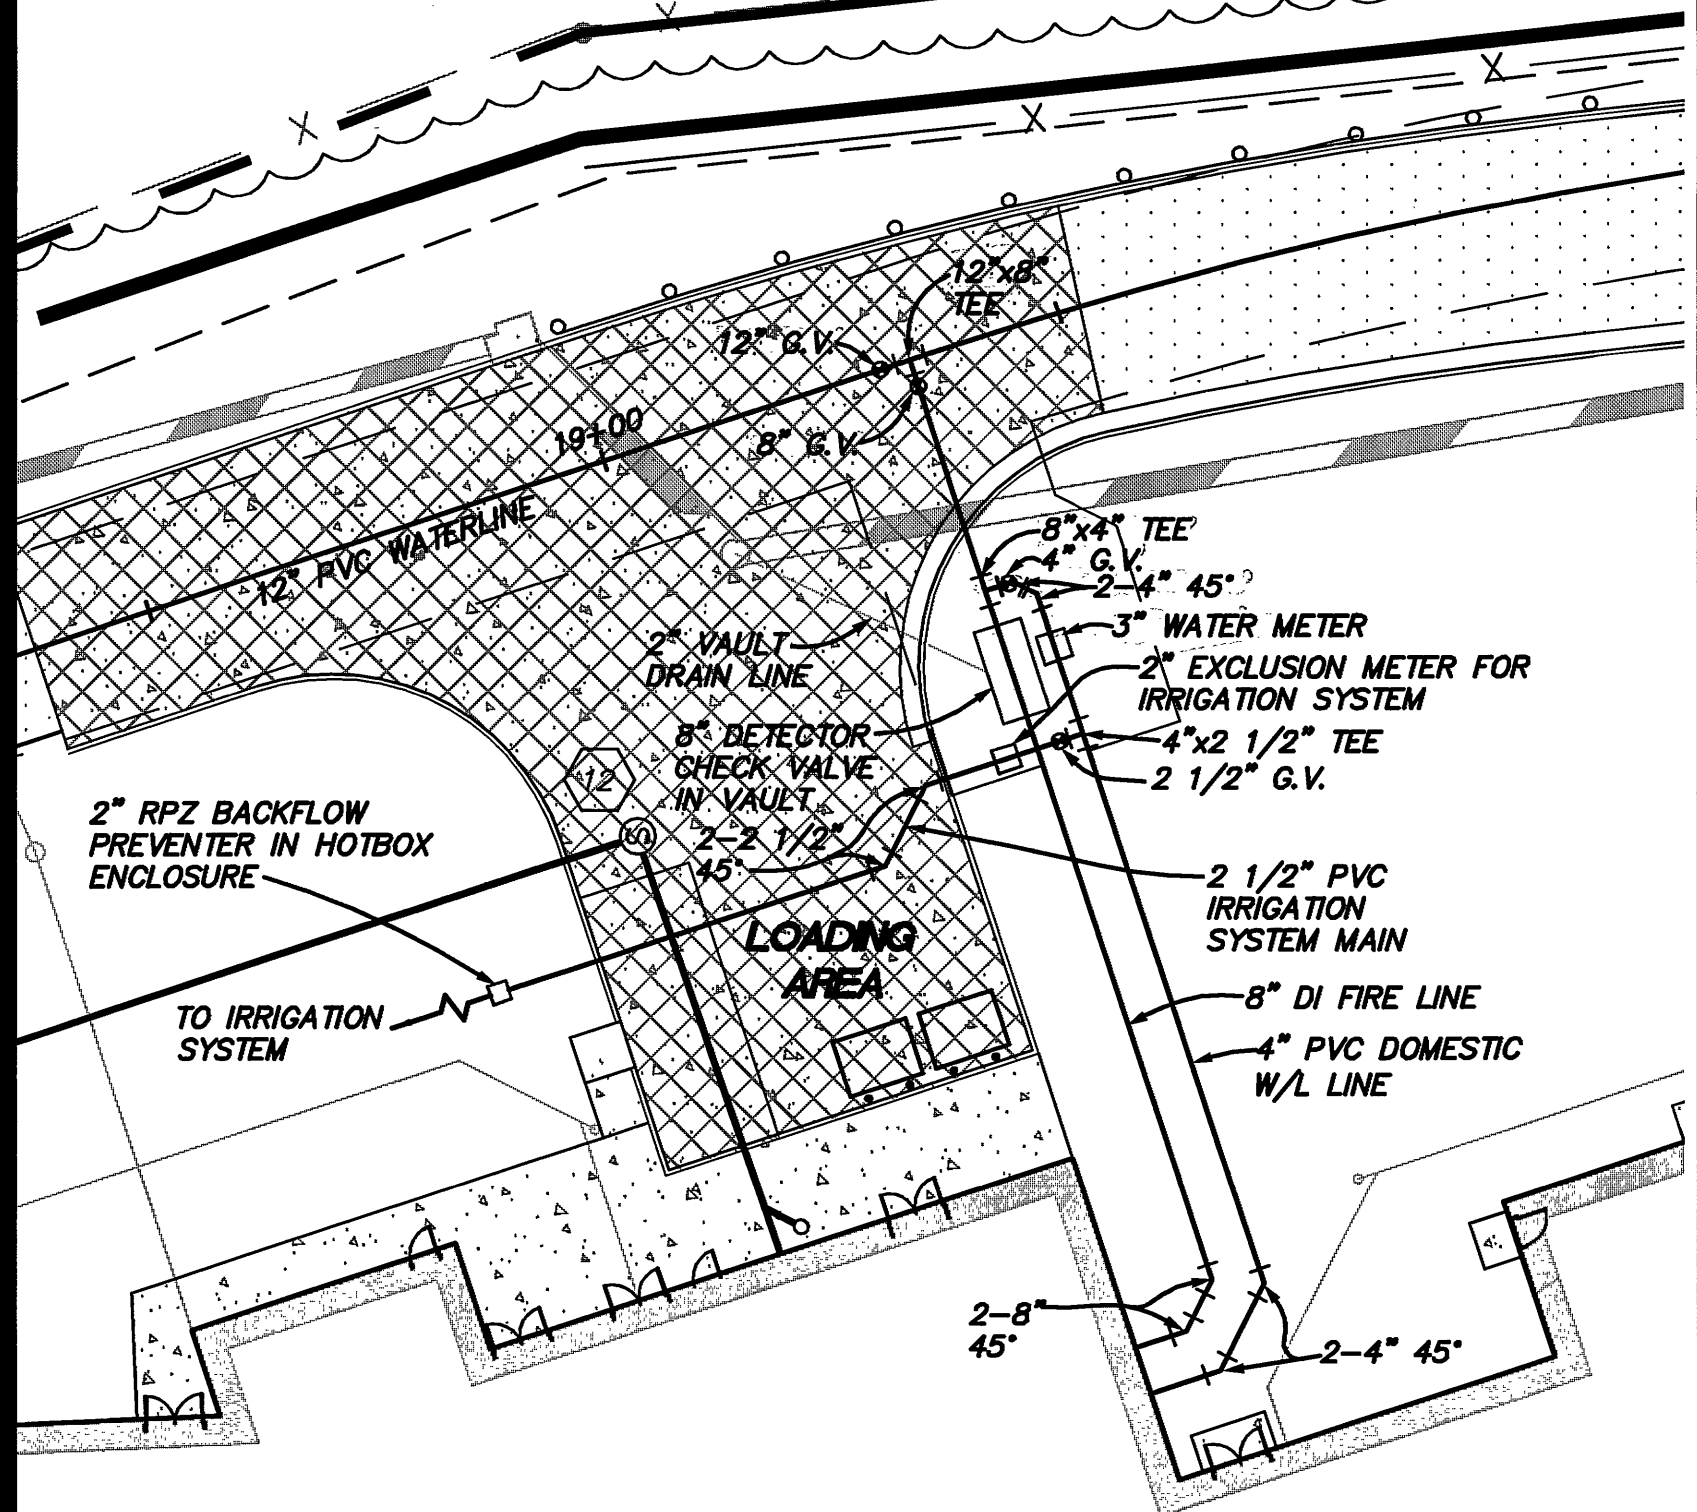


As-Built 12.16.09 K. Winslow

MOSELEYARCHITECTS
A PROFESSIONAL CORPORATION

FIRSTCHOICE
Public-PrivatePartners

601 SOUTHPLANE BOULEVARD, RICHMOND, VIRGINIA, 23266
PHONE (804) 794-1665 FAX (804) 375-6660
MOSELEYARCHITECTS.COM

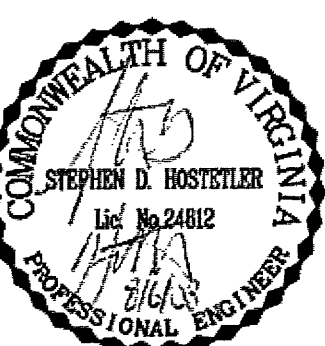

TIMMONS GROUP
YOUR DESIGN ADAPTED THROUGH OUR
EXPERIENCE AND INNOVATION

1100 COMMONWEALTH AVENUE, SUITE 300
FALLS CHURCH, VA 22044
TEL: (703) 441-2200
FAX: (703) 441-2201
WWW.TIMMONSGROUP.COM

**NEW MULTIGENERATIONAL
RECREATION CENTER**
HOLLINS MAGISTERIAL DISTRICT
ROANOKE COUNTY, VIRGINIA

PROJECT NO: 46192D
DATE: JUNE 2, 2008
REVISIONS: AUGUST 6, 2008
DRAWN BY: WJP
CHECKED BY: SEB

LAYOUT AND
UTILITY
PLAN

C3.1