

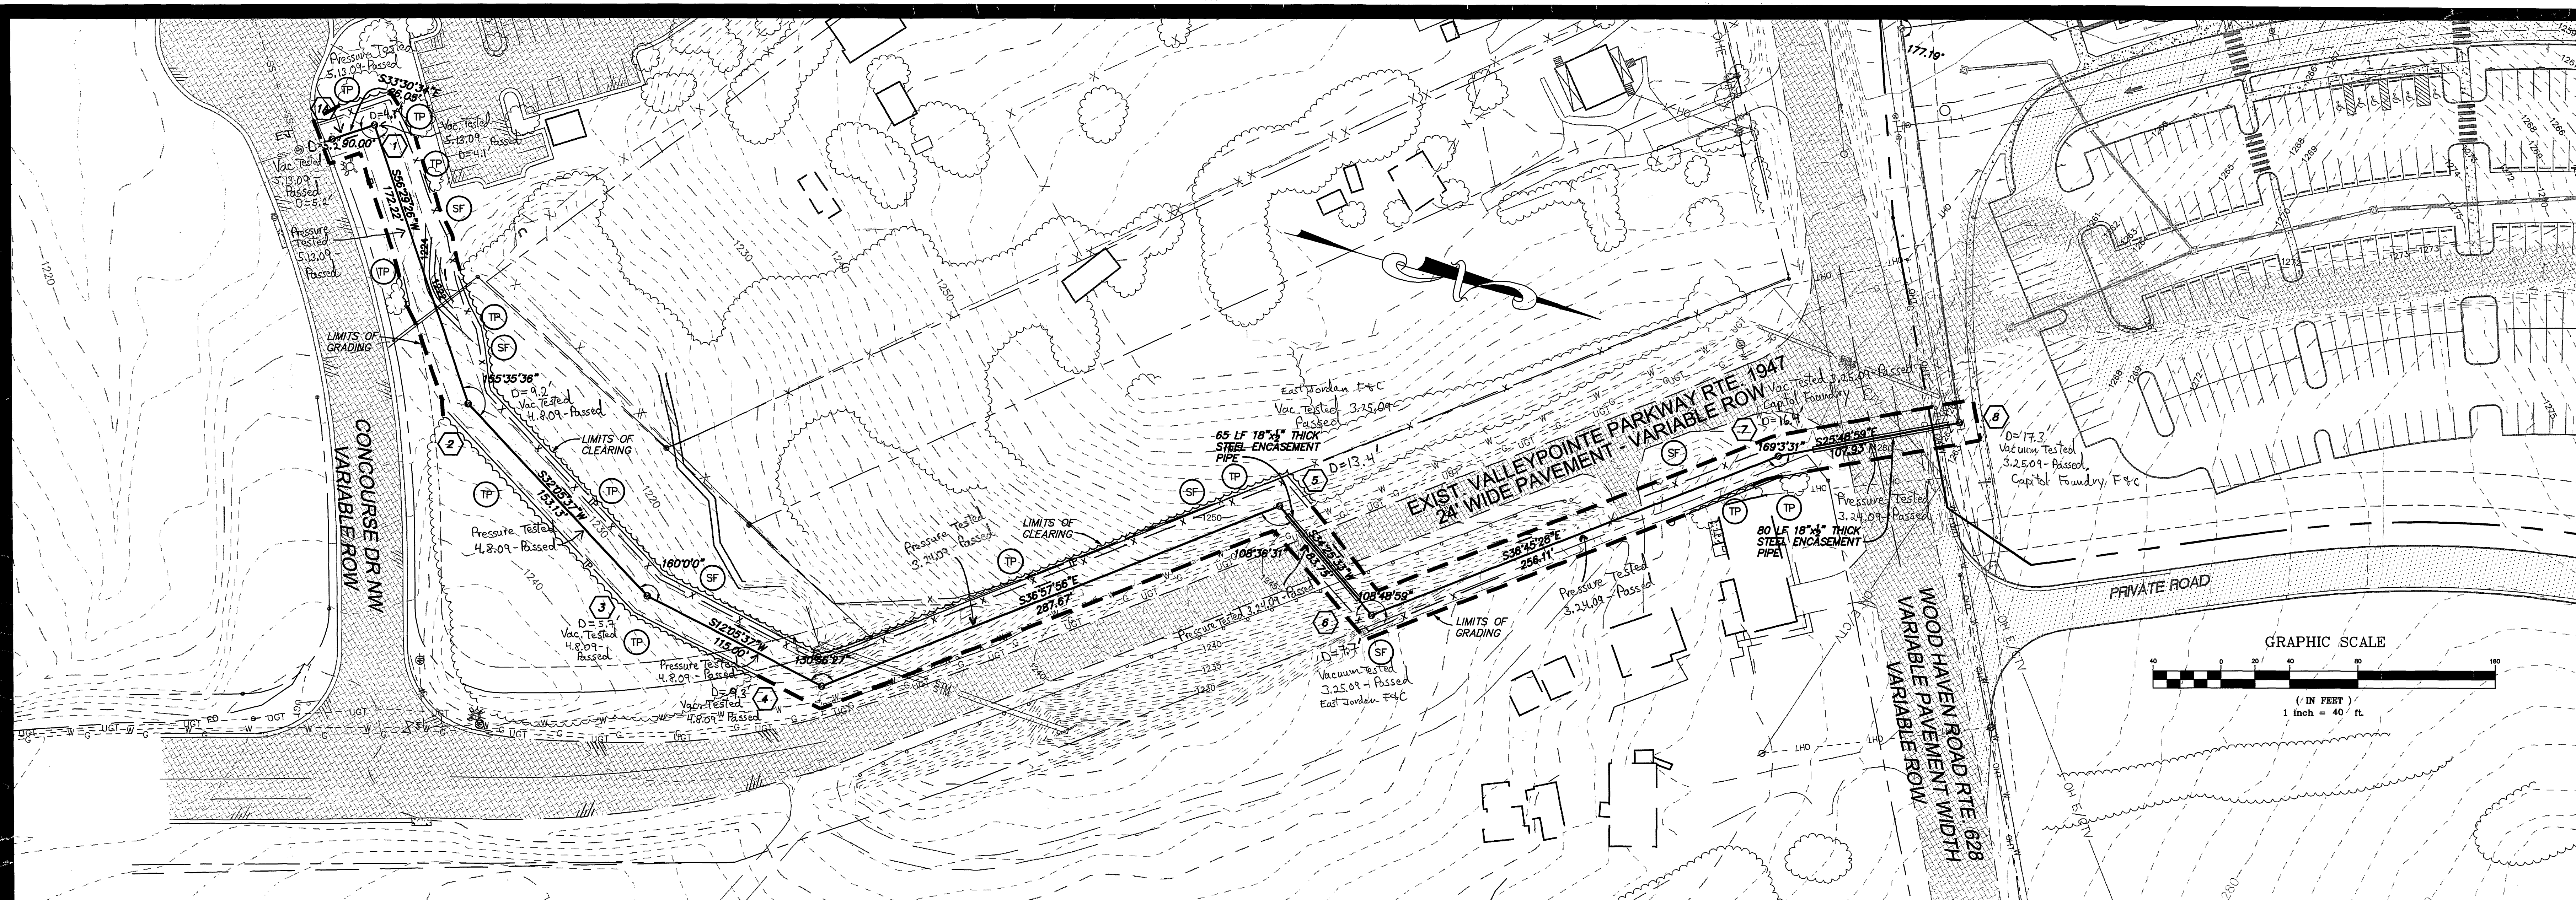
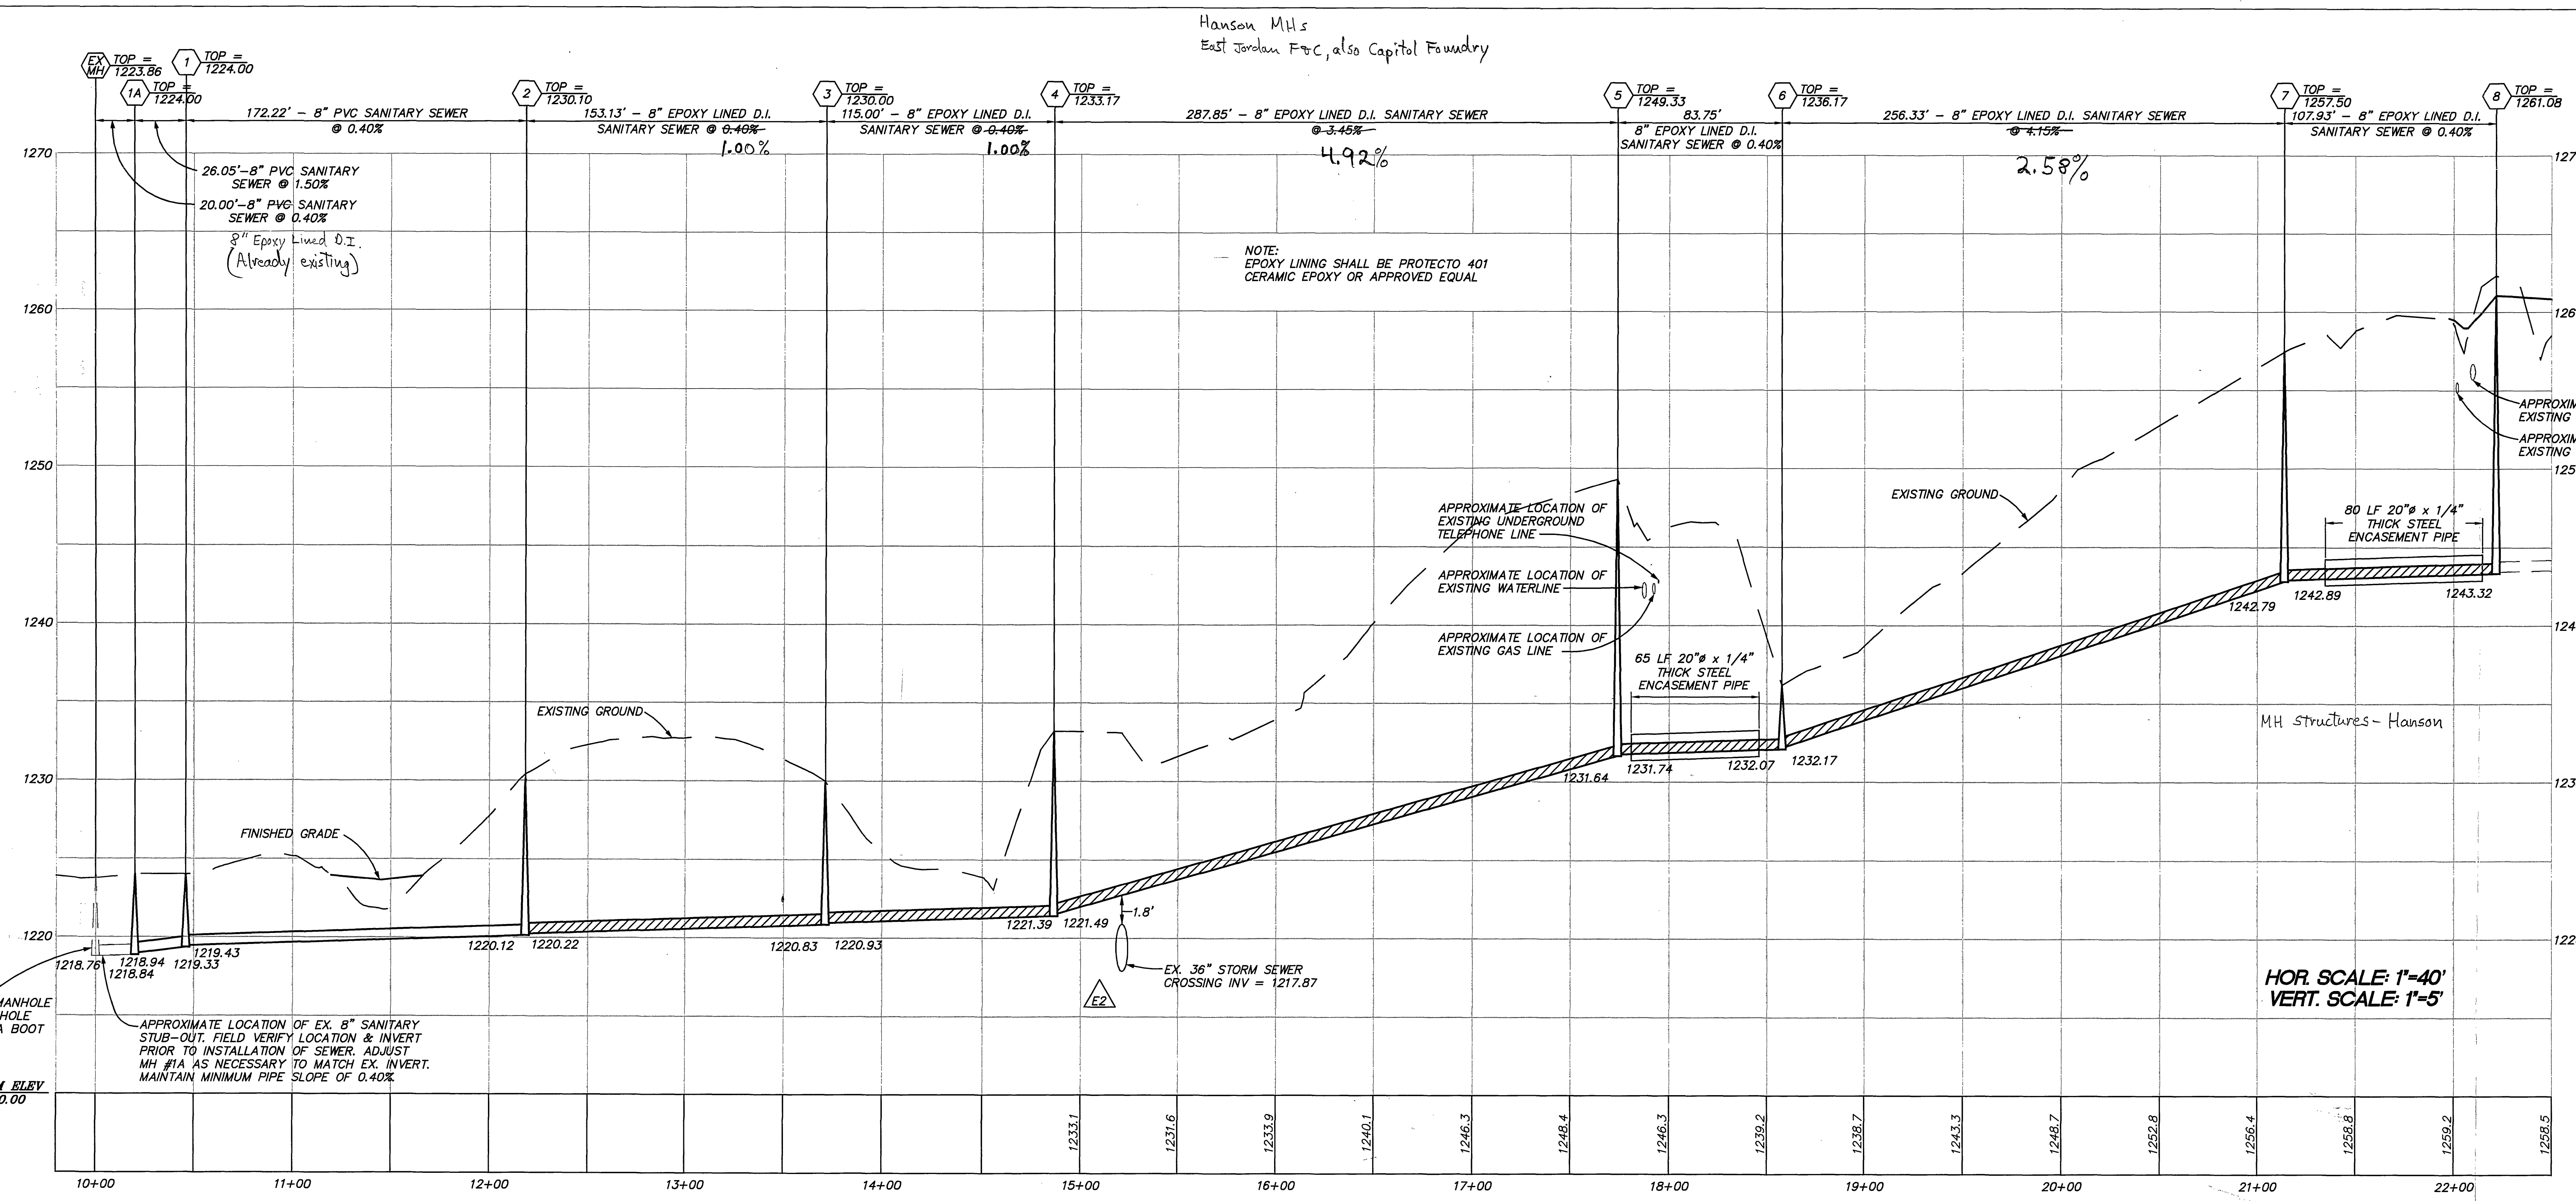


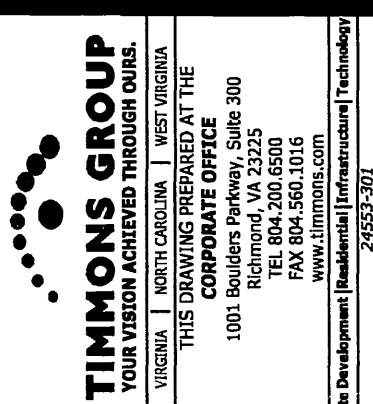

MOSELEYARCHITECTS
A PROFESSIONAL CORPORATION

FIRSTCHOICE
Public-PrivatePartners

401 SOUTHLAKE BOULEVARD, RICHMOND, VIRGINIA, 23256
PHONE (800) 794-7666 FAX (800) 979-6660
MOSELEYARCHITECTS.COM

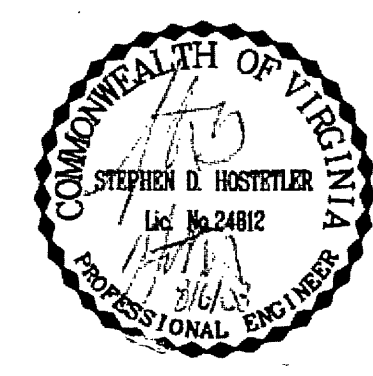

APPROVED

**VALLEYPOINTE PARKWAY
SANITARY SEWER EXTENSION**
HOLLINS MAGISTERIAL DISTRICT
ROANOKE COUNTY, VIRGINIA

PROJECT NO: 461920
DATE: JUNE 30, 2008
REVISIONS: SEPTEMBER 15, 2008
DRAWN BY: MJP
CHECKED BY: SPS

**SANITARY SEWER
PLAN AND
PROFILE**

C3.0

As-Built 12.16.09 K. Winslow