



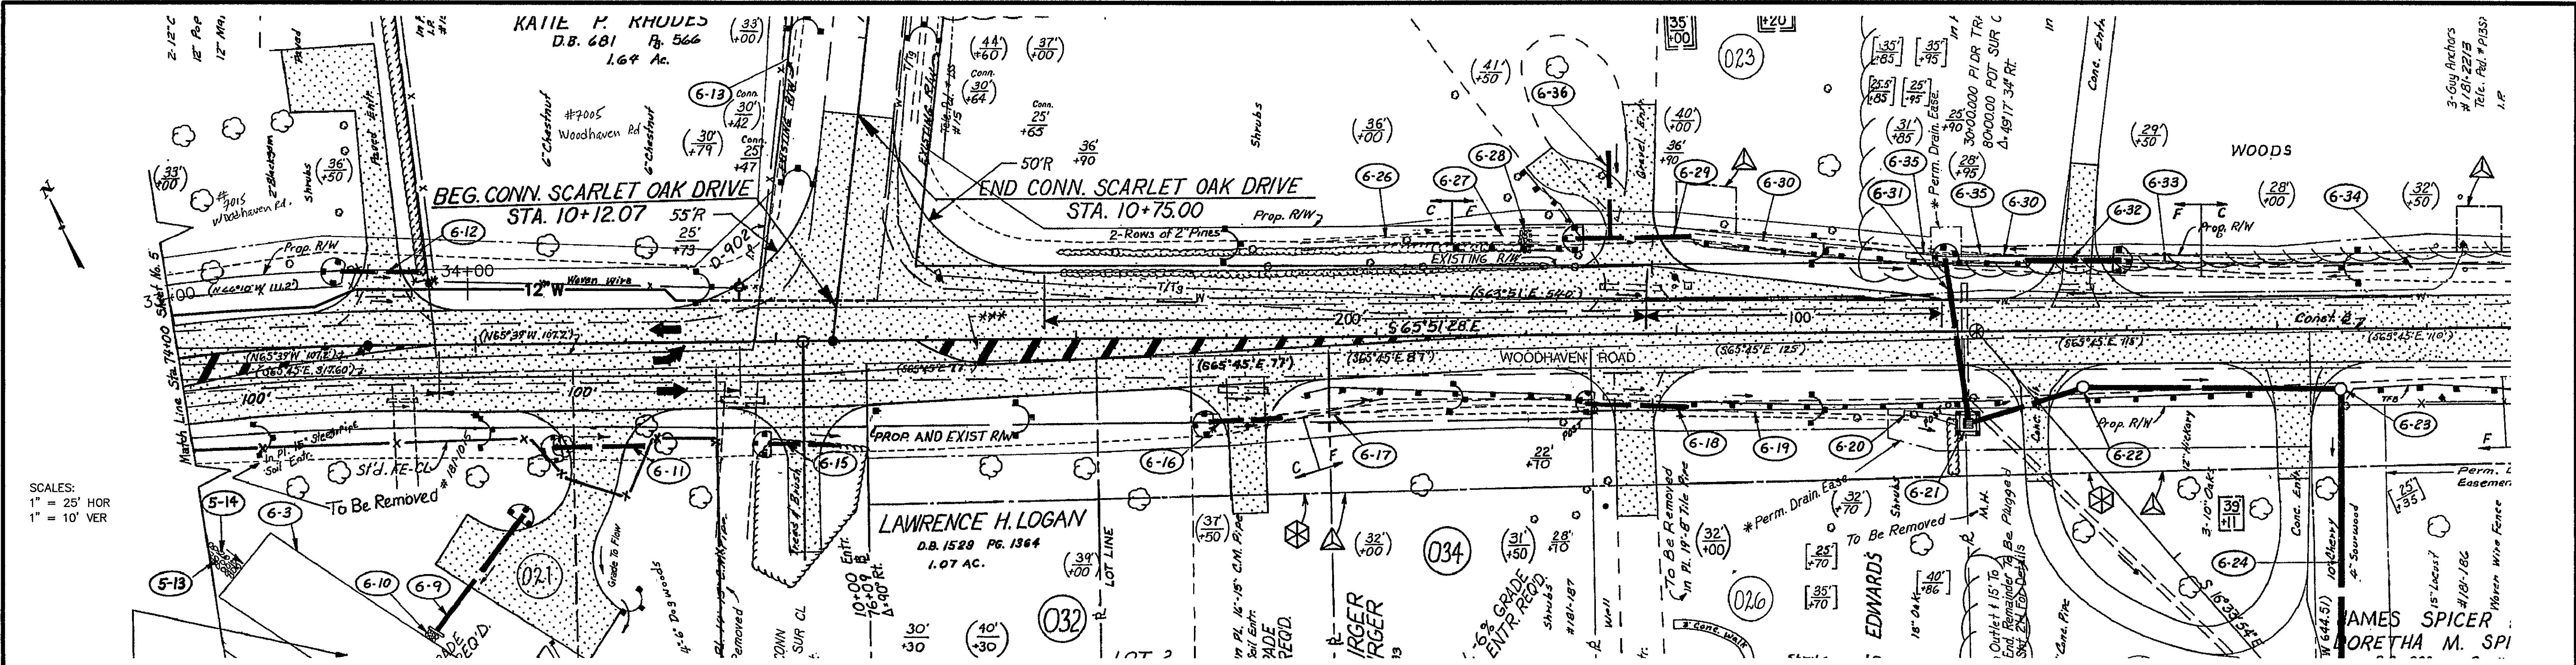

SCALES:
1" = 25' HOR
1" = 10' VER

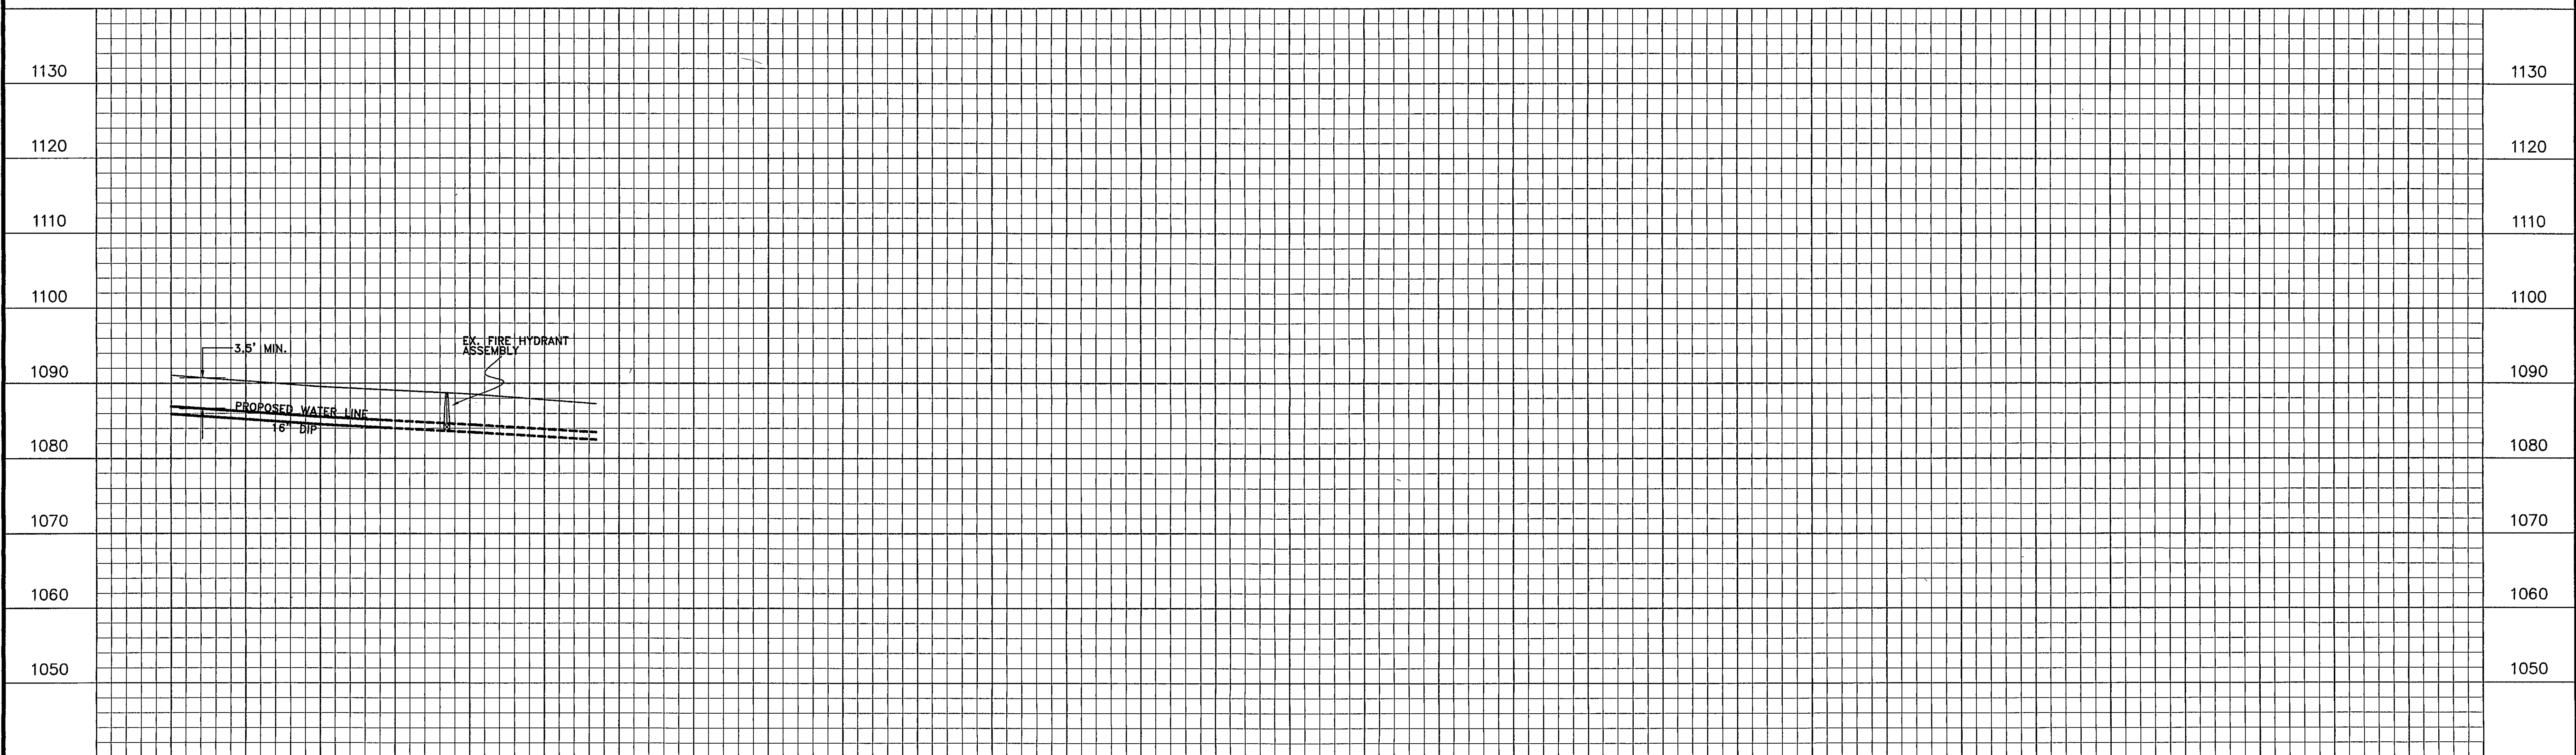

33+00 34+00 35+00 36+00 78+00 79+00

CONSTRUCTION PLANS
(PROJECT WAS INSTALLED) 1999

PLAN & PROFILE SHEET FOR
WOODHAVEN DRIVE WATERLINE EXTENSION



CATAWBA MAGISTERIAL DISTRICT
ROANOKE COUNTY, VIRGINIA
**ROANOKE COUNTY
UTILITY DEPARTMENT**

WWWVIA ID# 6LNNHK

SHEET 4 of 4

REVISION	DATE	DESCRIPTION
CHECKED BY:	DESIGNED BY: JAK	DRAWN BY: JAK
DATE: 6-16-99		