


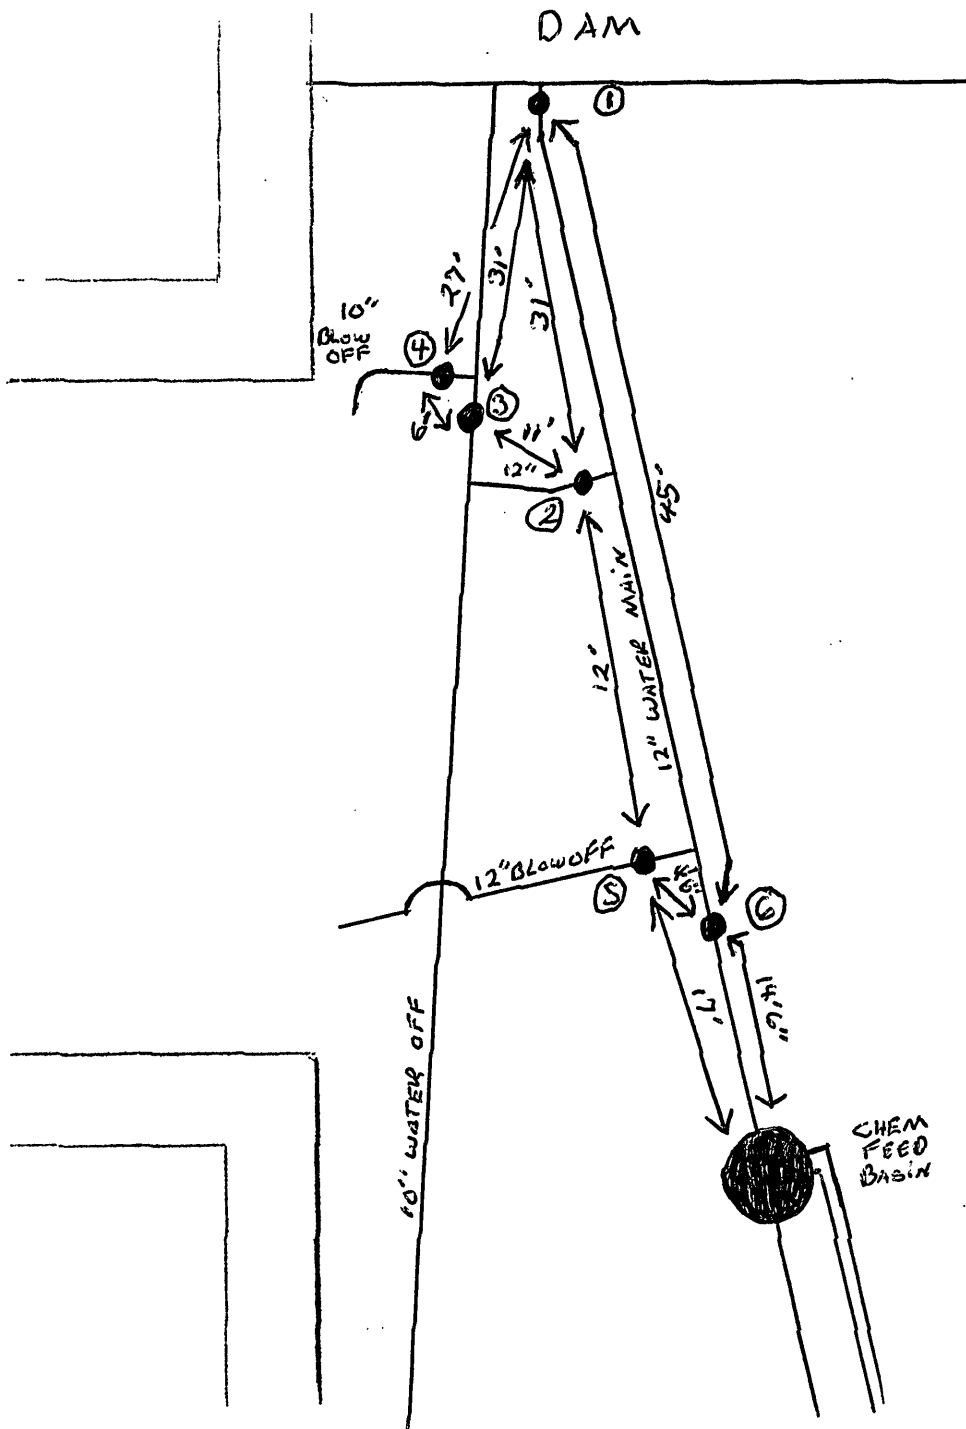

DATE	NO.	SIZE	MAKE	OPEN	TURNS
7-91	1	12"	MULL	R	39
7-91	2	12"	MULL	R	39
7-91	3	10"	KENNY	R	33
7-91	4	18'	MULL	R	33
7-91	5	12"	DARLING	R	39
7-91	6	12"	MULL	R	39

P. L. Measurements		
No.	Distance	Direction

CITY OF ROANOKE - WATER DEPT.	
VALVE DIAGRAM	
FALLING CREEK DAM	
Sec. Map	
Date 7-25-91 Page No.	