


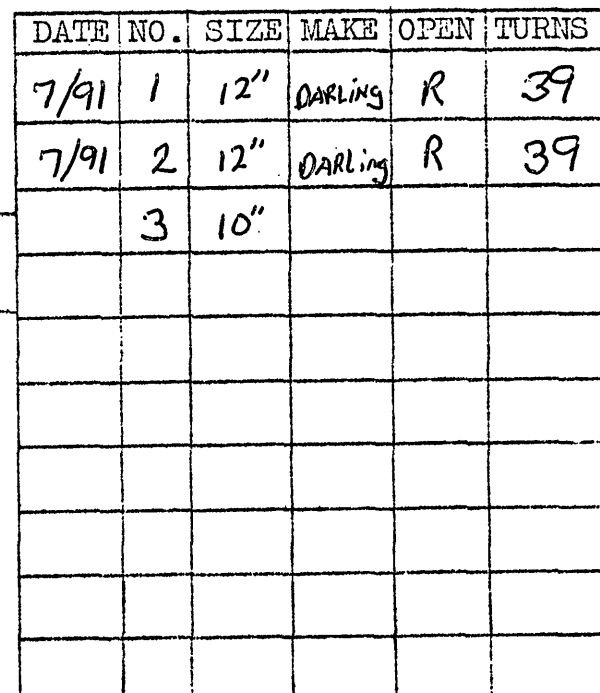

CITY OF ROANOKE - WATER DEPT.
VALVE DIAGRAM
FALLING CREEK FILTER
PLANT
Sec. Map
Date 7-24-91 Page No.