


VALVE # 31


INTERSECTION OF BACK ST. & HANCOCK ST.

HANCOCK ST.

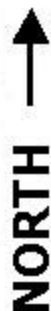

BACK ST.

31

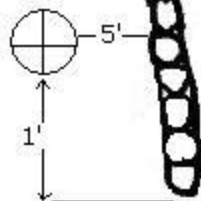

Rock Wall