
VALVE # 51

SECOND VALVE FROM WATER TANK LOCATED ALONGSIDE RTE. 606 13' FROM CULVERT AND 10' FROM ROCK

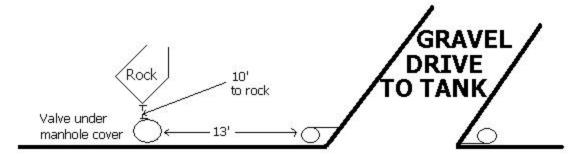

RTE. 606

West ——→