


VALVE # 53

MAIN VALVE @ SOUTH SIDE OF RTE. 630
WEST SIDE OF TOWN BRANCH

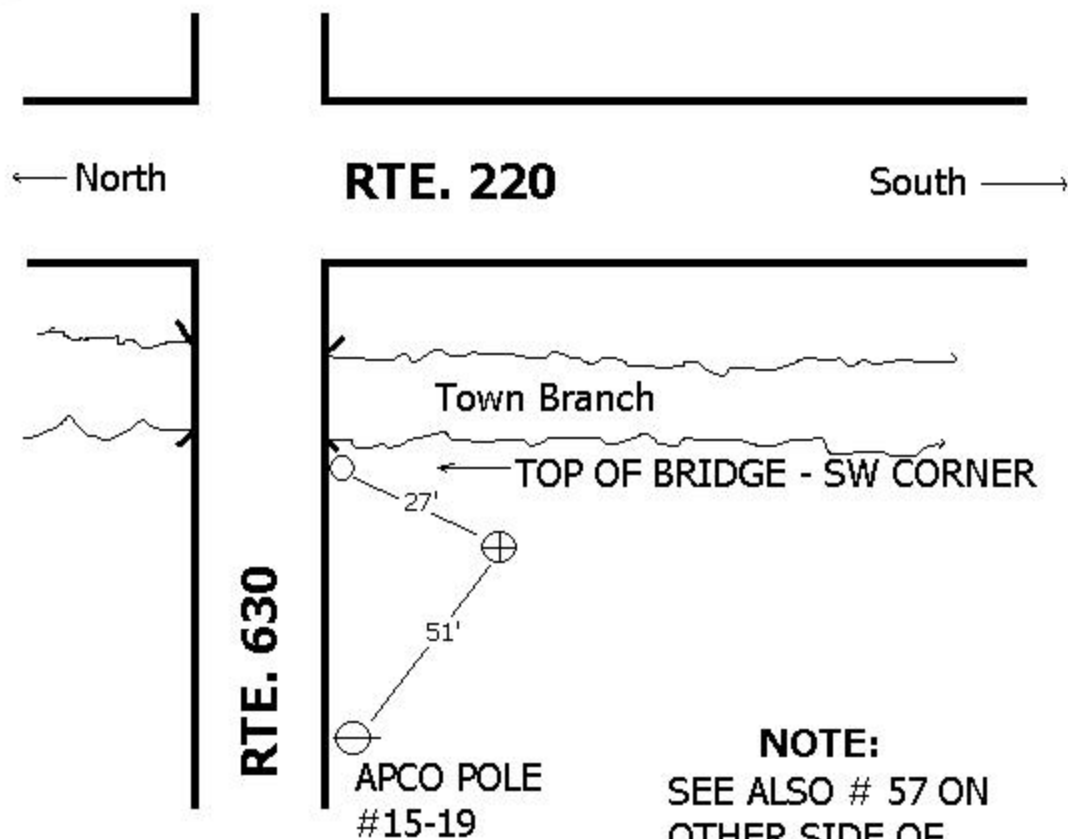

NOTE:

SEE ALSO # 57 ON
OTHER SIDE OF
TOWN BRANCH