


VALVES # 55 & 56

MAIN VALVES TO BRECKINRIDGE SCHOOL



RTE. 630

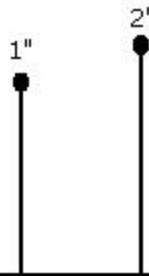

1" Valve
32.6' from F.H.
3.3' from E.P.

2" Valve
24.7' from F.H.
2.0" from E.P.

