
VALVE # 13 INTERSECTION BACK ST. & CHURCH ST.



BACK ST.

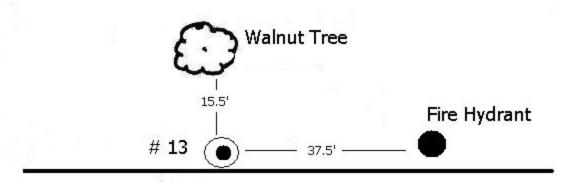