


VALVES # 14 & 15

INTERSECTION MAIN ST. & CHURCH ST.



MAIN ST.

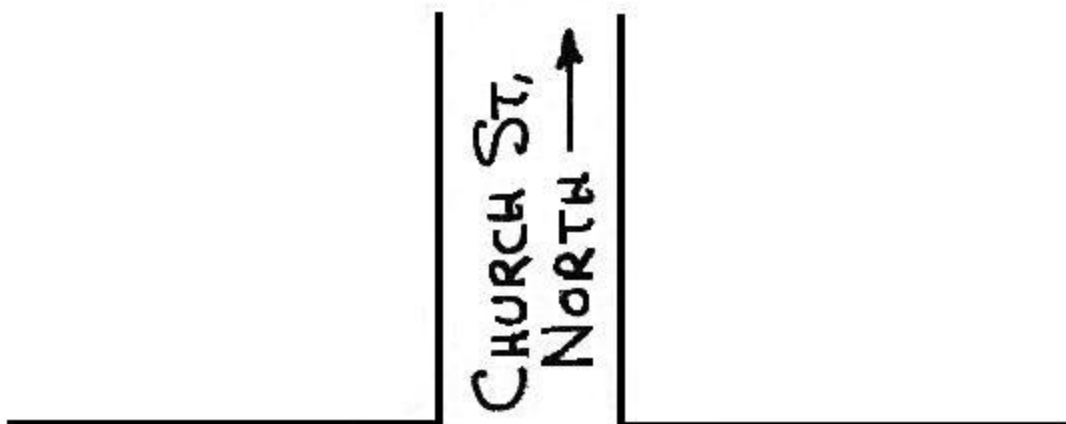