


VALVES # 16 & 17

INTERSECTION CHURCH ST. & MURRY ST.



MURRY ST.

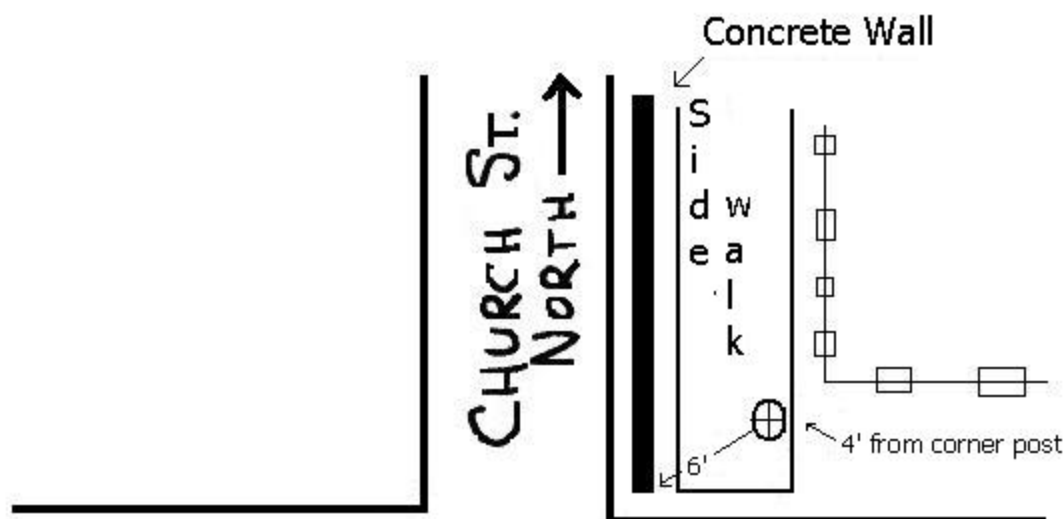