


VALVES # 23 & 24

INTERSECTION BACK ST. & MONROE ST.



BACK ST.

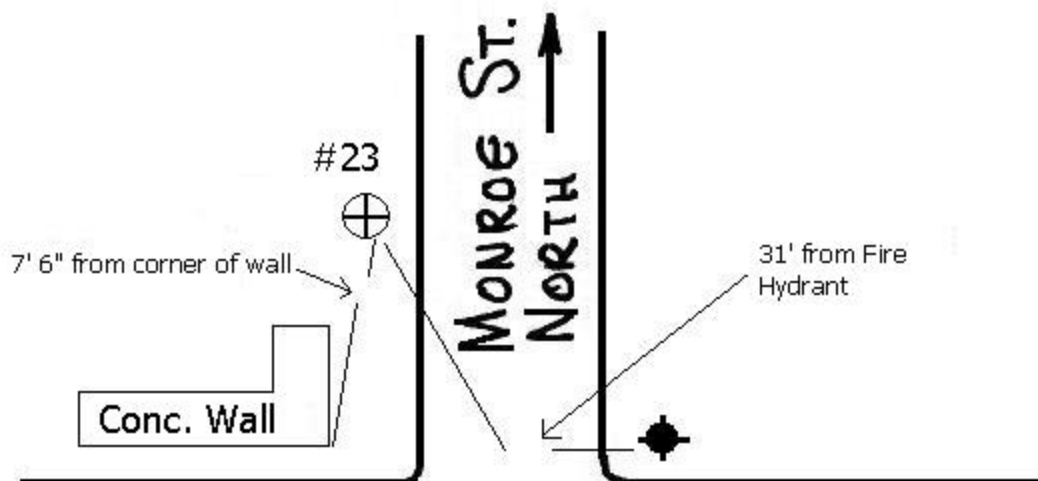