


#229

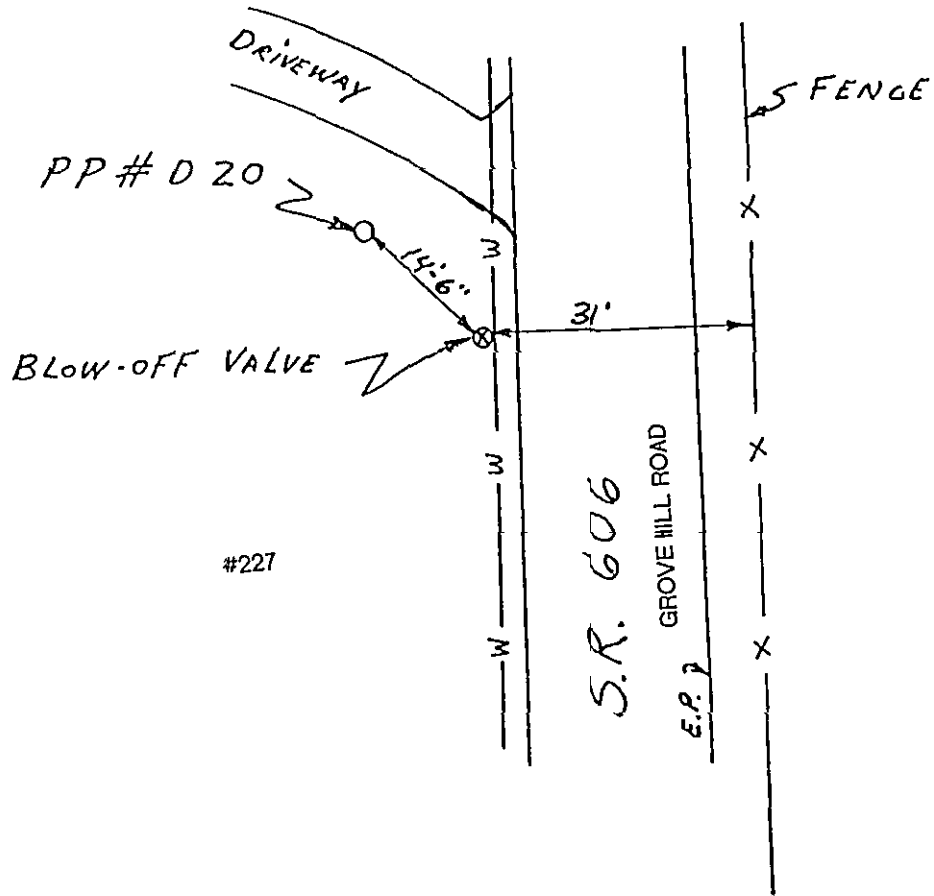

NOTE: BLOW-OFF VALVE
LOCATED ON CREST OF HILL.