


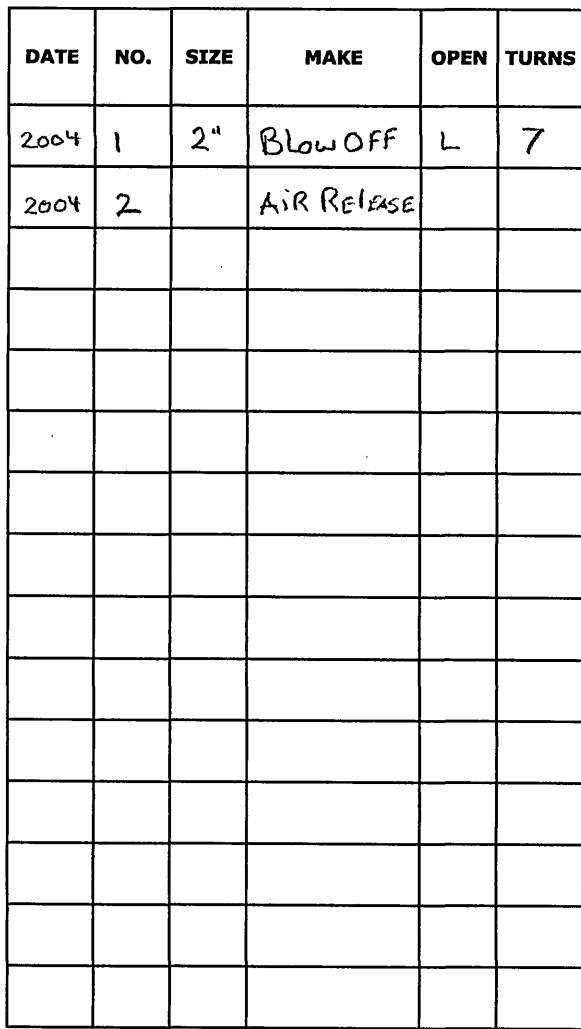

WESTERN VIRGINIA WATER AUTHORITY
VALVE DIAGRAM
2814 CHATEAU COURT
West End
SECT. MAP County
DATE 8-18-04