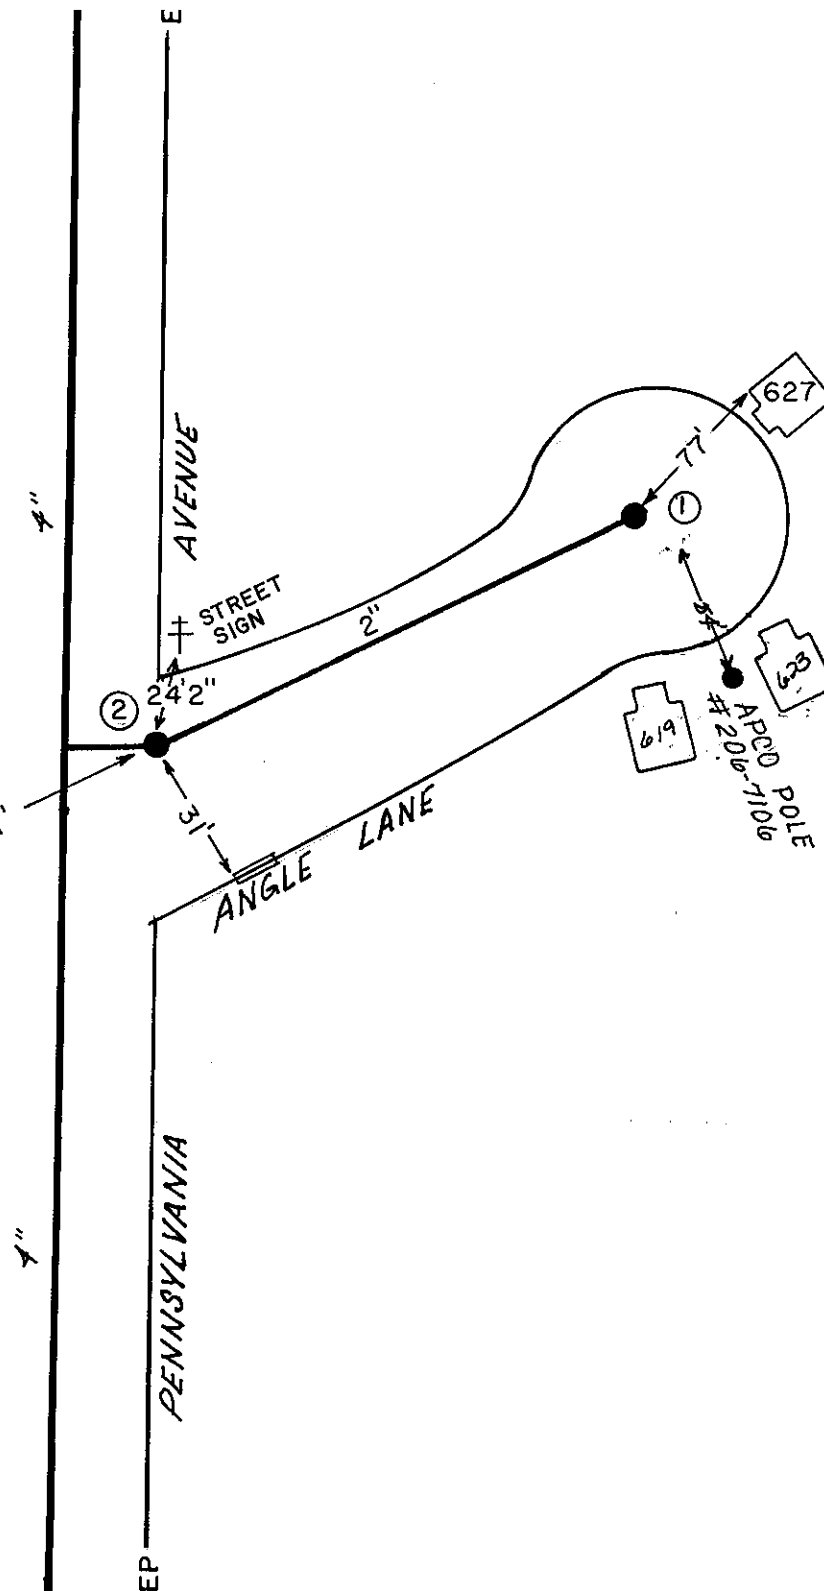


[illegible]

CITY OF ROANOKE—WATER DEPT
VALVE DIAGRAM

ANGLE LANE AND
PENNSYLVANIA AVE.

SEC. MAP 739

N.E.

DATE JULY 11, 1980 PAGE NO. _____