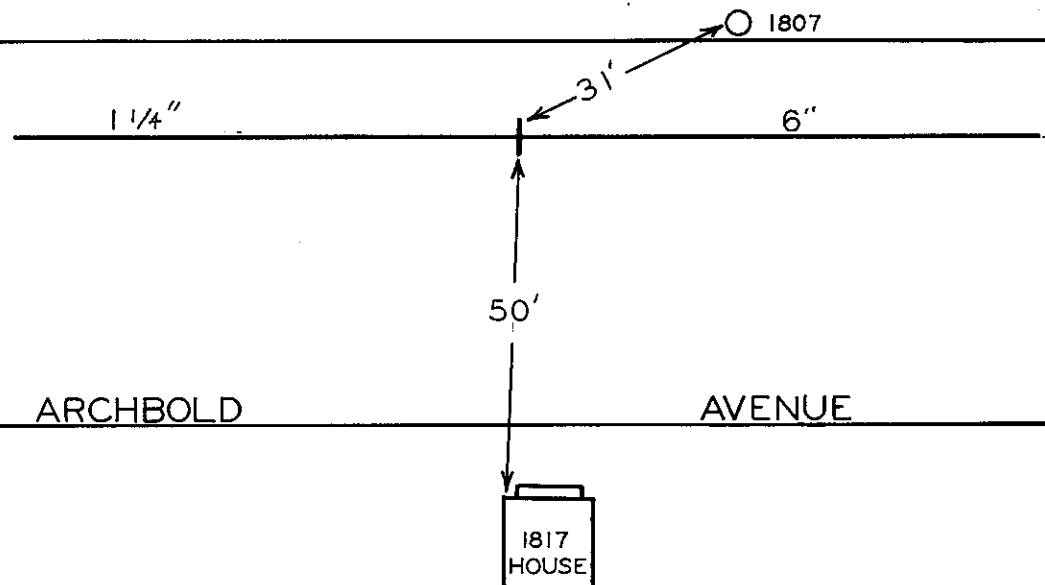


[illegible]

CITY OF ROANOKE—WATER DEPT.
VALVE DIAGRAM

ARCHBOLD AVE.

IN FRONT OF 1817.

SEC. MAP 322

N.E.

DATE

PAGE NO.

9/2000 JH