


SPECIAL TRACING CLOTH
K & E CO., N.Y.

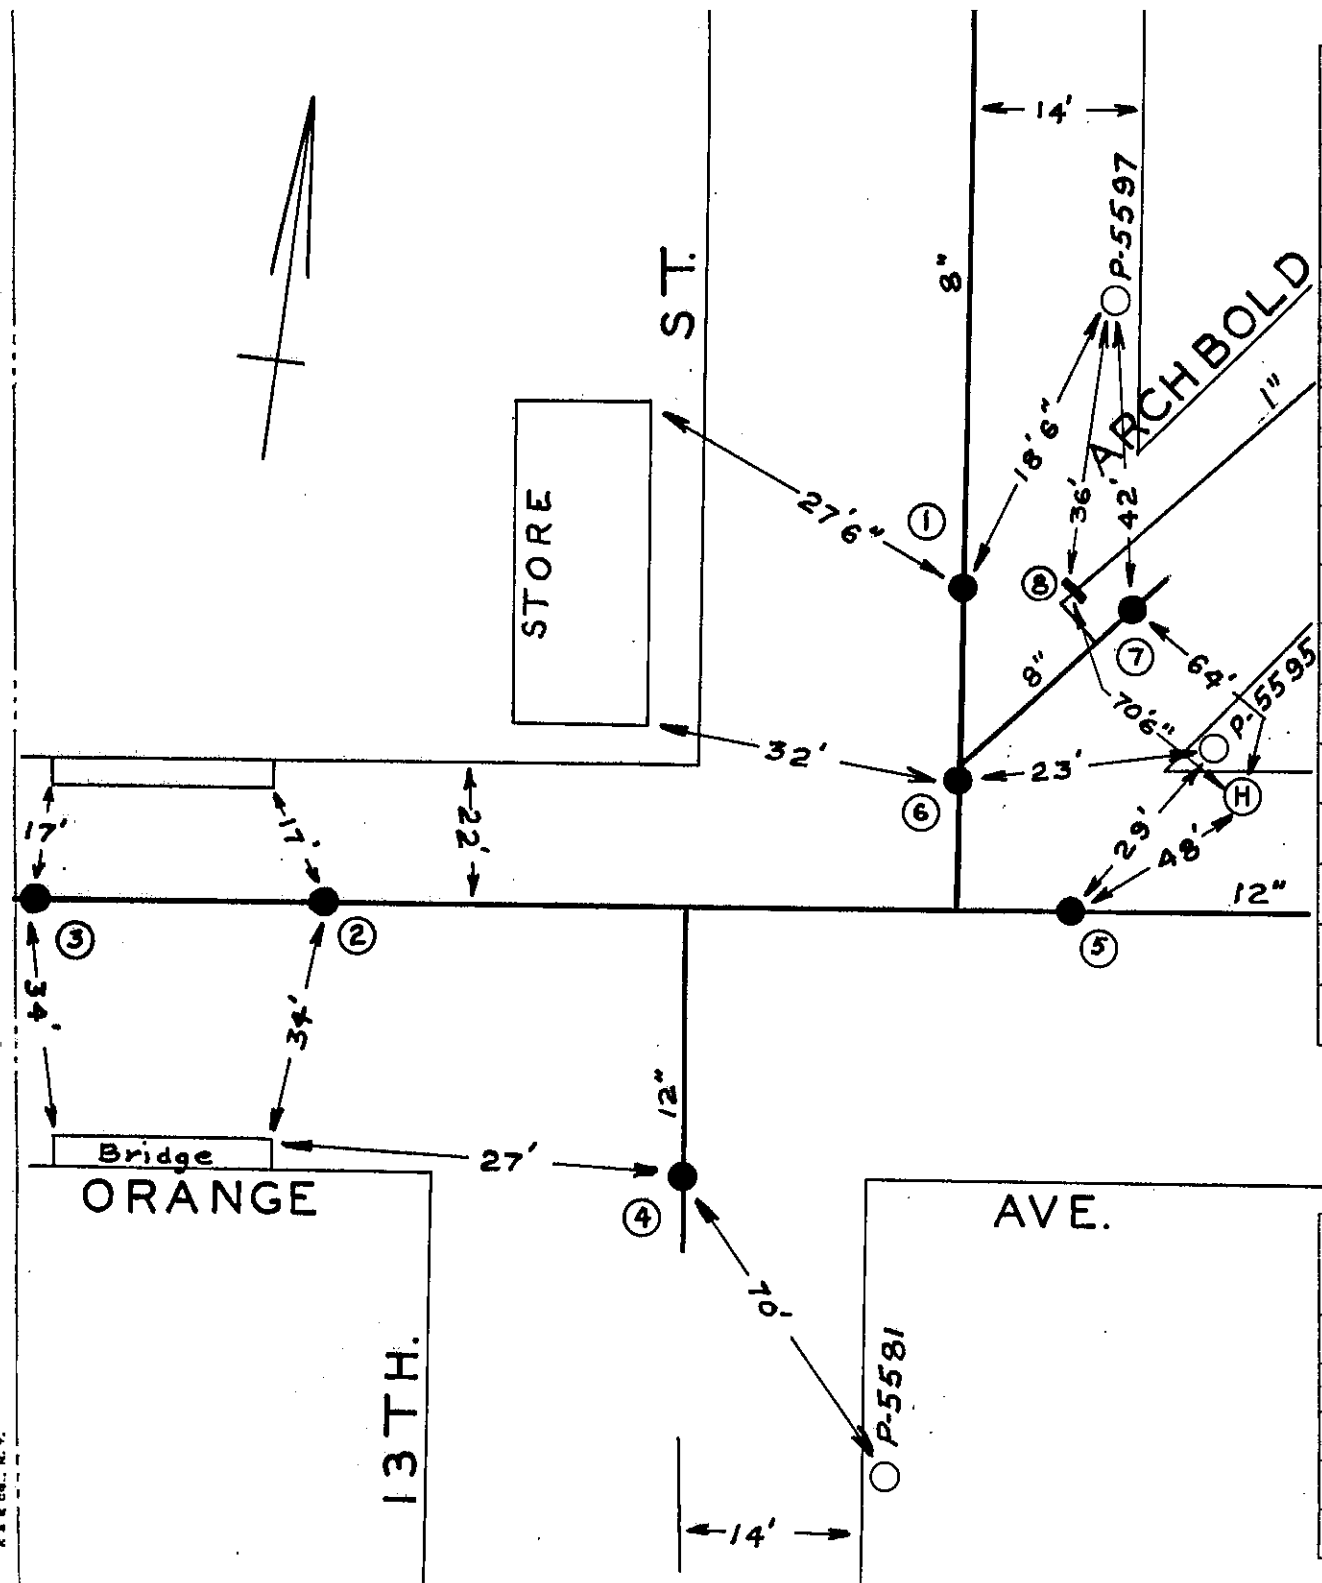

DATE	NO.	SIZE	MAKE	OPEN	TURNS
	1	8"	MUELLER	R	27½
4-68	2	12"	MUELLER	R	38
4-69	3	12"	MUELLER	R	38
4-69	4	12"	MUELLER	R	38
	5	12"	MUELLER	R	38
	6	8"	MUELLER	R	27½
	7	8"	MUELLER	R	27½
	8	1"	CURB COCK		
	1	0	NPL		
	2	60'-W	WPL		
	3	180'-W	WPL		
	4	0	SPL		
	5	0	EPL		
	6	0	NPL		
	7	0	EPL		
	8	5'-W	EPL		

CITY OF ROANOKE—WATER DEPT.	
VALVE DIAGRAM	
ARCHBOLD AVE - ORANGE	
AVE. & 13TH ST. N. E.	
SEC. MAP 322	
DATE	PAGE NO.