


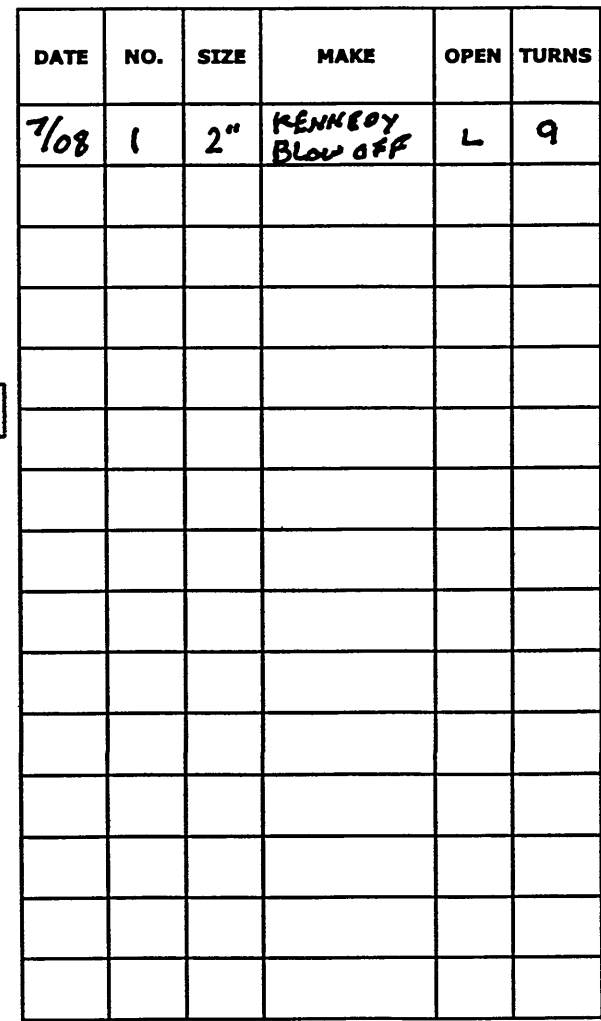

WESTERN VIRGINIA WATER AUTHORITY
VALVE DIAGRAM
AUSTIN AVE CUL-DE-SAC
SECT. MAP N.E.
DATE 8-1-08