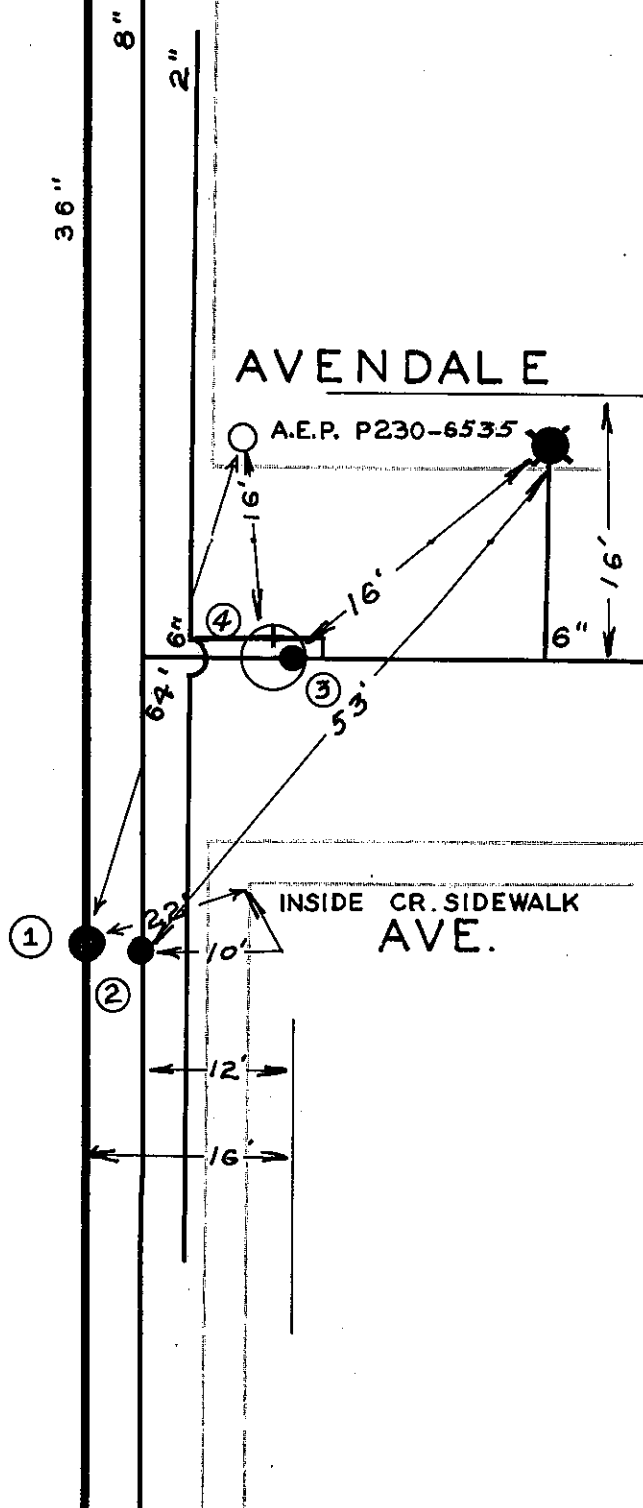


WILLIAMSON RD.

9/2000 JH

[illegible]

CITY OF ROANOKE - WATER DEPT
VALVE DIAGRAM
AVENDALE AVE. &
WILLIAMSON RD.

SEC. MAP 309

N.E.

DATE

PAGE 40. N.E.116