


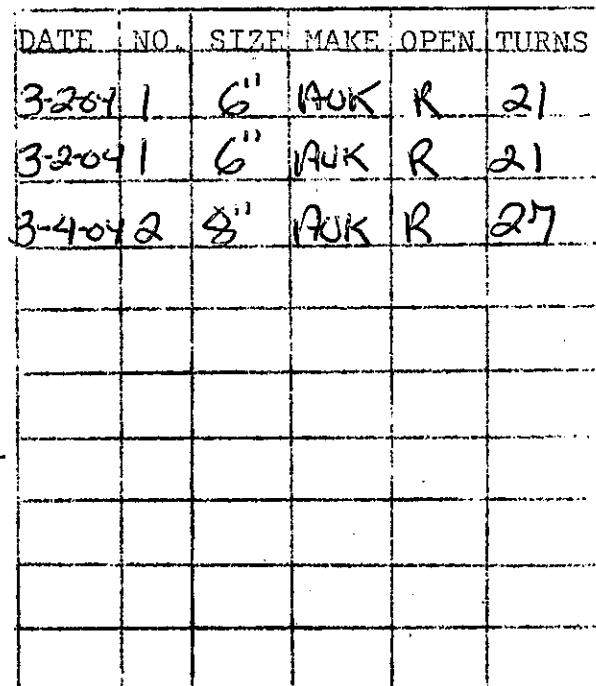

CITY OF ROANOKE - WATER DEPT.
VALVE DIAGRAM
Light St. & Baldwin Ave.
Baldwin Ave. & Light St. NE
Sec. Map
Date 3-2-04 Page No.