


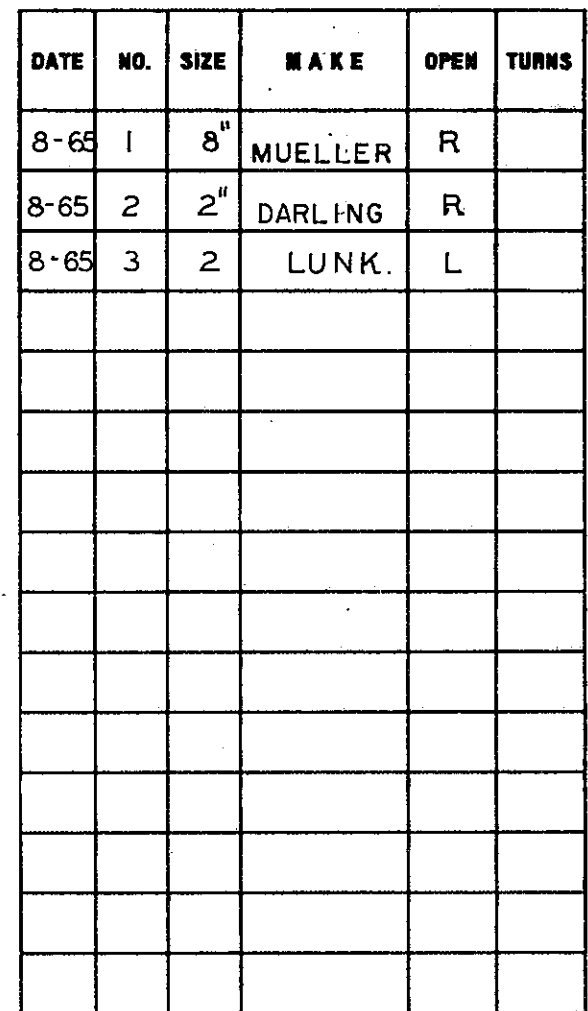

9/2000 JH