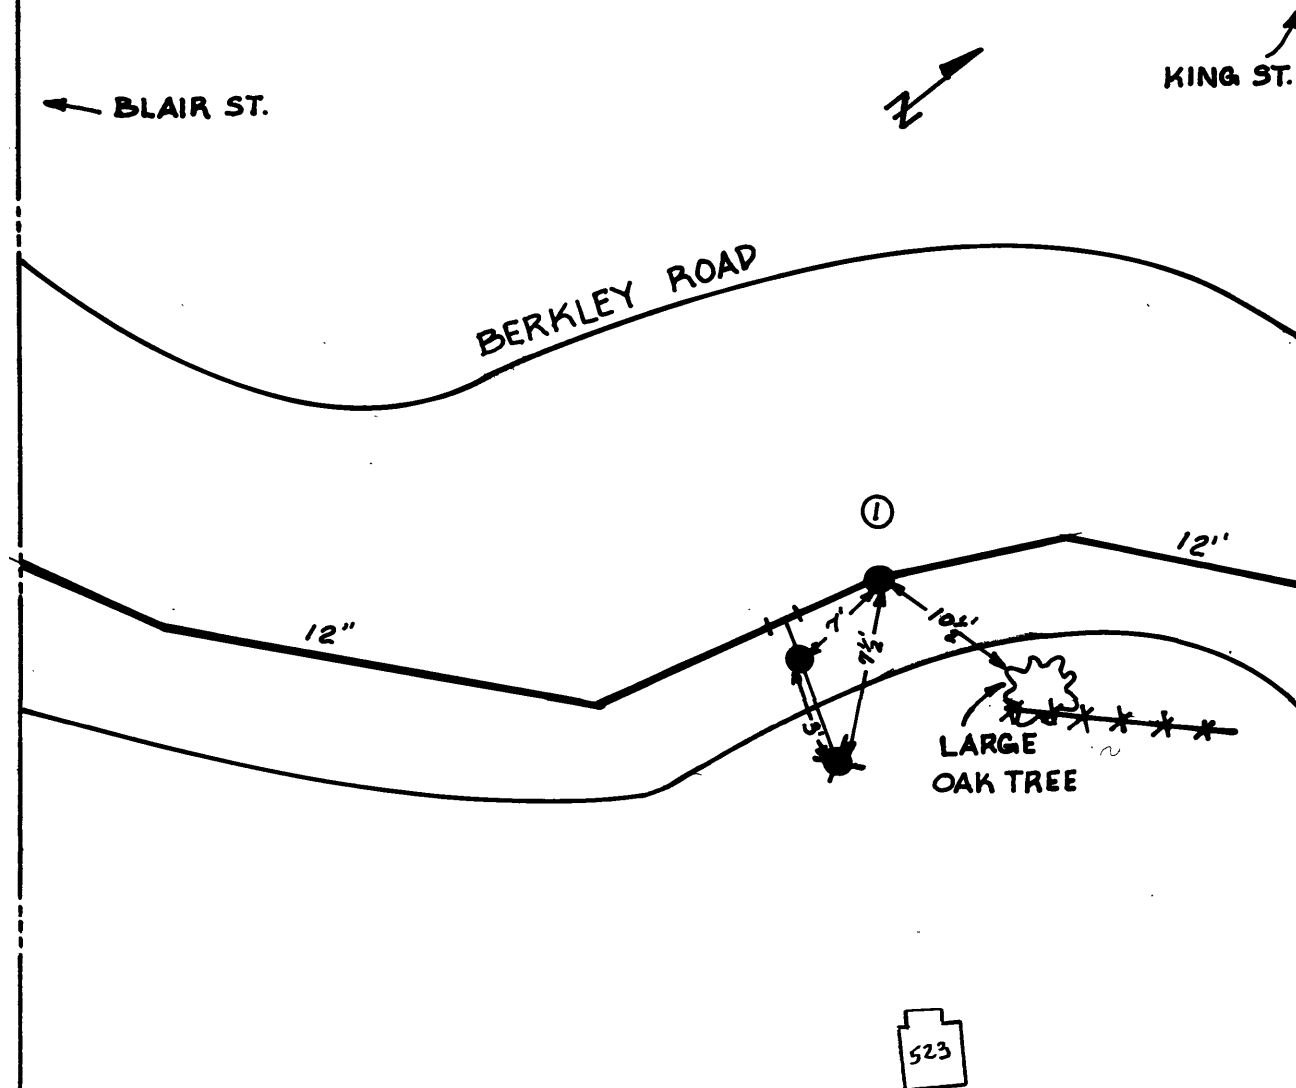


[illegible]

CITY OF ROANOKE—WATER DEPT
VALVE DIAGRAM
BERKLEY ROAD - 523
North of Vineyard Park Drive N.E.
SEC. MAP 701
DATE NOV. 28, 1980 PAGE NO.