


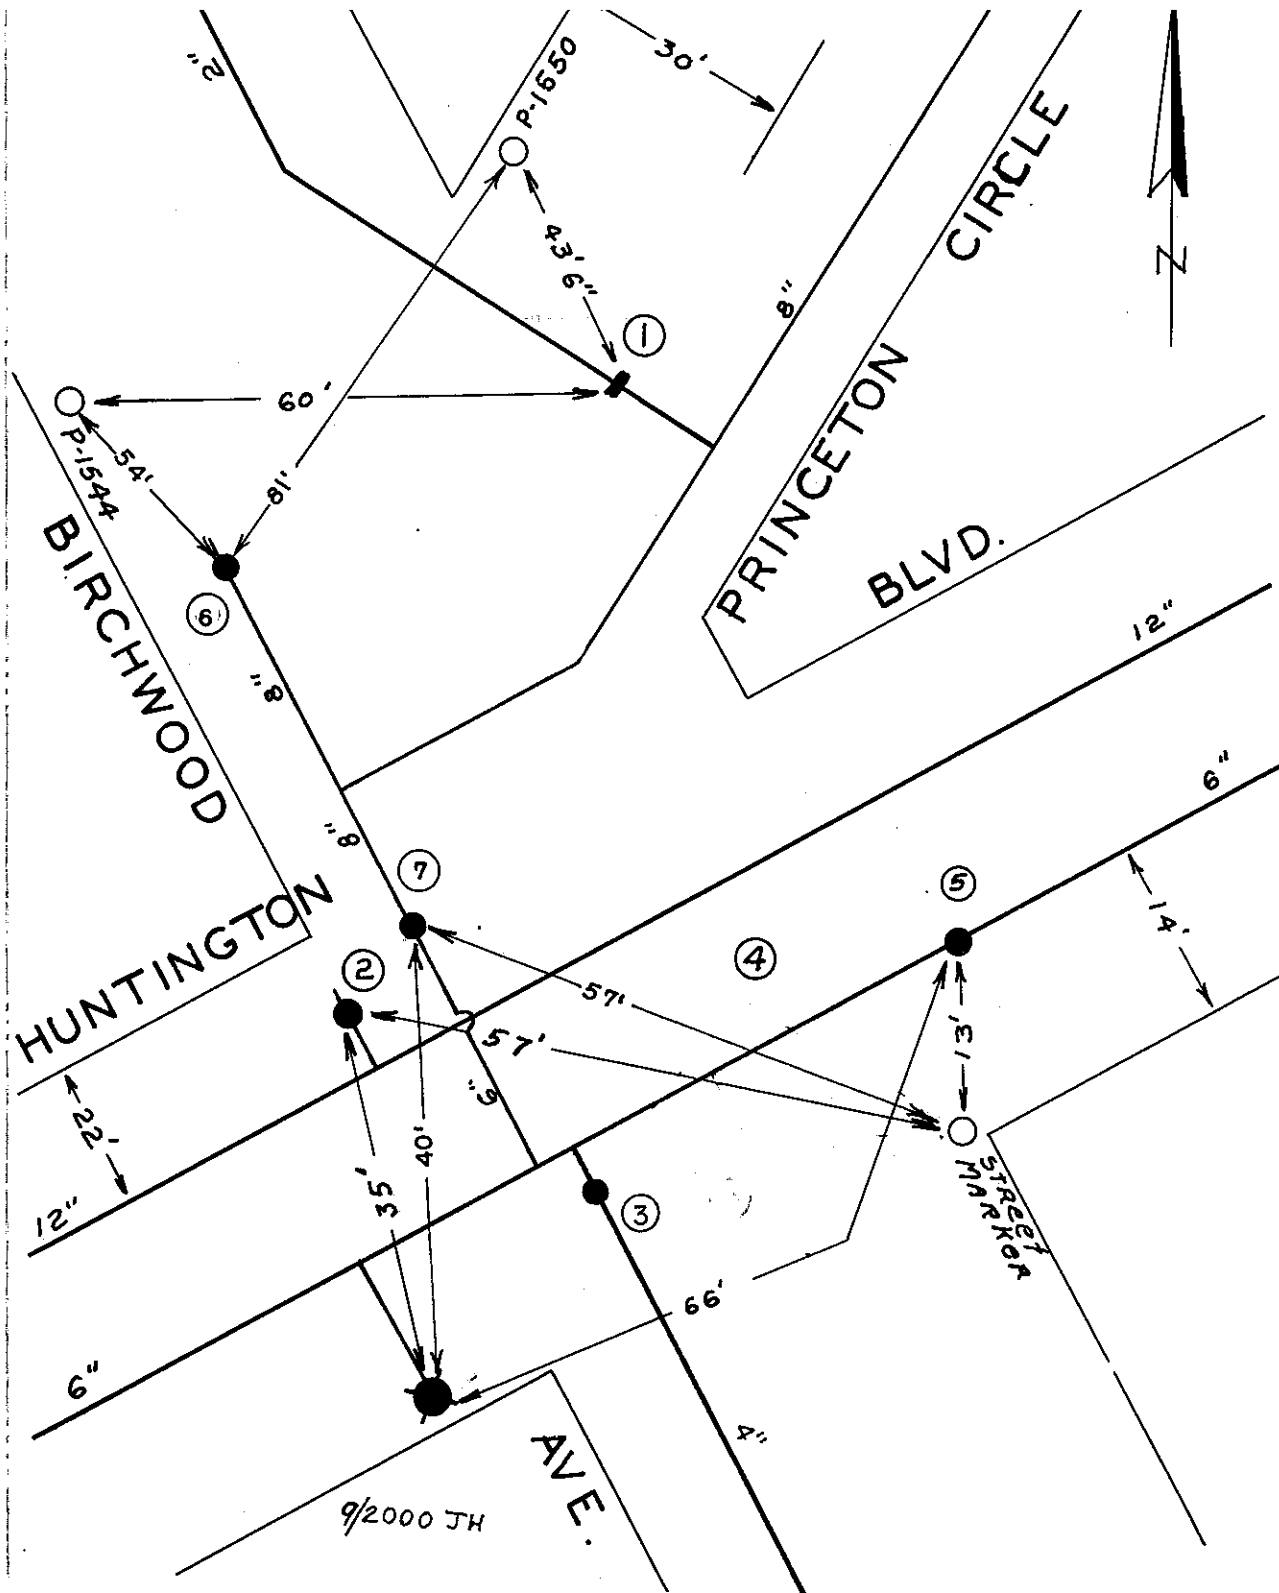

| DATE | NO. | SIZE | MAKE    | OPEN | TURNS |
|------|-----|------|---------|------|-------|
| 9-62 | 1   | 2"   | DARLING | R    | 7     |
| 1953 | 2   | 8"   |         |      |       |
| 1988 | 3   |      |         |      |       |
| 6-56 | 4   | 2"   |         |      |       |
| 56   | 5   | 6"   | MUELLER | R    |       |
| 7-62 | 6   | 8"   | DARLING | R    |       |
| 7-62 | 7   | 6"   | DARLING | R    |       |
|      | 1   | 13E  | E.P.L.  |      |       |
|      | 2   | 0    | W.P.L.  |      |       |
|      | 3   | 8'N  | SPL     |      |       |
|      | 4   | 39'S | NPL     |      |       |
|      | 5   | 3'E  | EPL     |      |       |
|      | 6   | 0    | NPL     |      |       |
|      | 7   | 7'S  | NPL     |      |       |

|                                   |          |
|-----------------------------------|----------|
| CITY OF ROANOKE - WATER DEPT.     |          |
| VALVE DIAGRAM                     |          |
| BIRCHWOOD AVE. & HUNTINGTON BLVD. |          |
| PRINCETON CIRCLE                  |          |
| SEC MAP 316, 317                  | N.E.     |
| DATE                              | PAGE NO. |