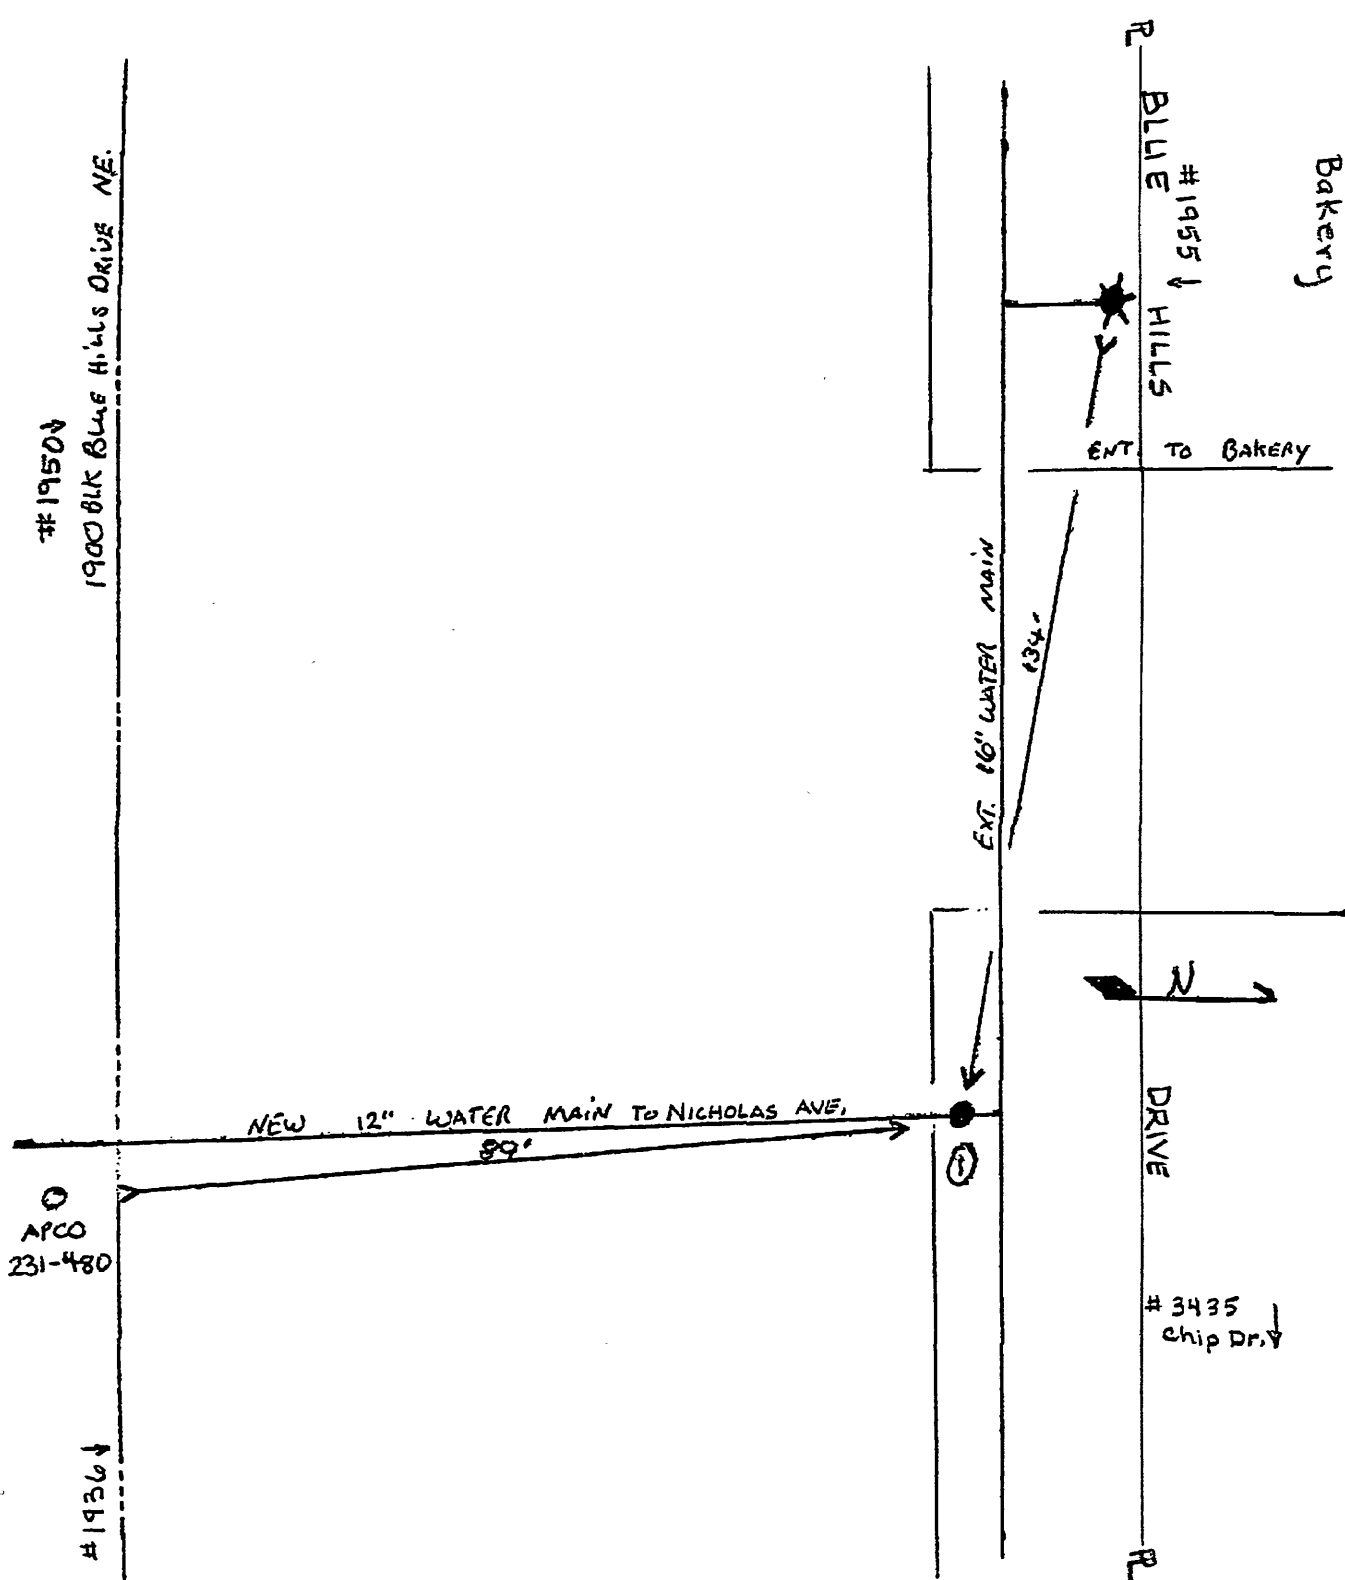


#1936 ↓

APCO
231-480

[illegible]

CITY OF ROANOKE—WATER DEPT
VALVE DIAGRAM

BLUE HILLS DRIVE
(1900 BLOCK)

SEC. MAP 723

DATE 2-18-98

PAGE NO.