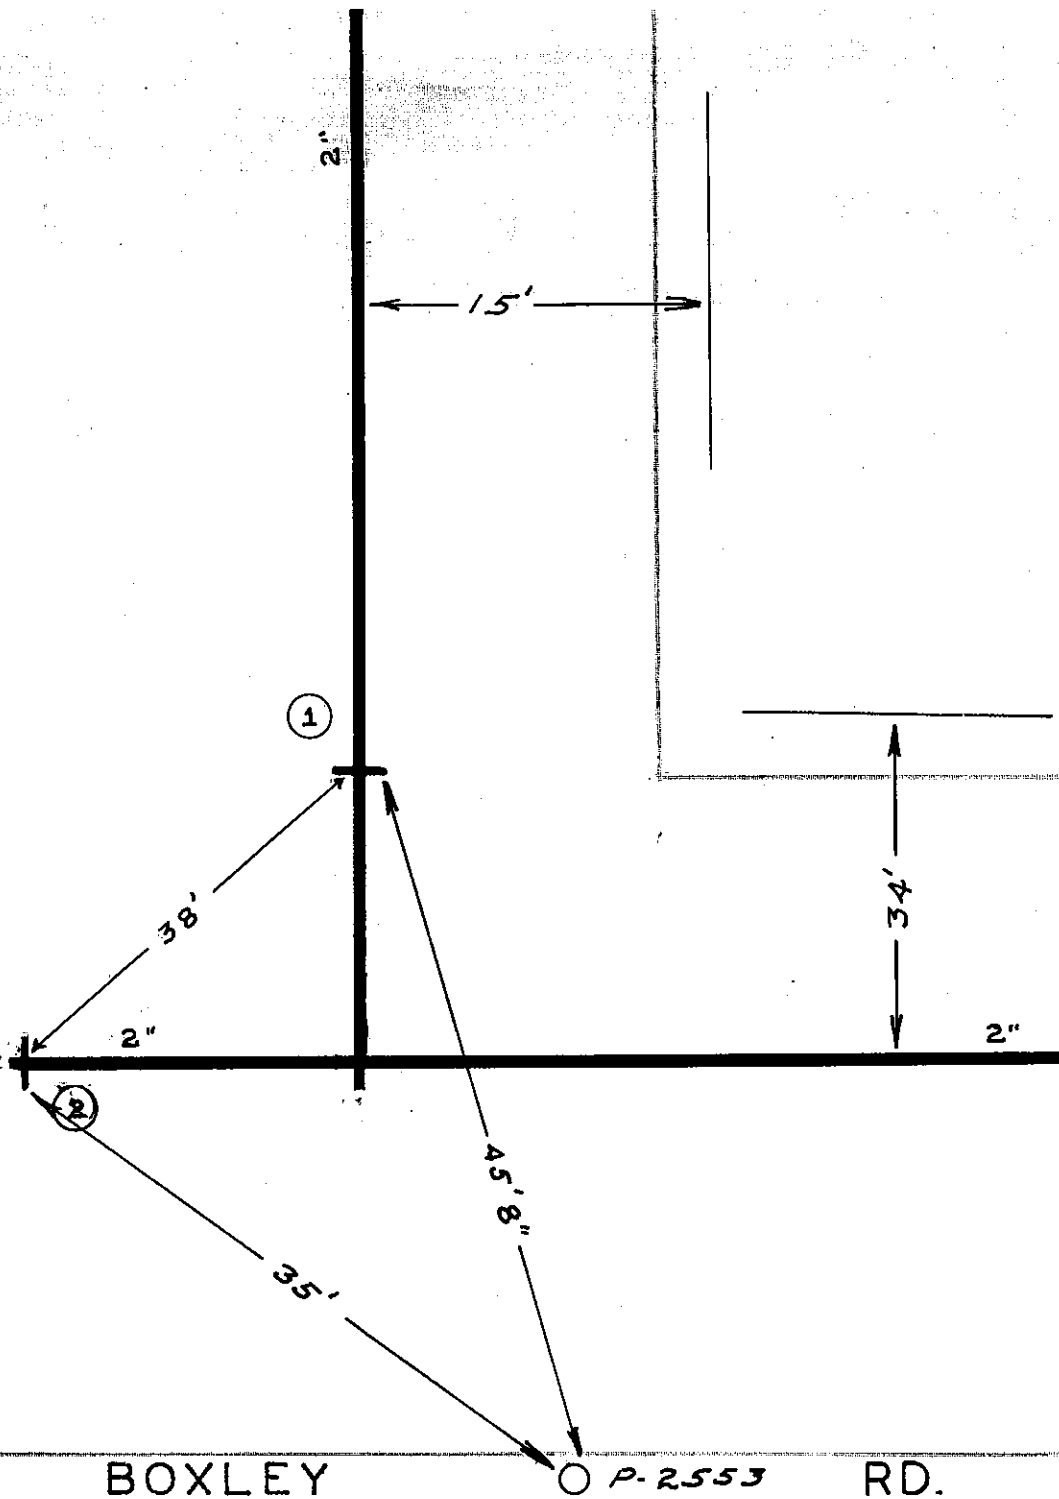


CHESTER^x

[illegible]

$\frac{d}{dt} \left(\frac{\partial L}{\partial \dot{x}} \right) = \frac{\partial L}{\partial x}$

[illegible]

**BOXLEY ROAD & CHESTER
DRIVE N.E.**

SEC. MAP 17 Roanoke County

GAIC 8/31/47 PAGE NO N.E.111